
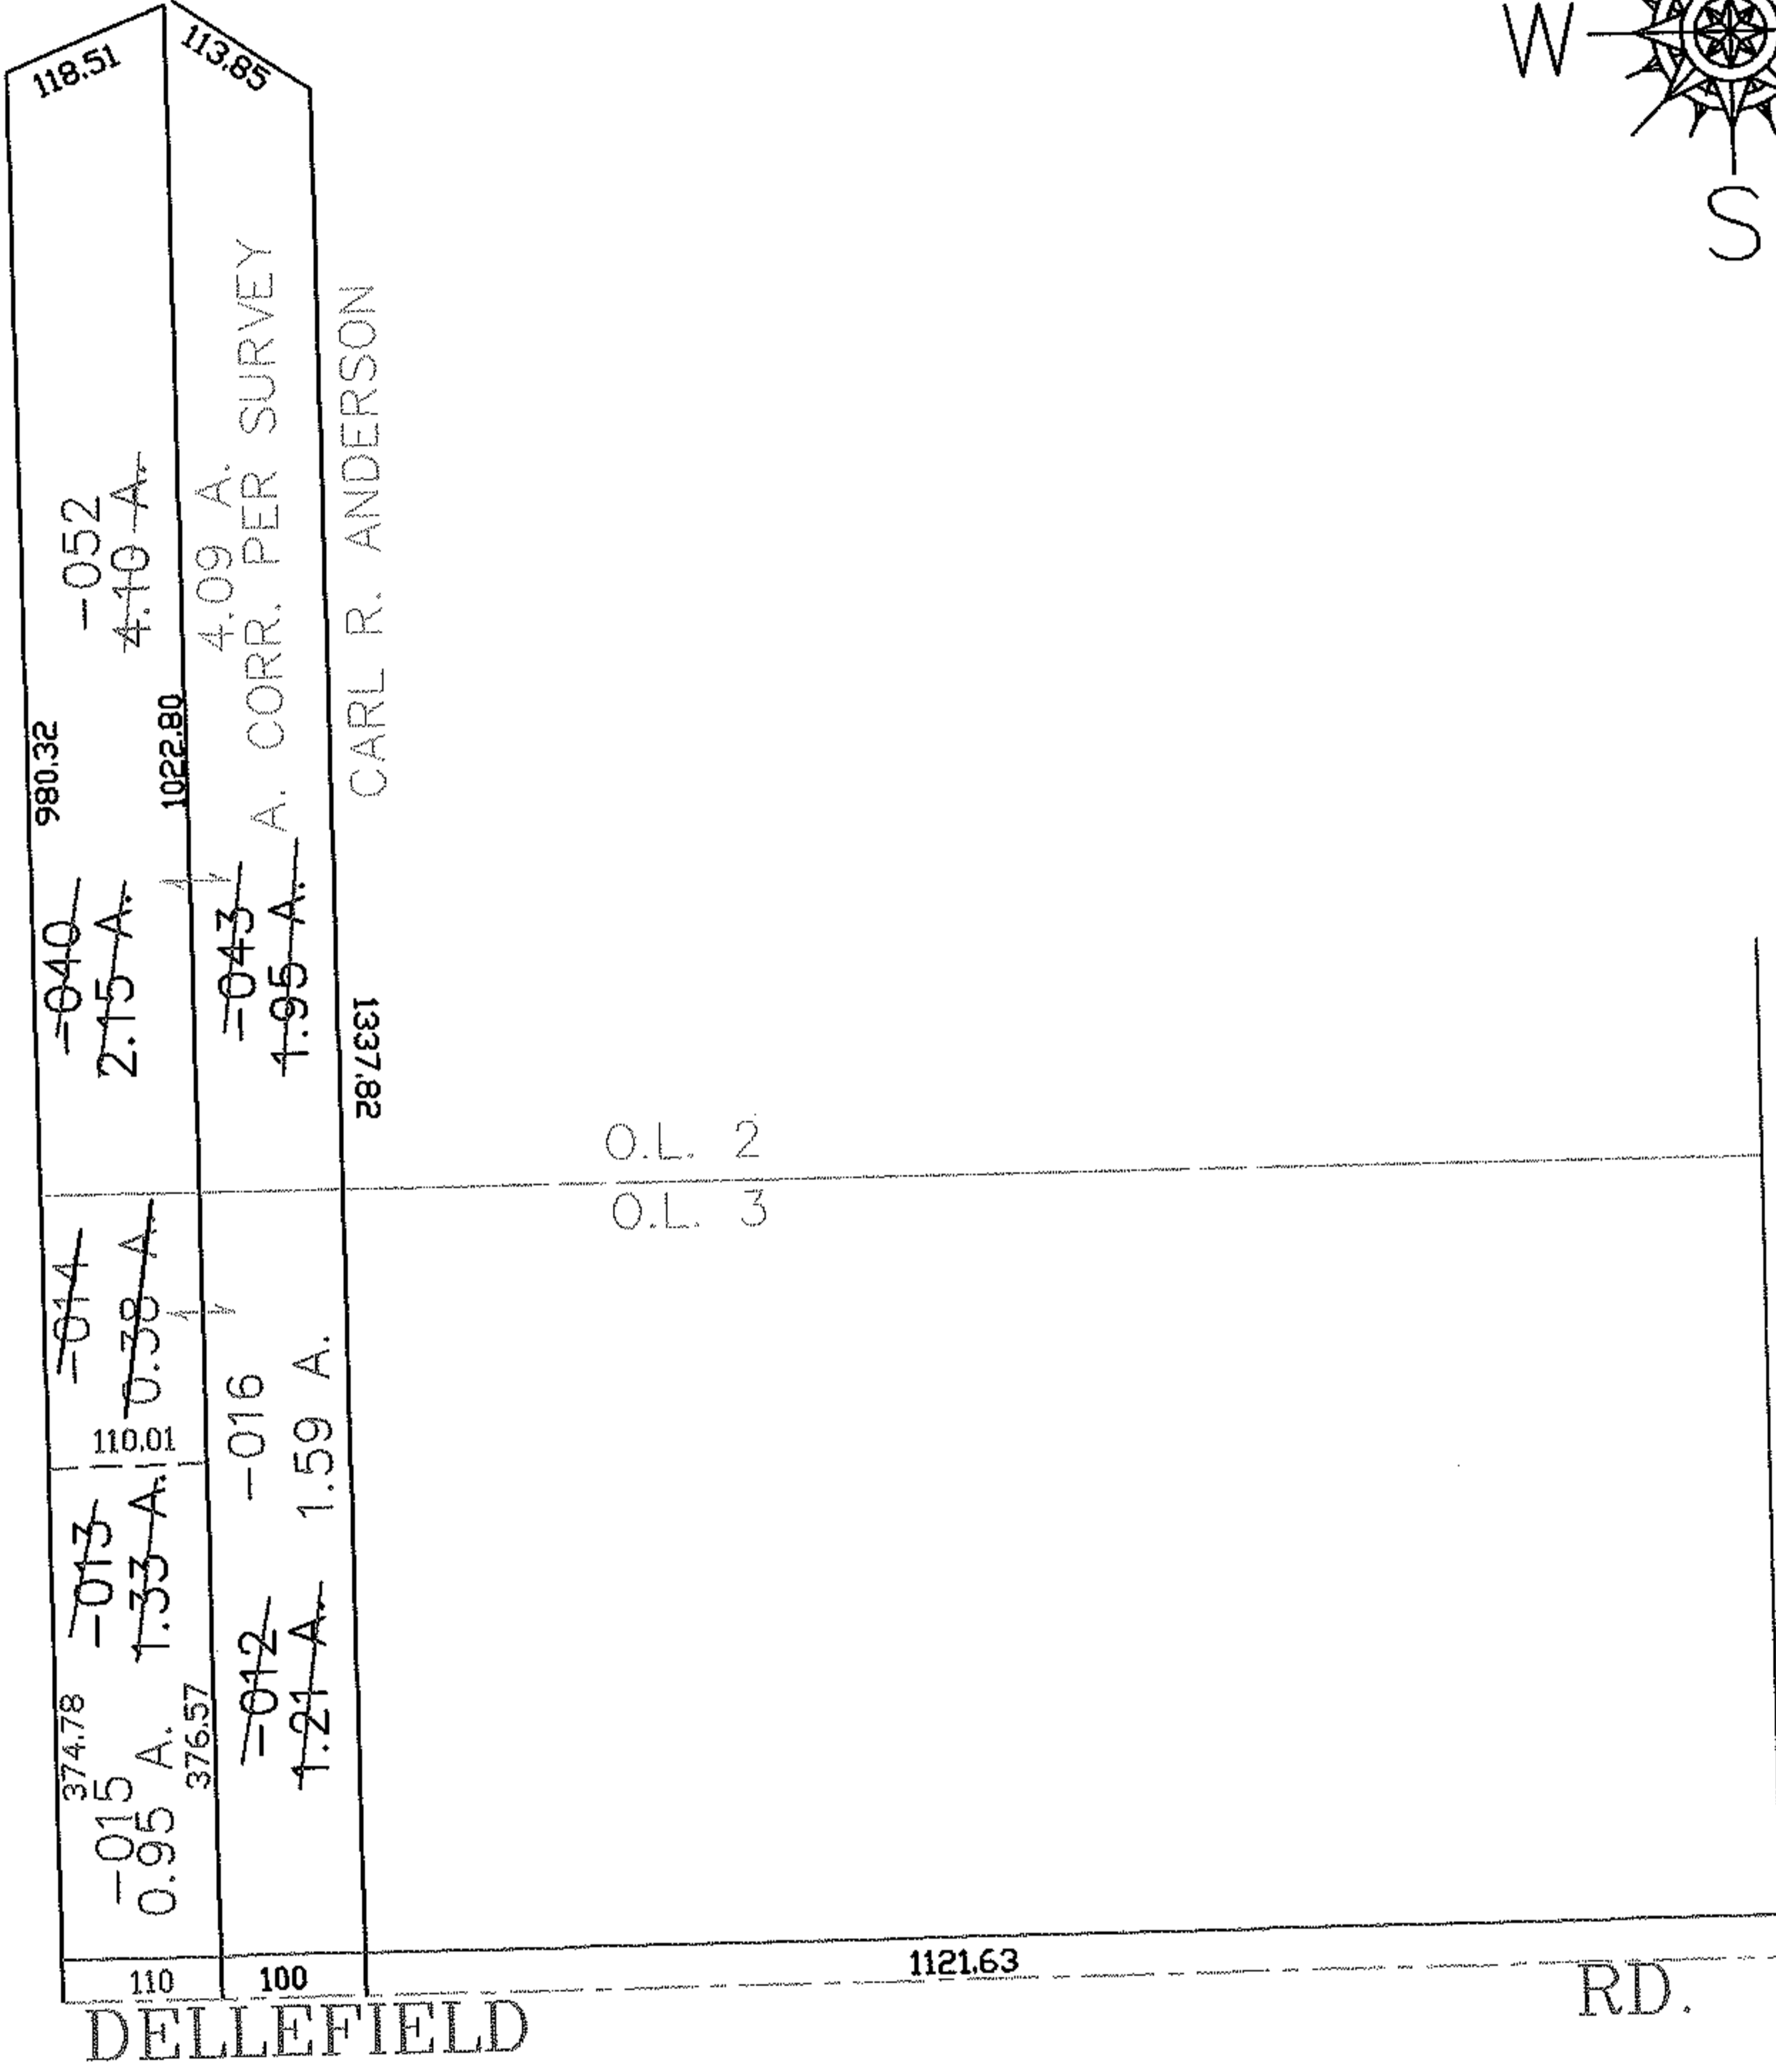


RASTER


PARENT PARCEL: 06-23-002-102-040, -043 06-23-003-101-013, -012
CHILD PARCEL: 06-23-002-102-052, 06-23-003-101-014 THRU -016
STARTING POINT: CENTERLINE OF MURRAY RIDGE RD. & DELLEFIELD RD.

NO. 01573

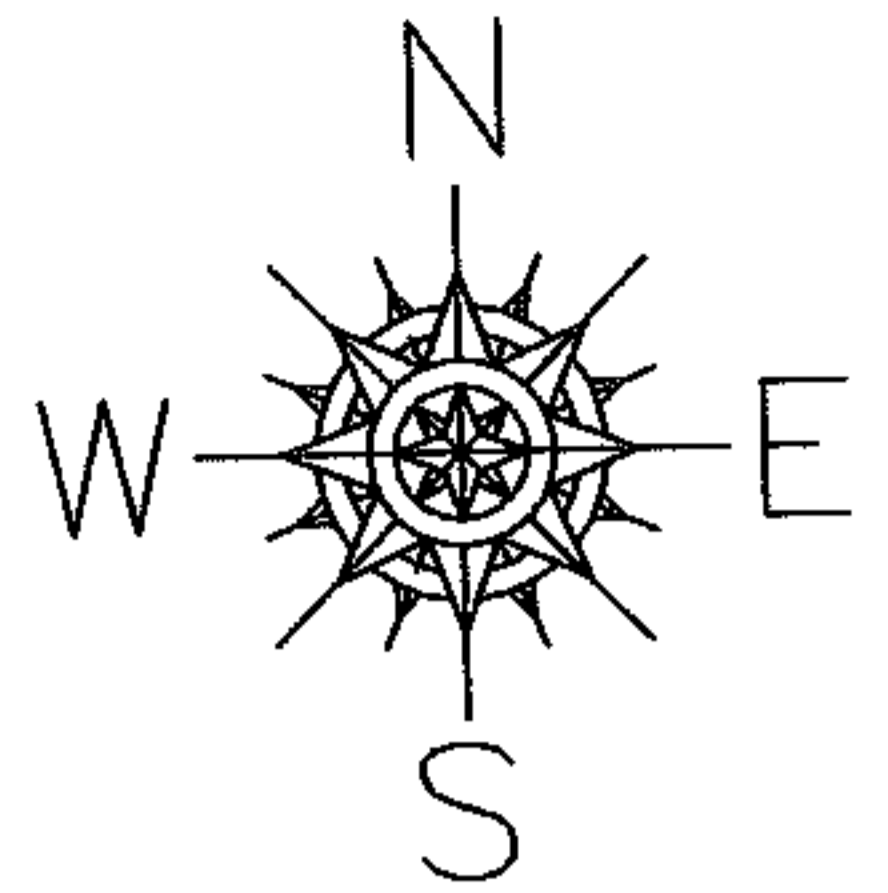

MURRAY RIDGE RD.

DELLEFIELD RD.

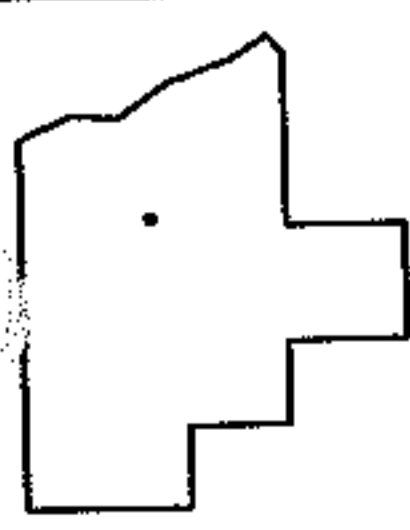

SPLITS/DEEDS PROCESSED
LORAIN COUNTY TAX MAP DEPARTMENT
226 MIDDLE AVE. ELYRIA, OHIO

SURVEYED BY: CARL R. ANDERSON
CLOSURE: 0.00 : 10.000
MAP PAGE(S): 6-21
APPROVED BY: JAH DATE: 1-28-04
SCALE: 1" = 200 PRIOR INSTRUMENT: 20000667031