
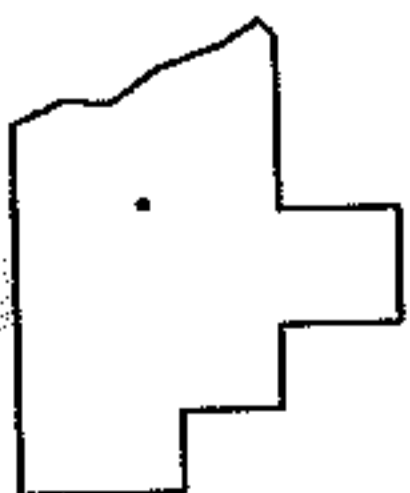
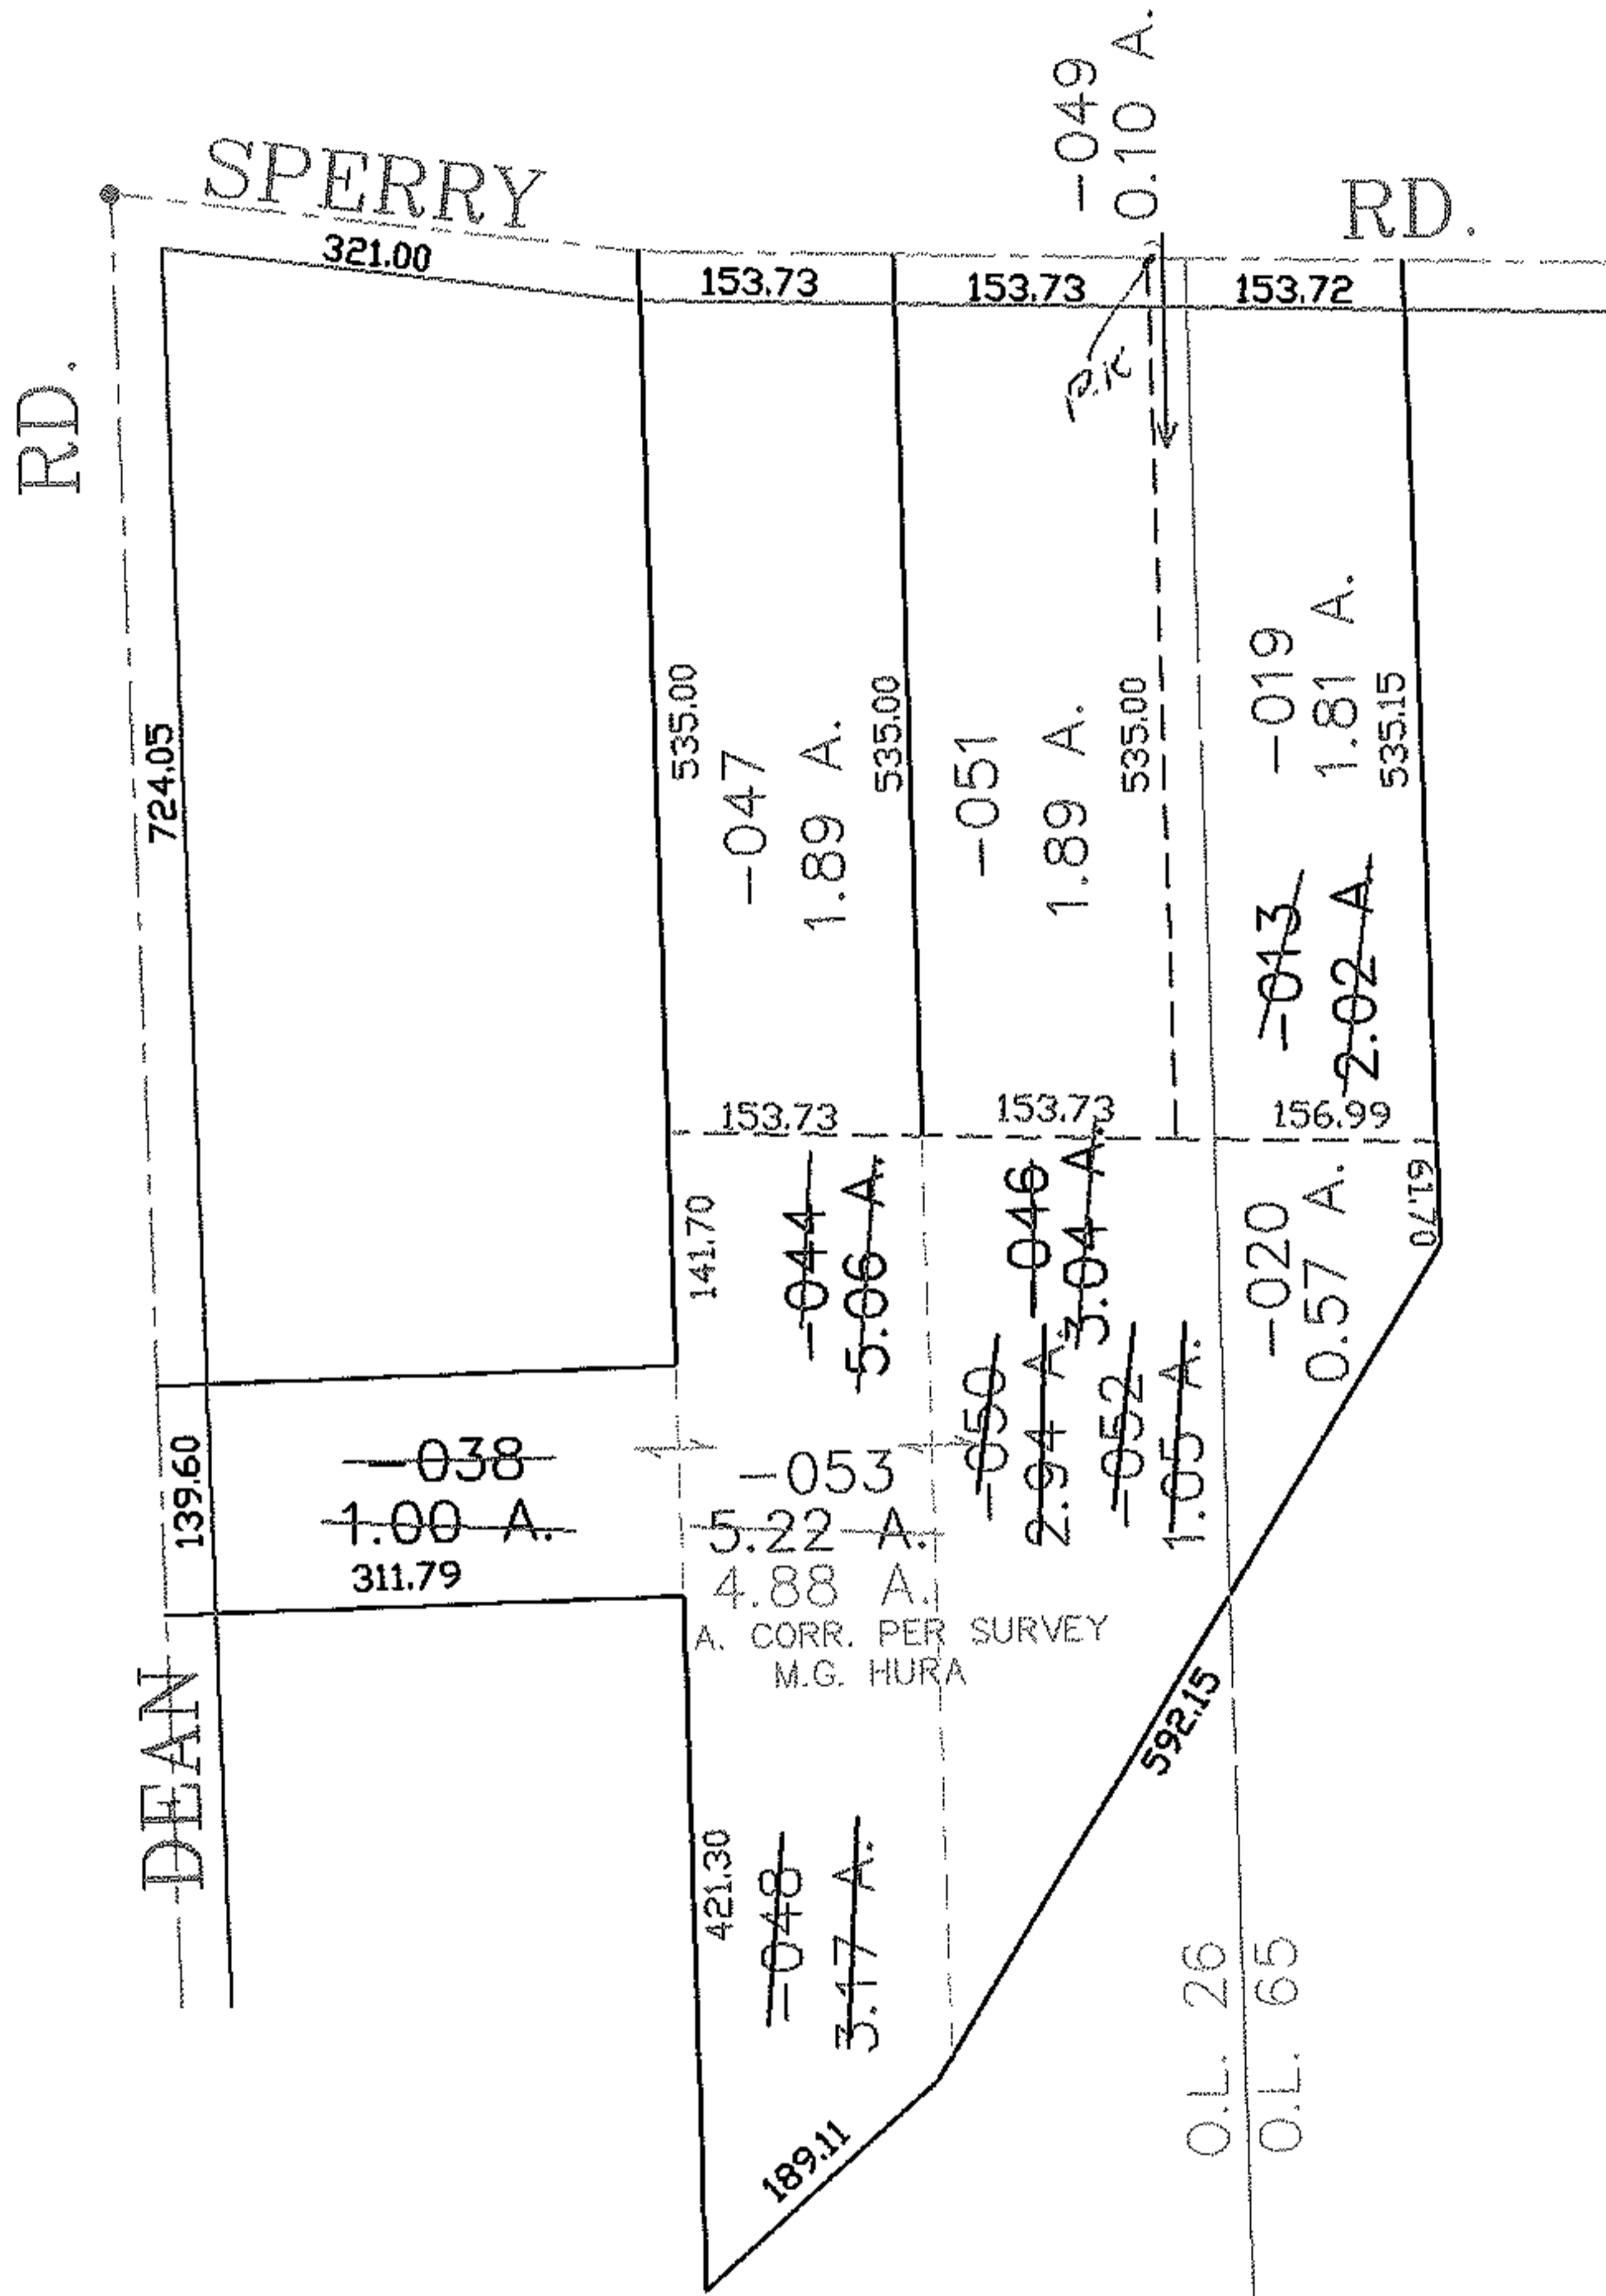


PARENT PARCEL: 01-00-080-000-013, 01-20-026-000-044, -046  
CHILD PARCEL: 01-20-026-000-047 THRU -053 01-00-080-000-019, -020  
STARTING POINT: CENTERLINE OF SPERRY RD. & DEAN RD.

NO. 01574

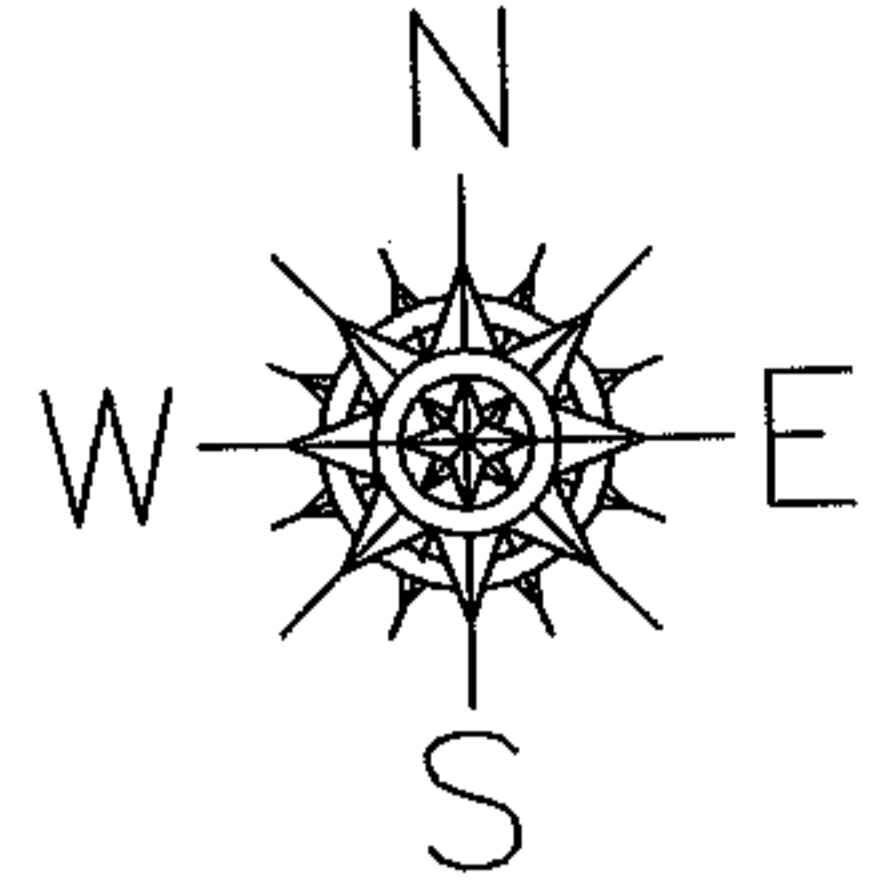

**SPLITS/DEEDS PROCESSED**  
LORAIN COUNTY TAX MAP DEPARTMENT  
226 MIDDLE AVE. ELYRIA, OHIO

SURVEYED BY: M.G. HURA  
CLOSURE: 0.00 : 10.000  
MAP PAGE(S): 01-00-080-A  
APPROVED BY: JAH DATE: 1-22-04  
SCALE: 1" = 200 PRIOR INSTRUMENT: DV XXXX/XXX