
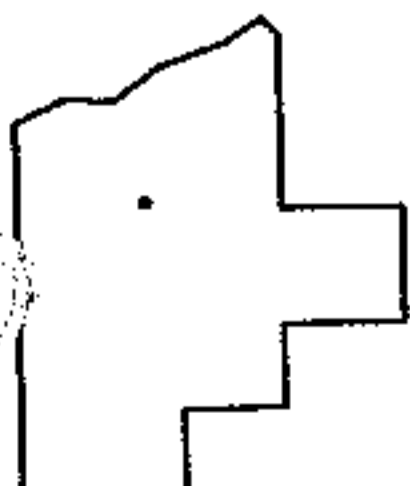
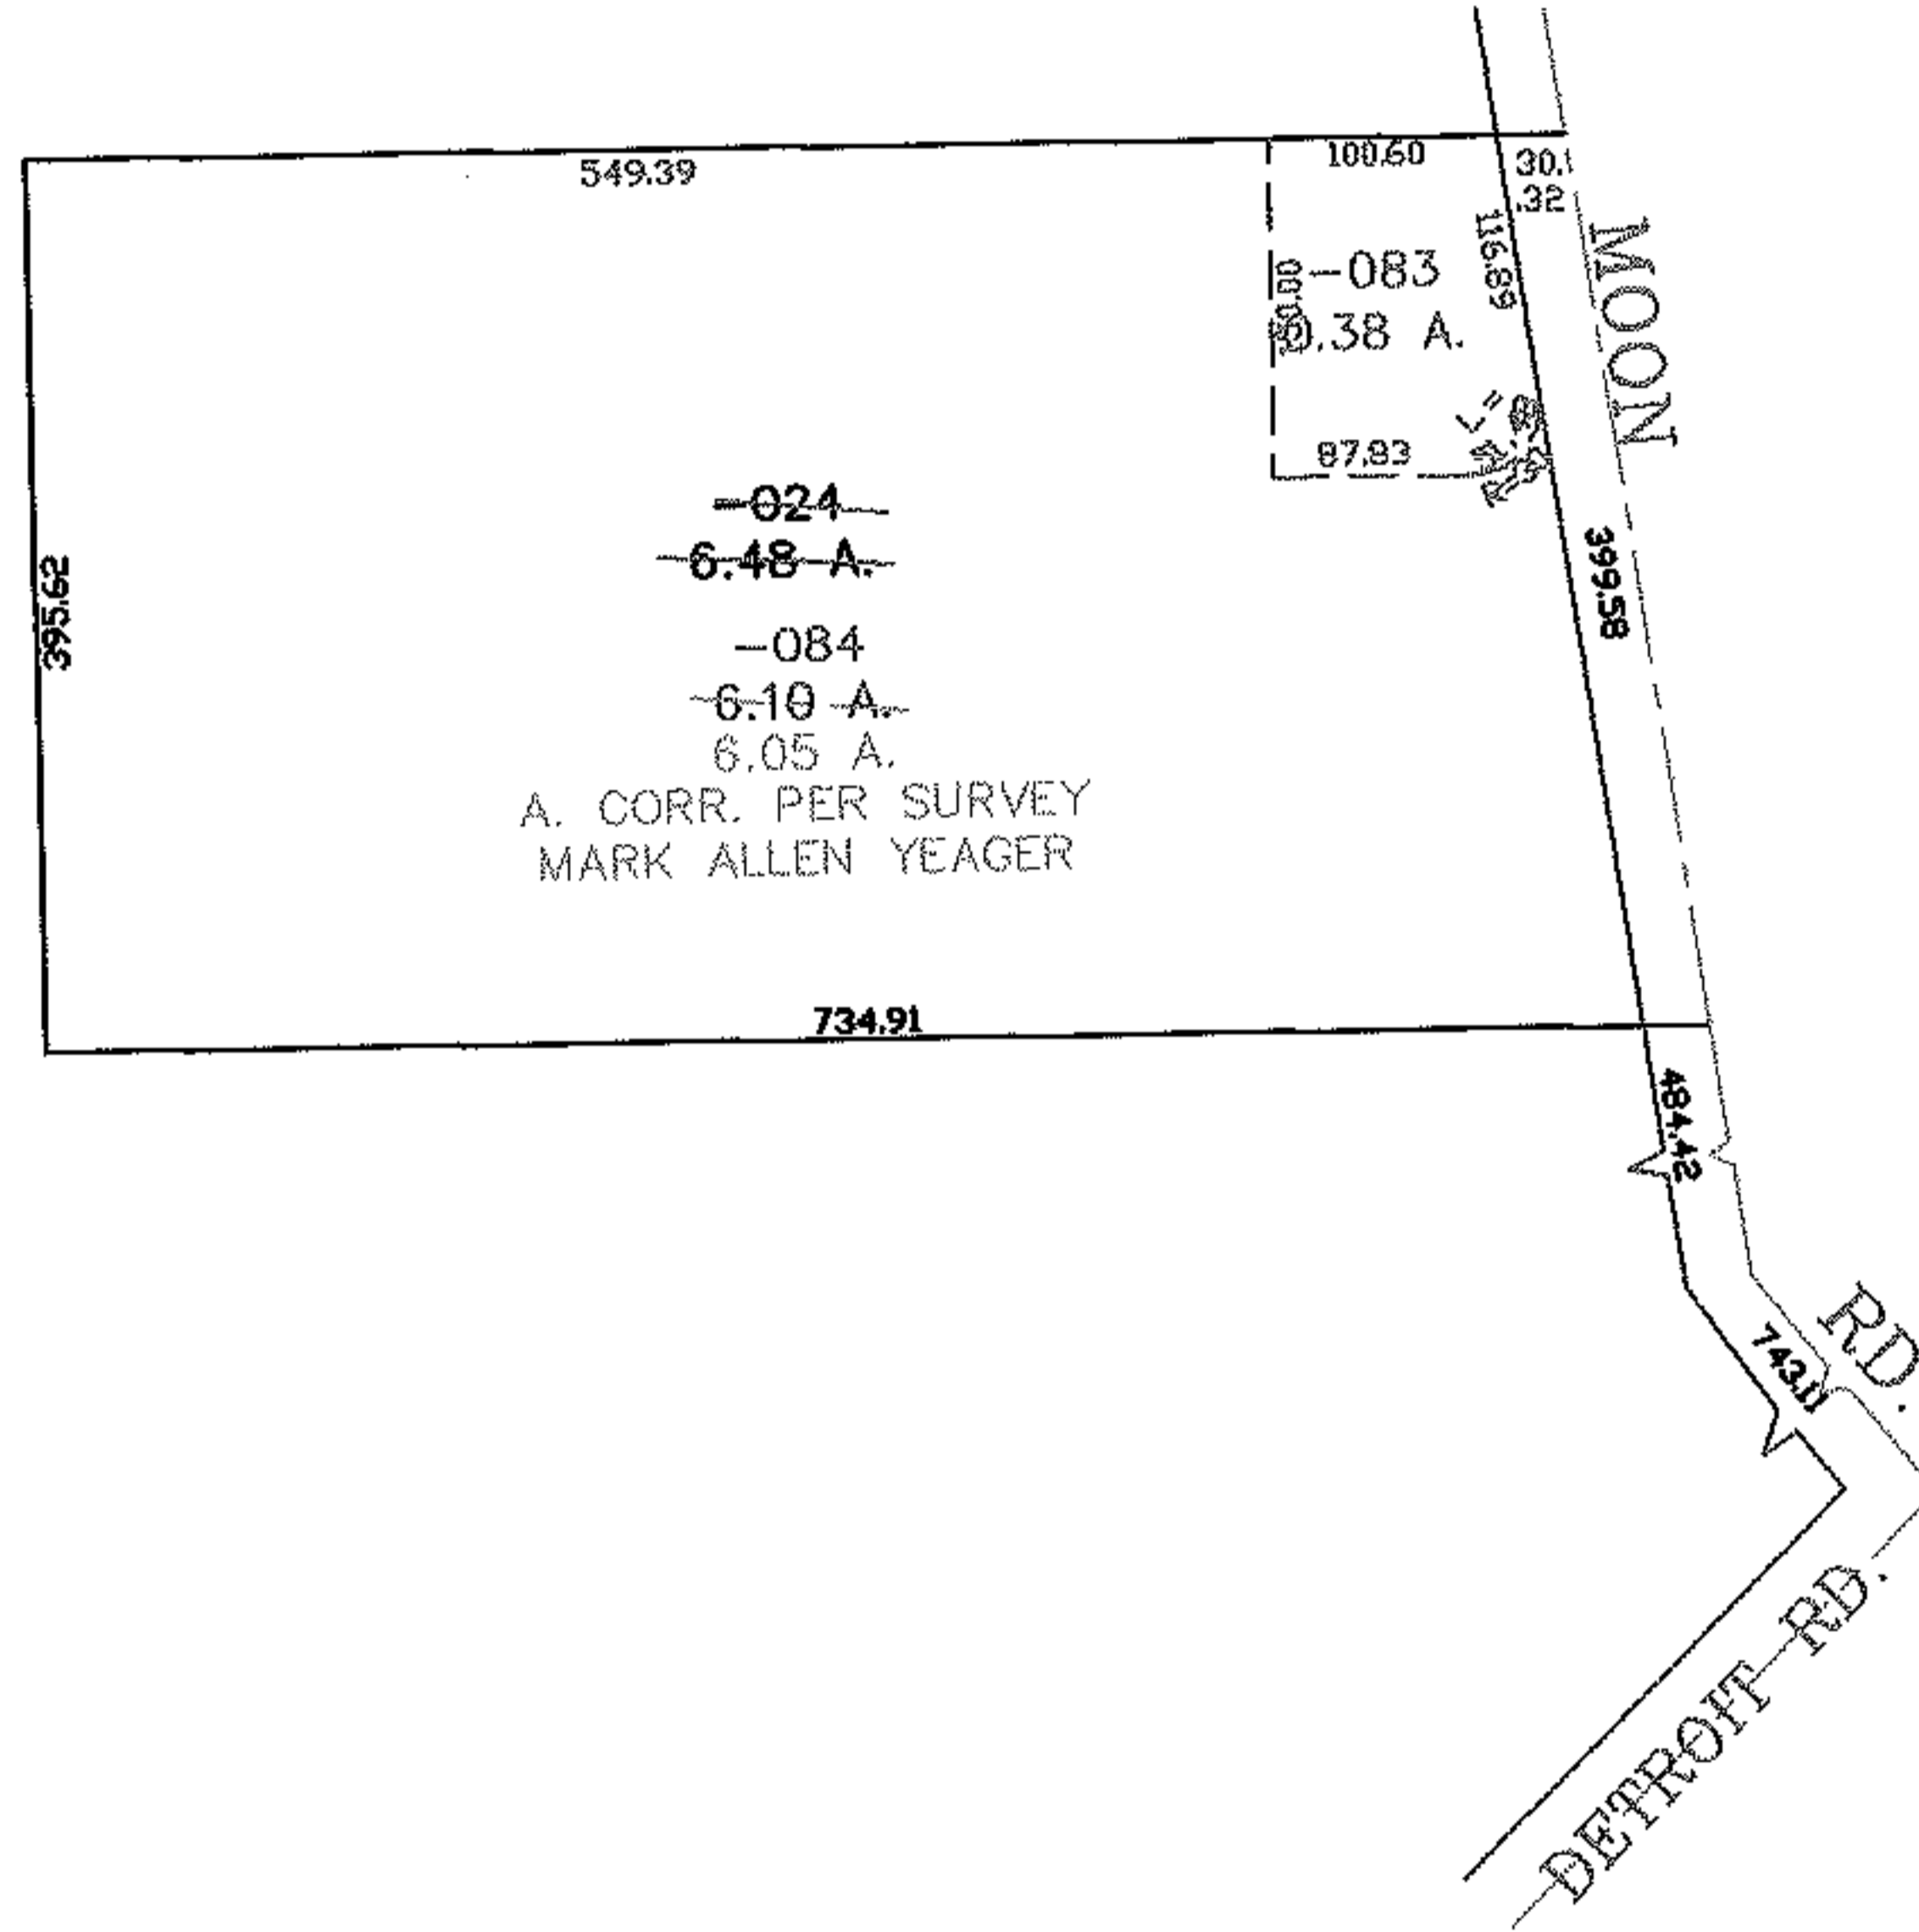


PARENT PARCEL: 04-00-002-101-024

CHILD PARCEL: 04-00-002-101-083, -084

STARTING POINT: CENTERLINE OF MOON RD. & DETROIT RD.

NO. 01586

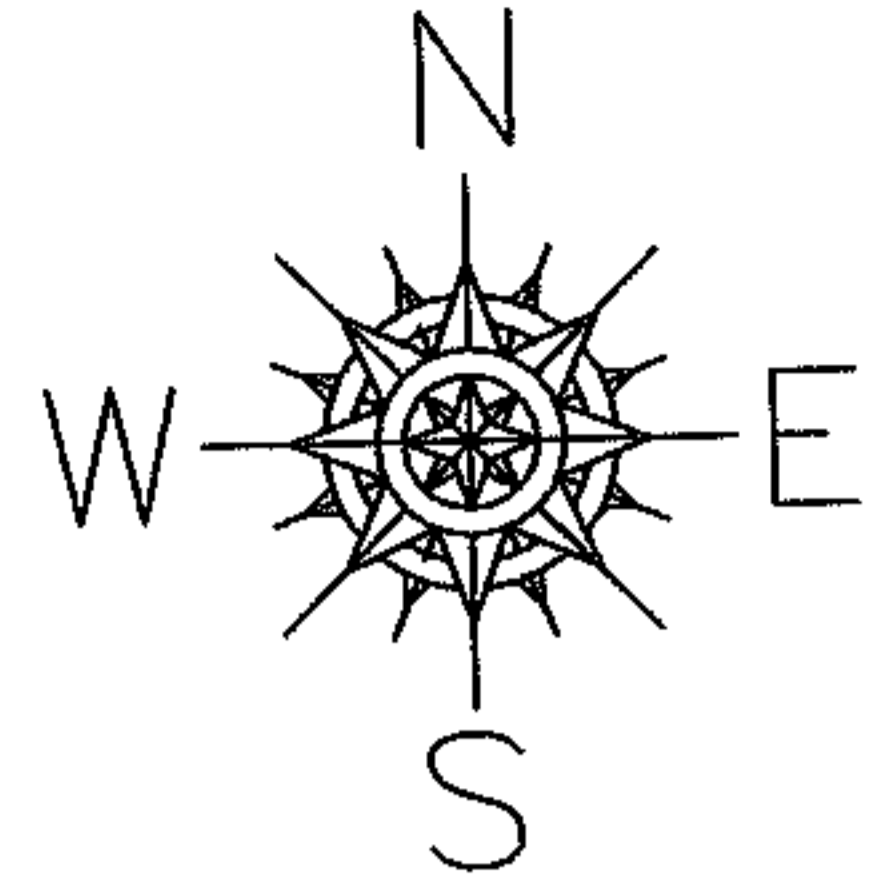

SPLITS/DEEDS PROCESSED
 LORAIN COUNTY TAX MAP DEPARTMENT
 226 MIDDLE AVE. ELYRIA, OHIO

SURVEYED BY: MARK ALLEN YEAGER
 CLOSURE: 0.00 ; 10.000
 MAP PAGE(S): 04-00-002-A
 APPROVED BY: JAH DATE: 2-4-04
 SCALE: 1" = 200 PRIOR INSTRUMENT: DV 499/137