
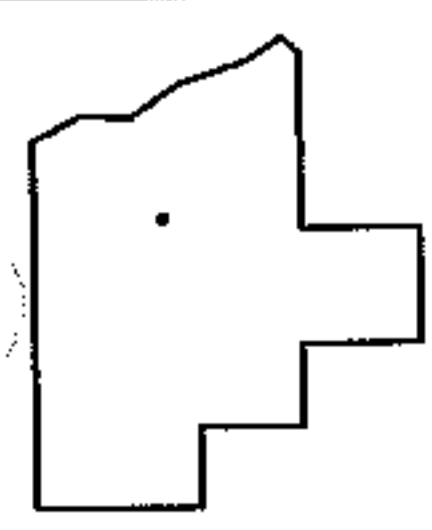
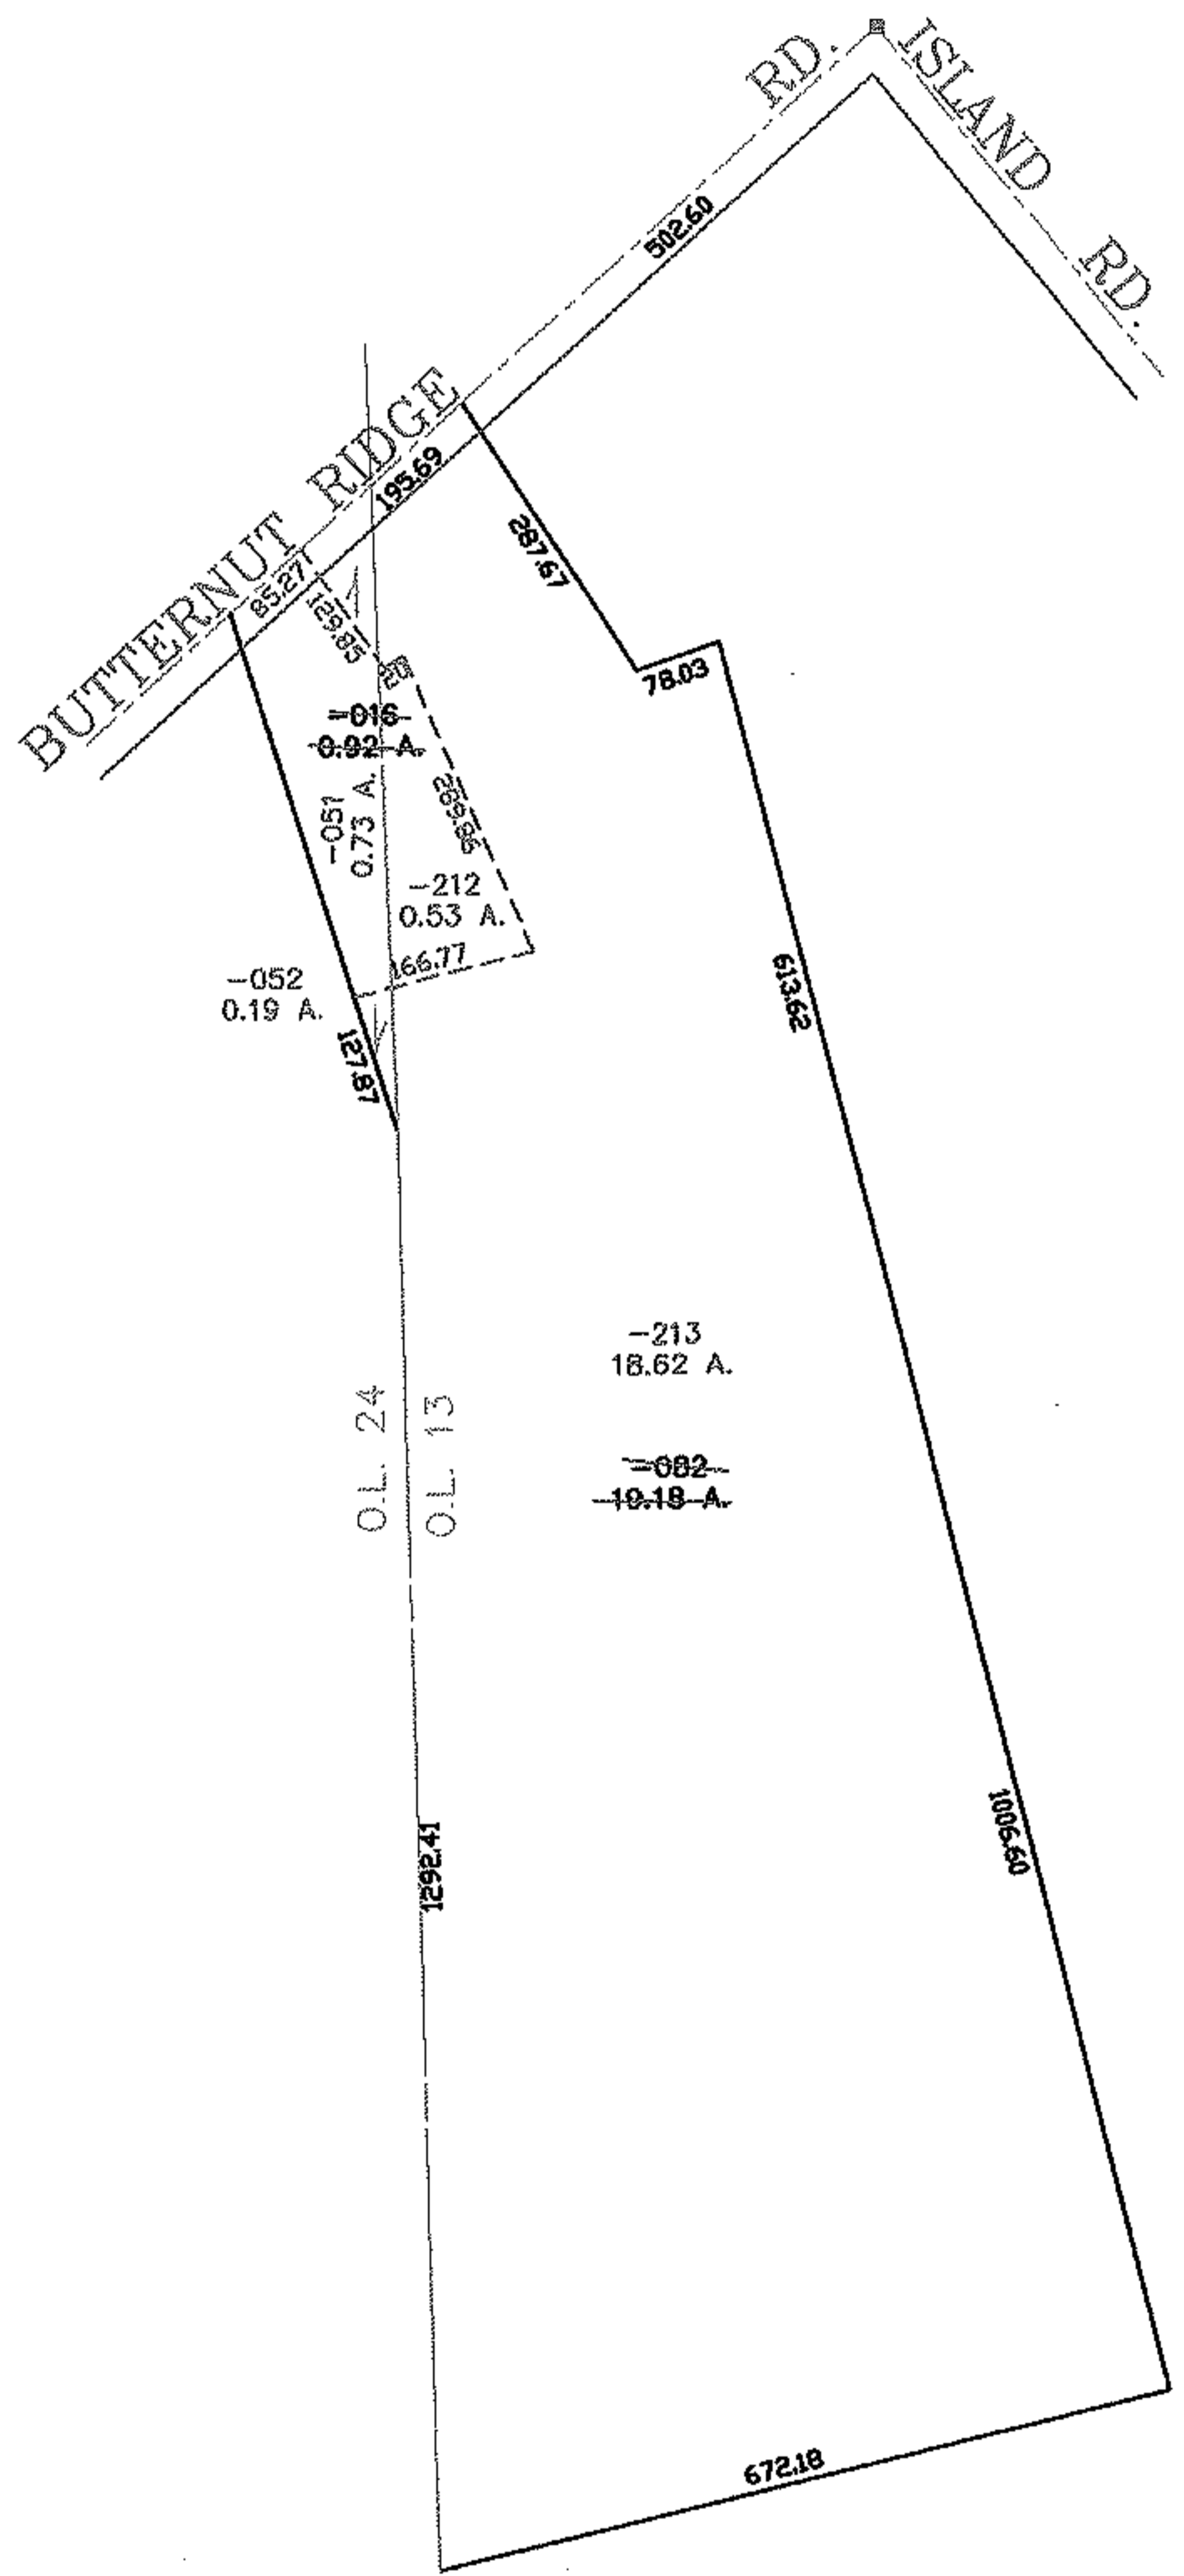


FASTER

PARENT PARCEL: 07-00-013-000-082, 07-00-024-102-016
CHILD PARCEL: 07-00-013-000-212, -213 & 07-00-024-102-051, -052
STARTING POINT: CENTERLINE OF BUTTERNUT RIDGE RD. & ISLAND RD.

NO. 01593

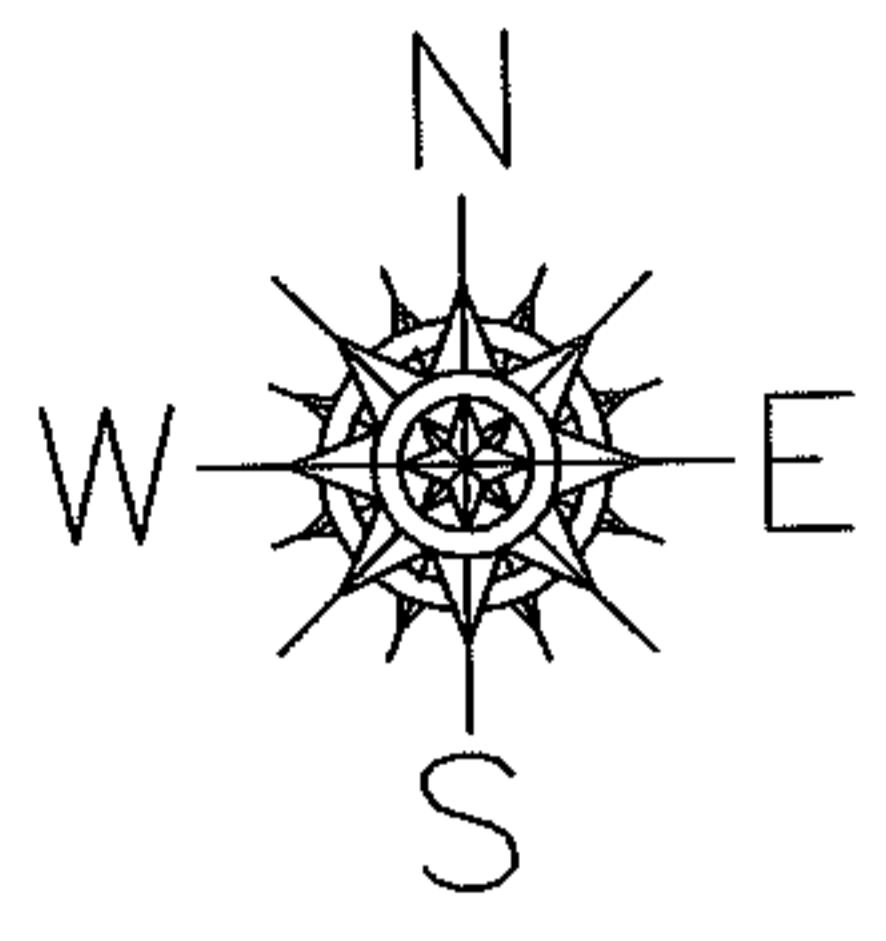

SPLITS/DEEDS PROCESSED
LORAIN COUNTY TAX MAP DEPARTMENT
226 MIDDLE AVE. ELYRIA, OHIO

SURVEYED BY: DANIEL LAUX
CLOSURE: 0.00 : 10,000
MAP PAGE(S): 07-00-013-A, 07-00-024-B
APPROVED BY: JAH DATE: 2-23-04
SCALE: 1" = 300 PRIOR INSTRUMENT: 20030974134