




MASTER

PARENT PARCEL: 15-00-039-000-008

CHILD PARCEL: 15-00-039-000-009 THRU -013

STARTING POINT: CENTERLINE OF BIGGS RD. & DIAGONAL RD.

NO. 01600

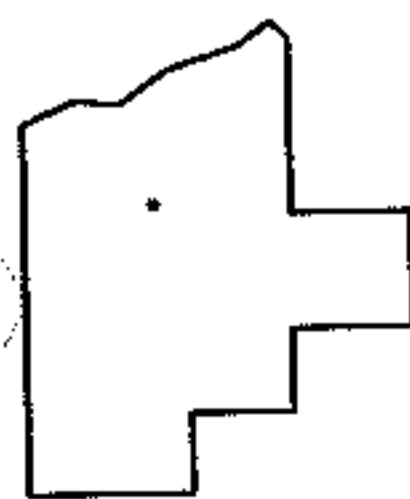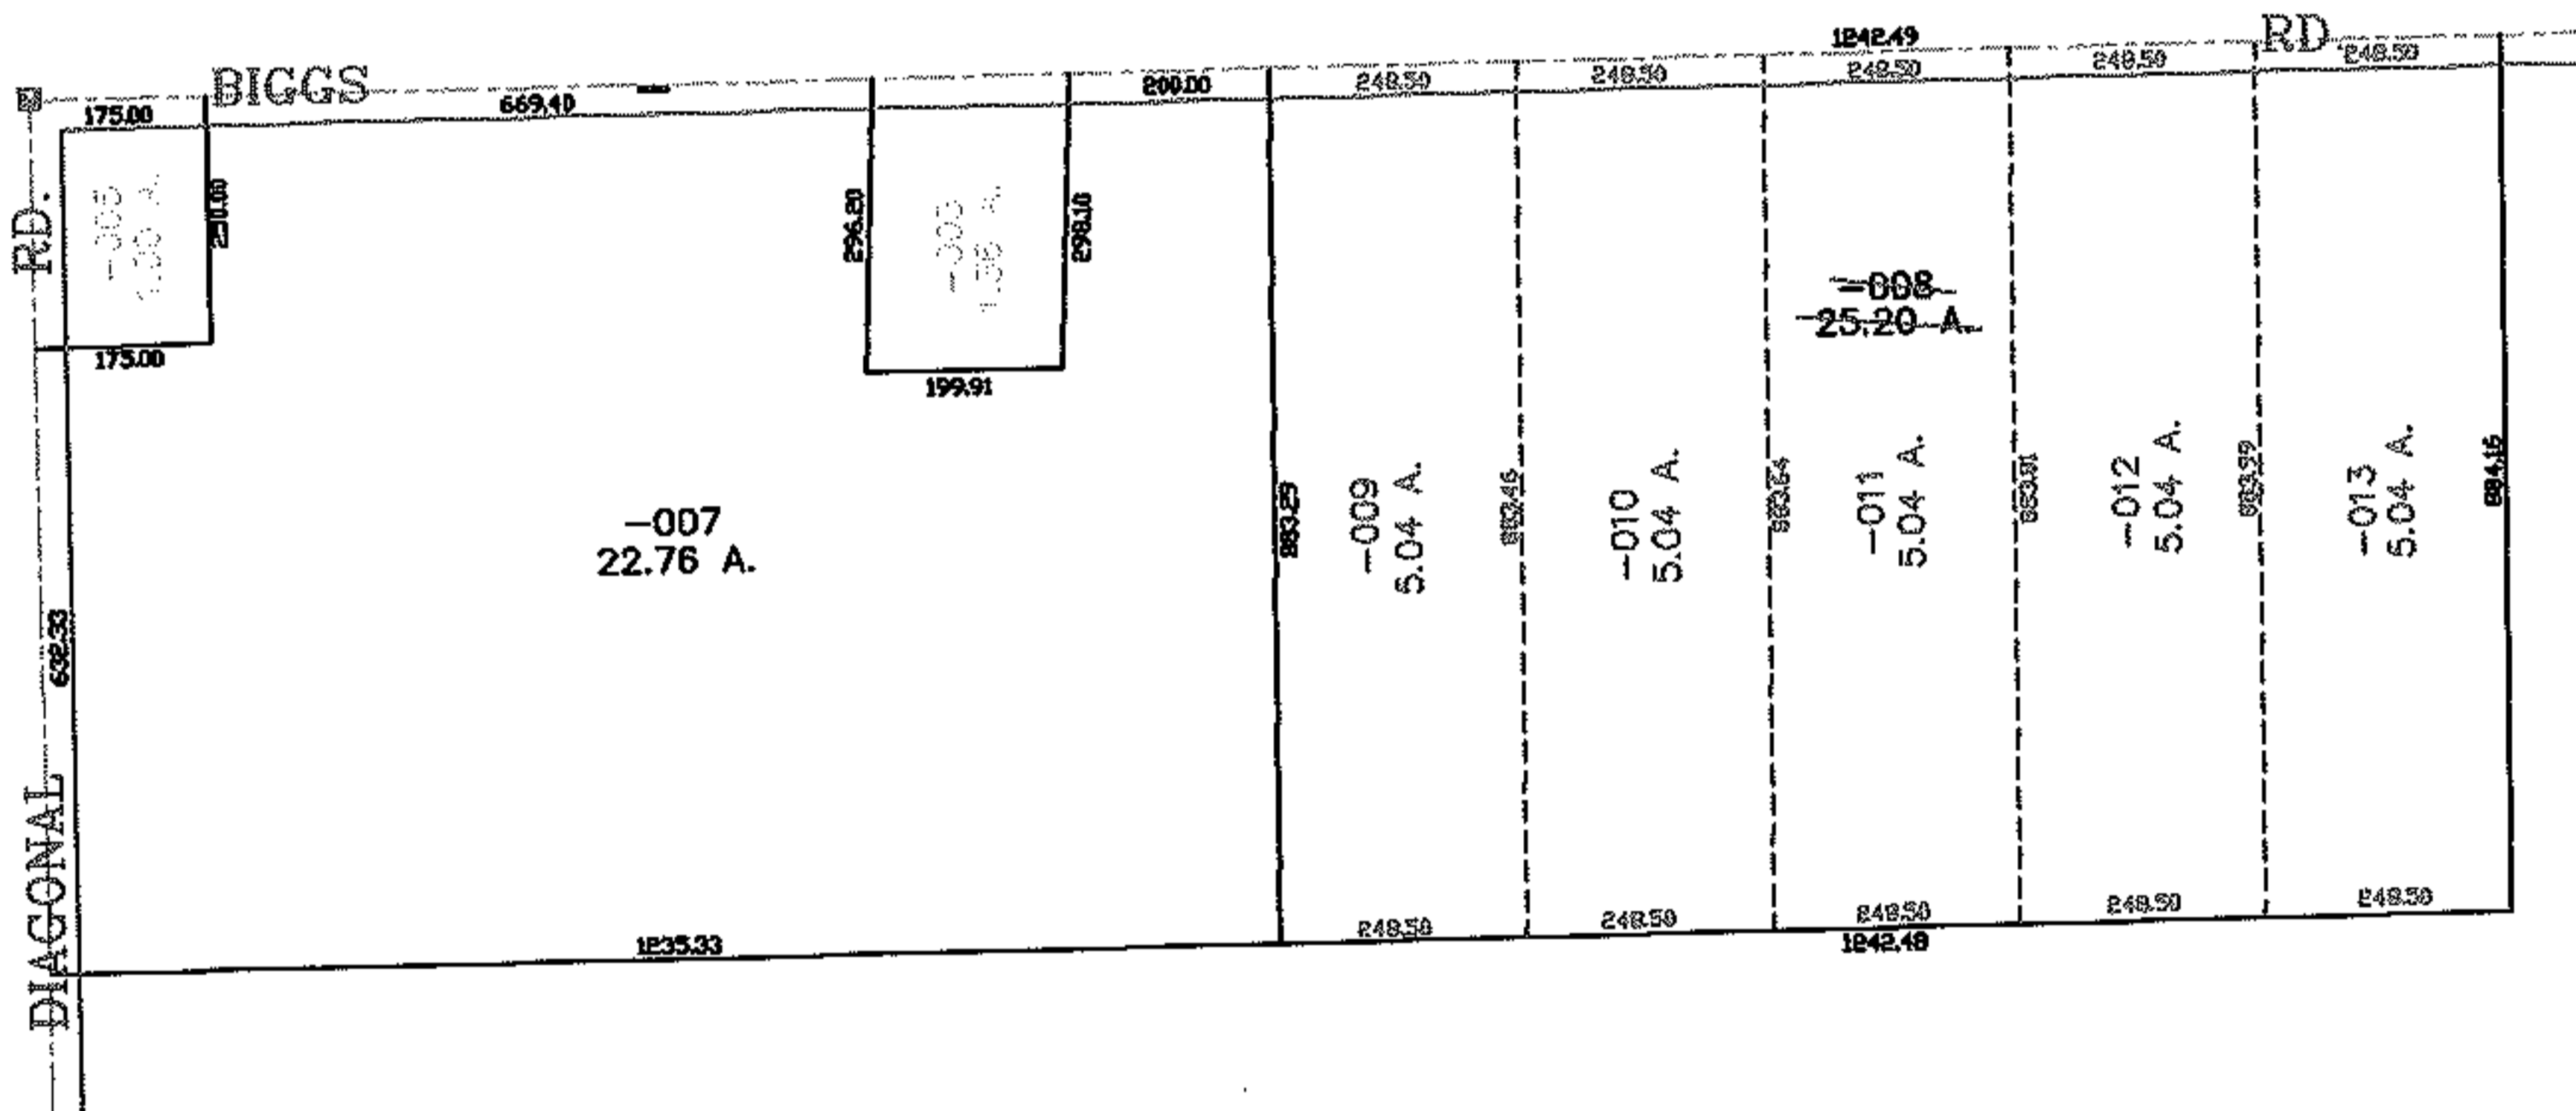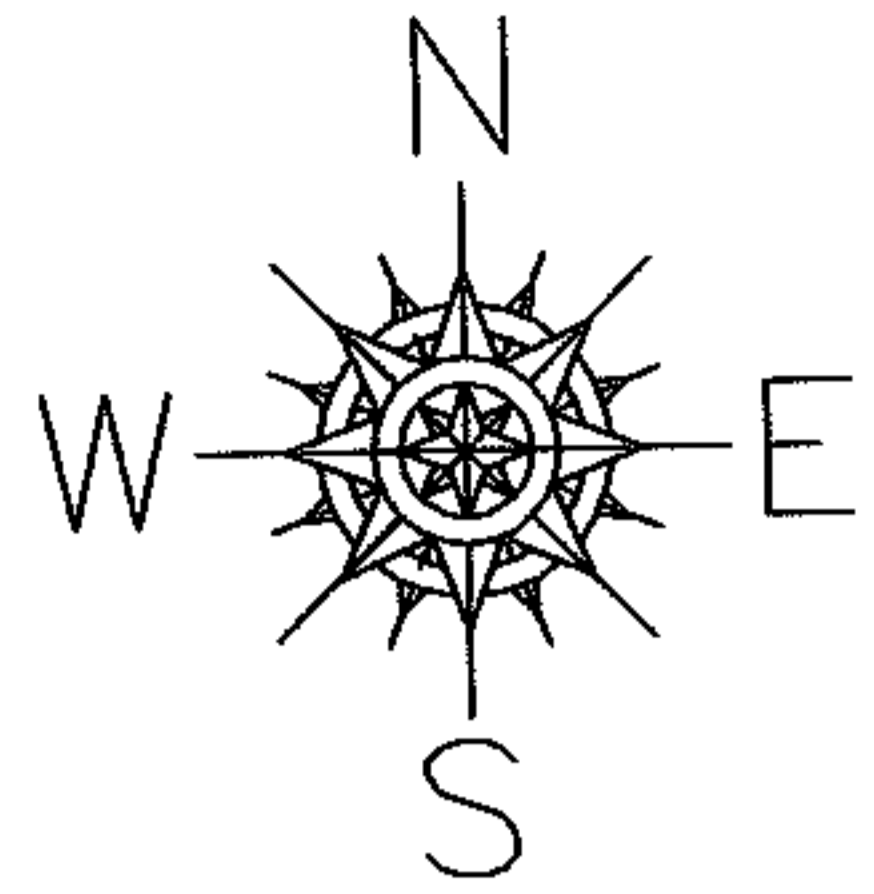

SPLITS/DEEDS PROCESSED
 LORAIN COUNTY TAX MAP DEPARTMENT
 226 MIDDLE AVE. ELYRIA, OHIO

SURVEYED BY: DOUGLAS H. MOSLEY
 CLOSURE: 0.00 : 10.000
 MAP PAGE(S): 15-00-039-A
 APPROVED BY: JAH DATE: 3-1-04
 SCALE: 1" = 400 PRIOR INSTRUMENT: 20030928259