


MASTER

PARENT PARCEL: 20-03-013-000-004


CHILD PARCEL: 20-03-013-000-019 THRU -022

STARTING POINT: CENTERLINE OF ASHLAND-KIPTON RD. & NEW LONDON EASTERN RD.


NO. 01601

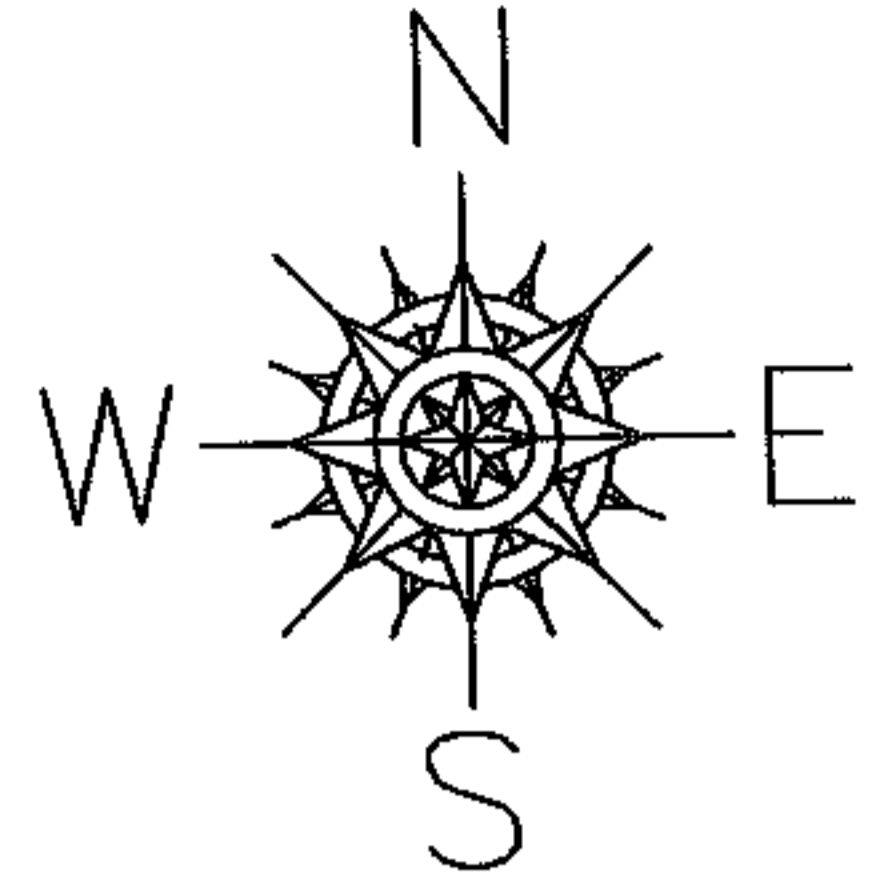

NEW LONDON EASTERN RD.

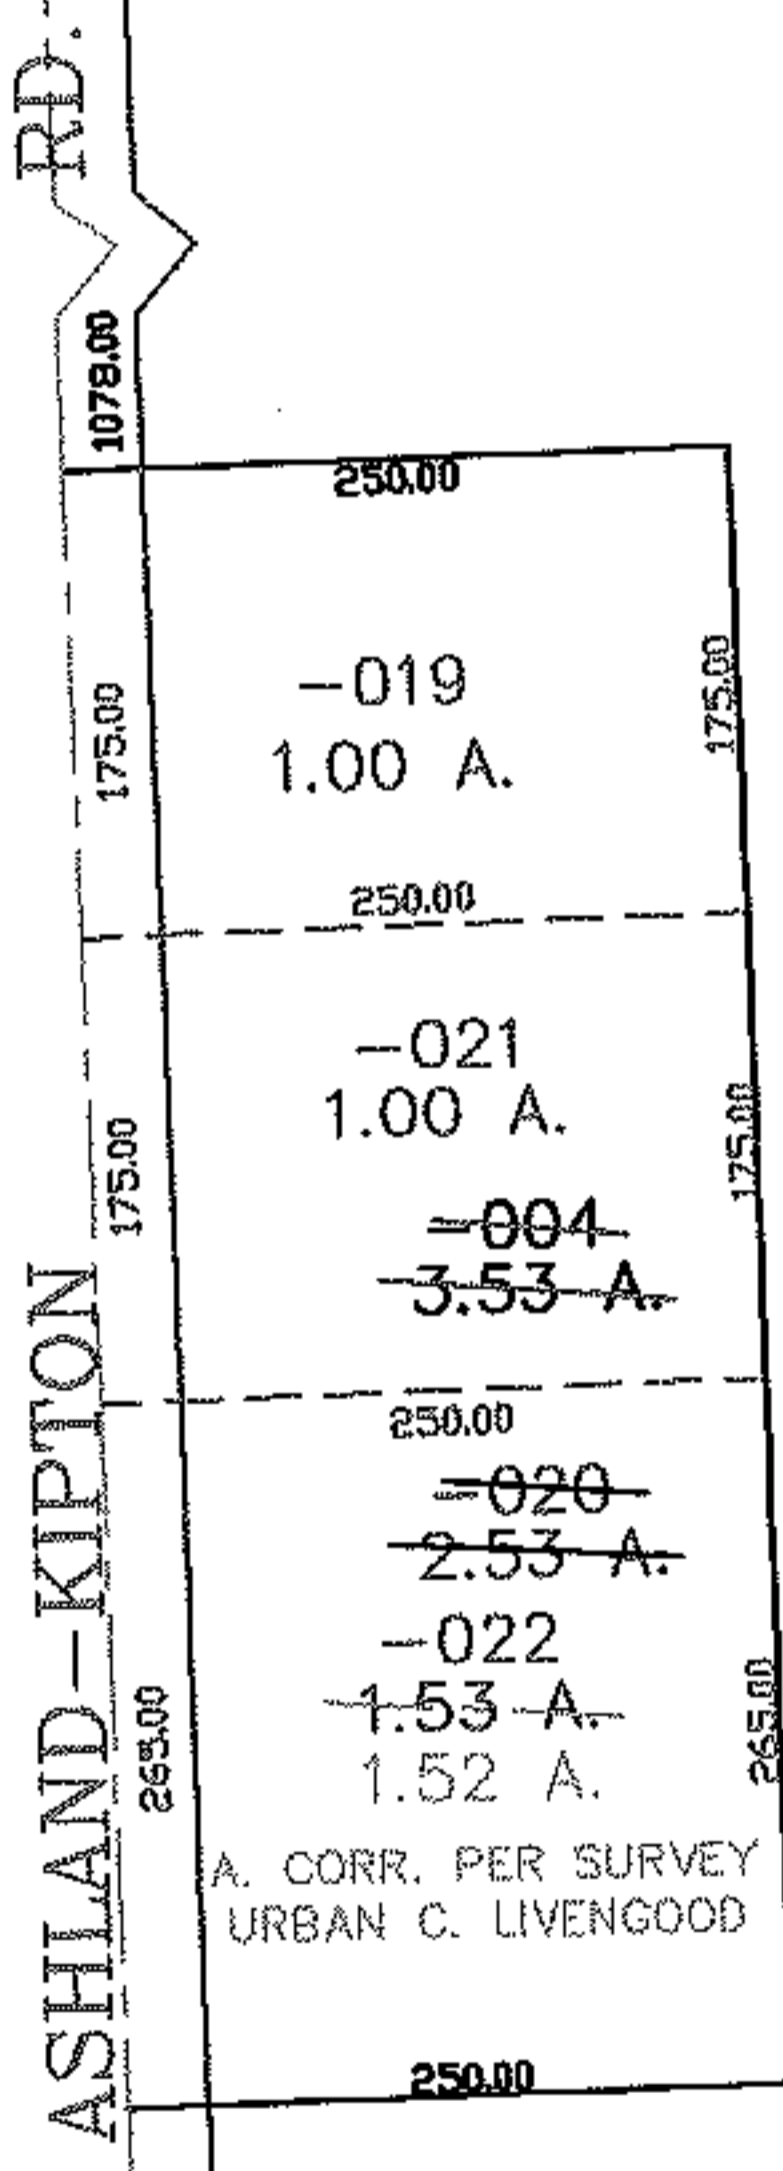

A. CORR. PER SURVEY  
URBAN C. LIVENGOOD

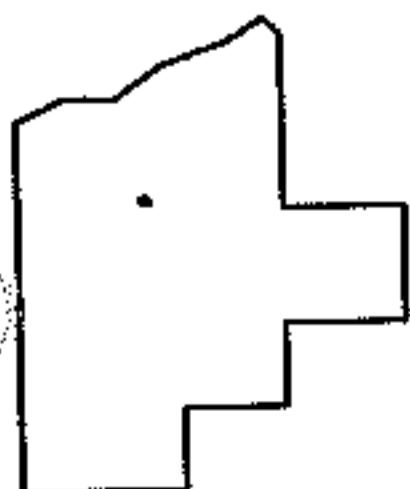

**SPLITS/DEEDS PROCESSED**

LORAIN COUNTY TAX MAP DEPARTMENT  
226 MIDDLE AVE. ELYRIA, OHIO

SURVEYED BY: URBAN C. LIVENGOOD

CLOSURE: 0.00 : 10.000

MAP PAGE(S): 20-G

APPROVED BY: JAH DATE: 3-3-04

SCALE: 1" = 200 PRIOR INSTRUMENT: DV 960/828