




RASTER

PARENT PARCEL: 04-00-021-000-202

CHILD PARCEL: 04-00-021-000-214, -215

STARTING POINT: NW CORNER OF BLOCK "B" OF AVON COMMERCE PKWY SUBD.

NO. 01605

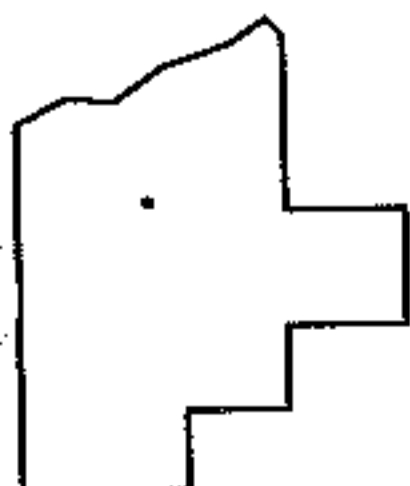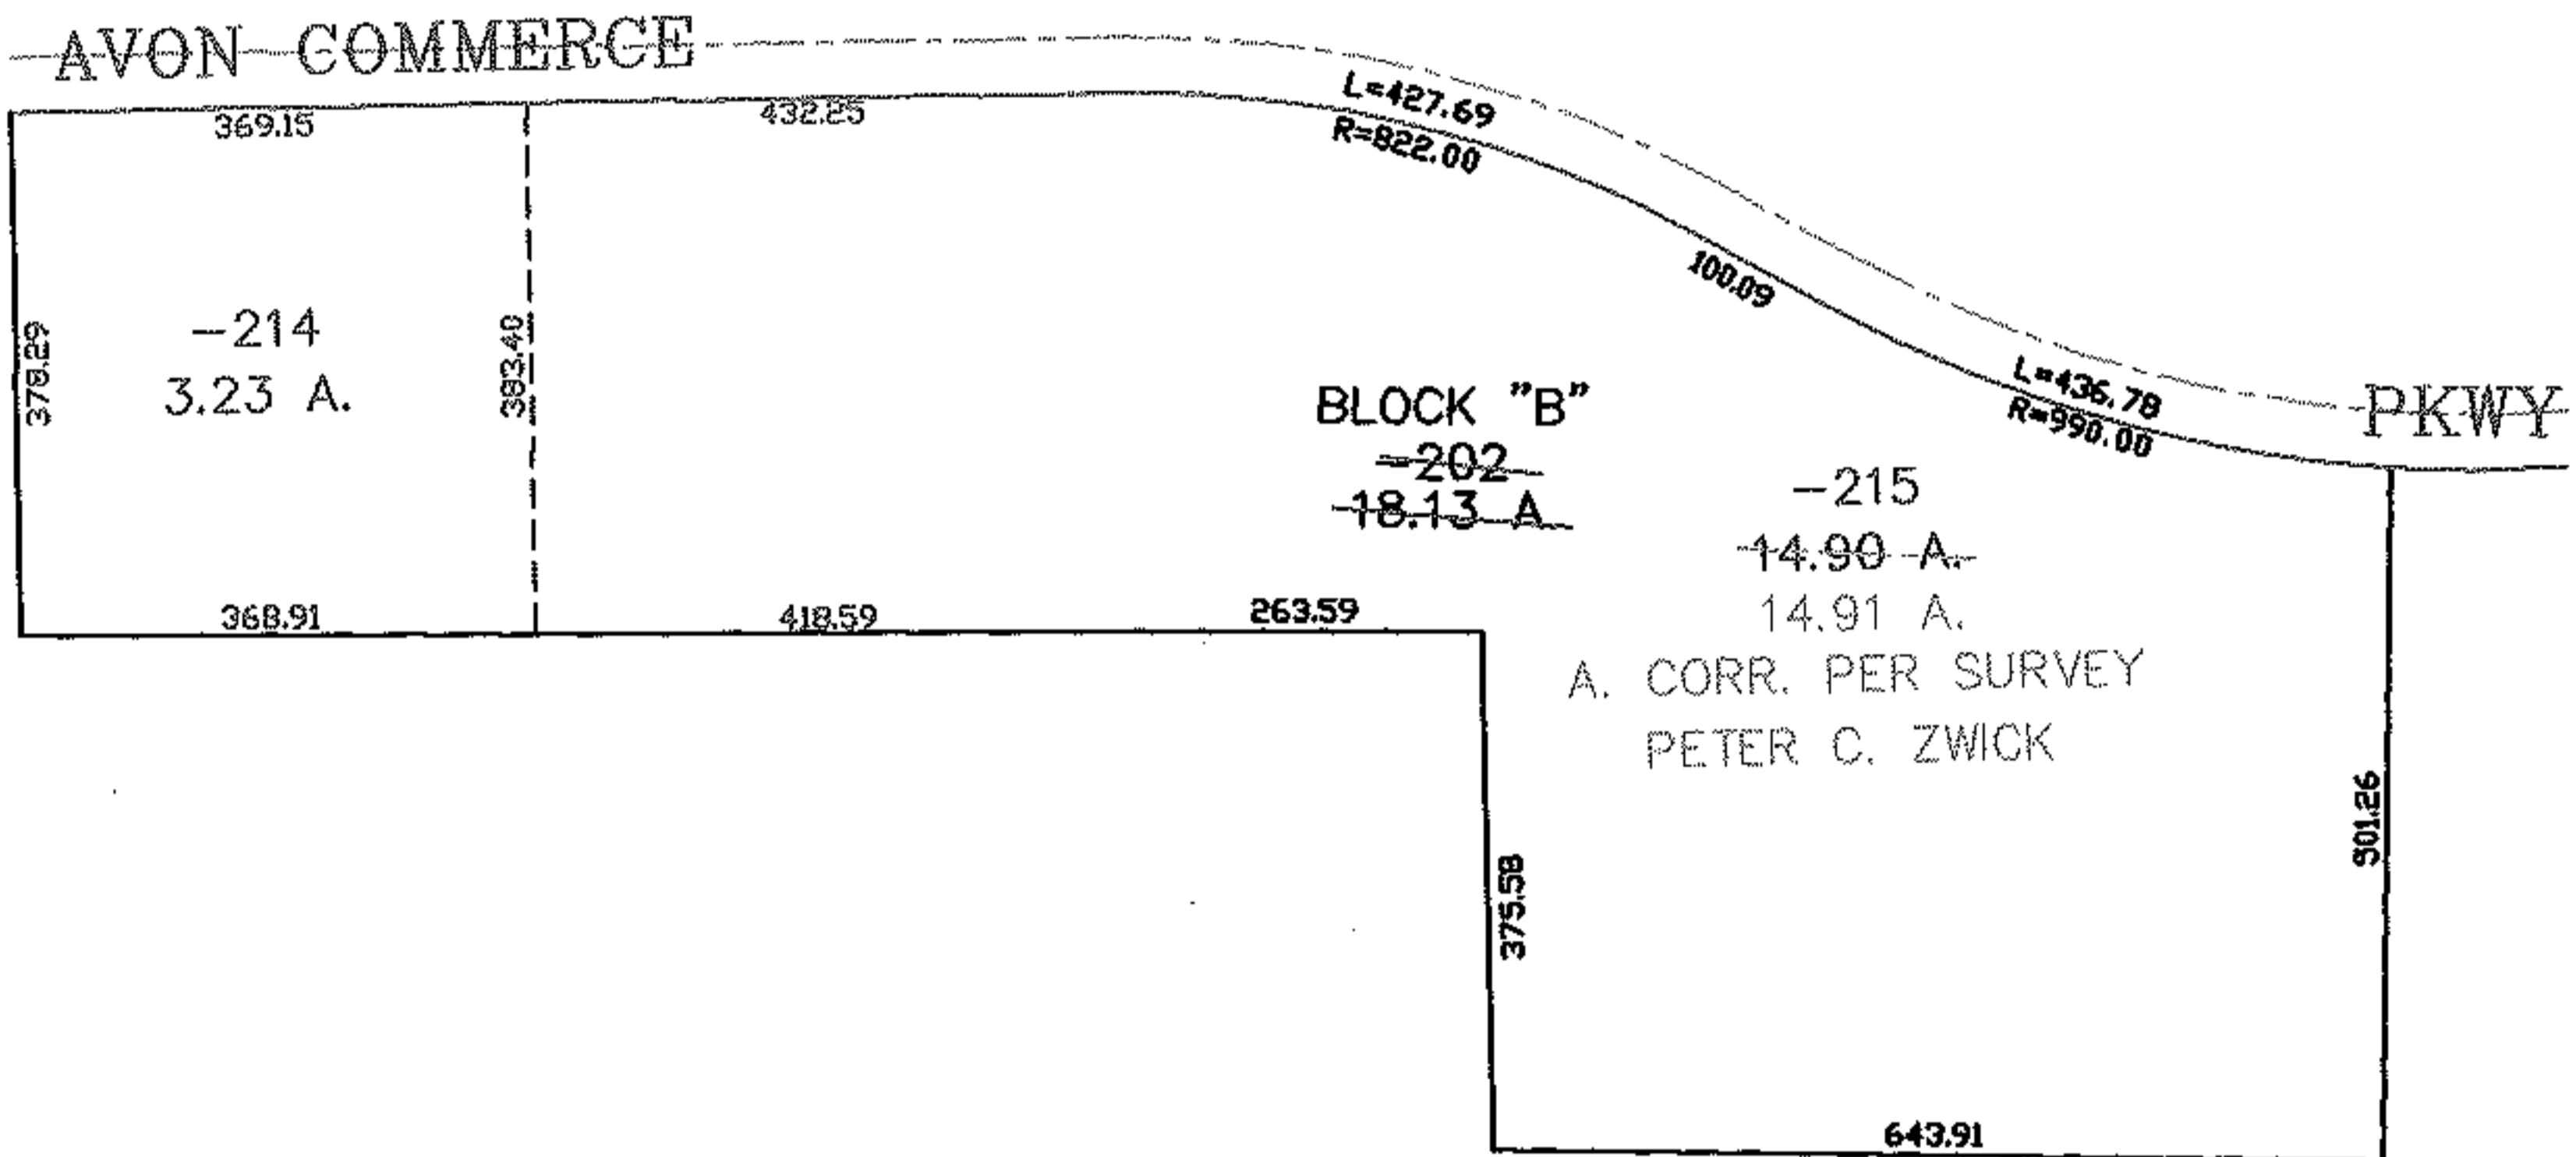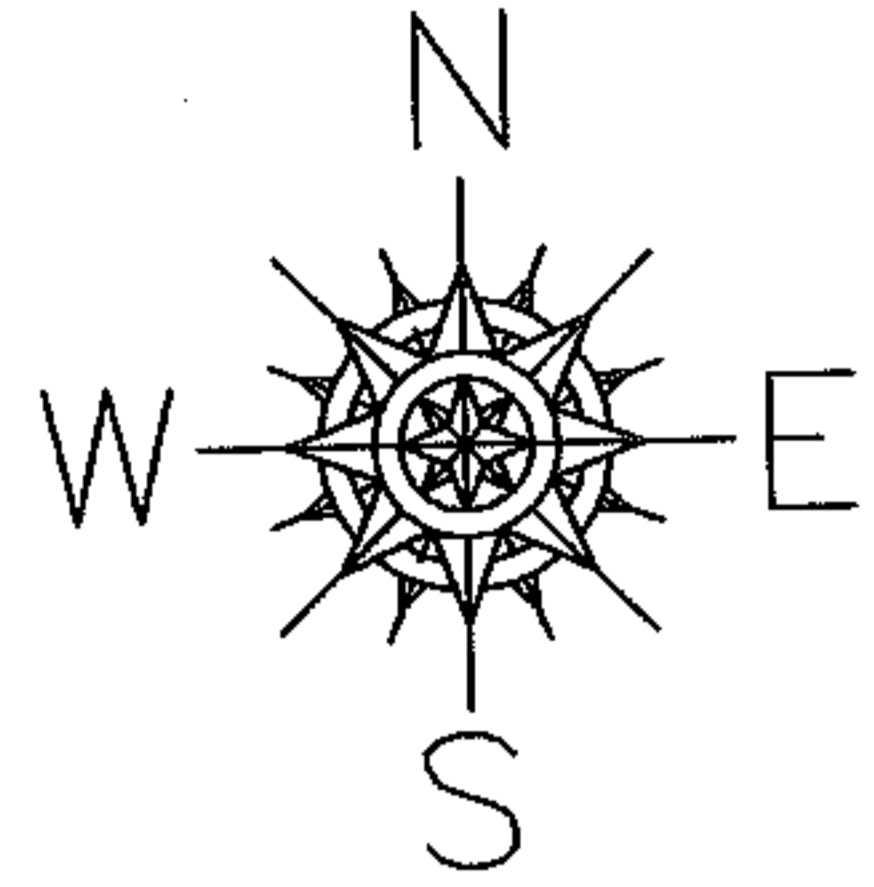

SPLITS/DEEDS PROCESSED
 LORAIN COUNTY TAX MAP DEPARTMENT
 226 MIDDLE AVE. ELYRIA, OHIO

SURVEYED BY: PETER C. ZWICK
 CLOSURE: 0.00 : 10.000
 MAP PAGE(S): 04-00-021-A
 APPROVED BY: JAH DATE: 3-9-04
 SCALE: 1" = 300 PRIOR INSTRUMENT: PL VOL 66/59