



RASTER

PARENT PARCEL: 15-00-001-000-003

CHILD PARCEL: 15-00-001-000-014, -015

STARTING POINT: CENTERLINE OF PARSONS RD. & NICKEL PLATE-DIAGONAL RD.

NO. 01611

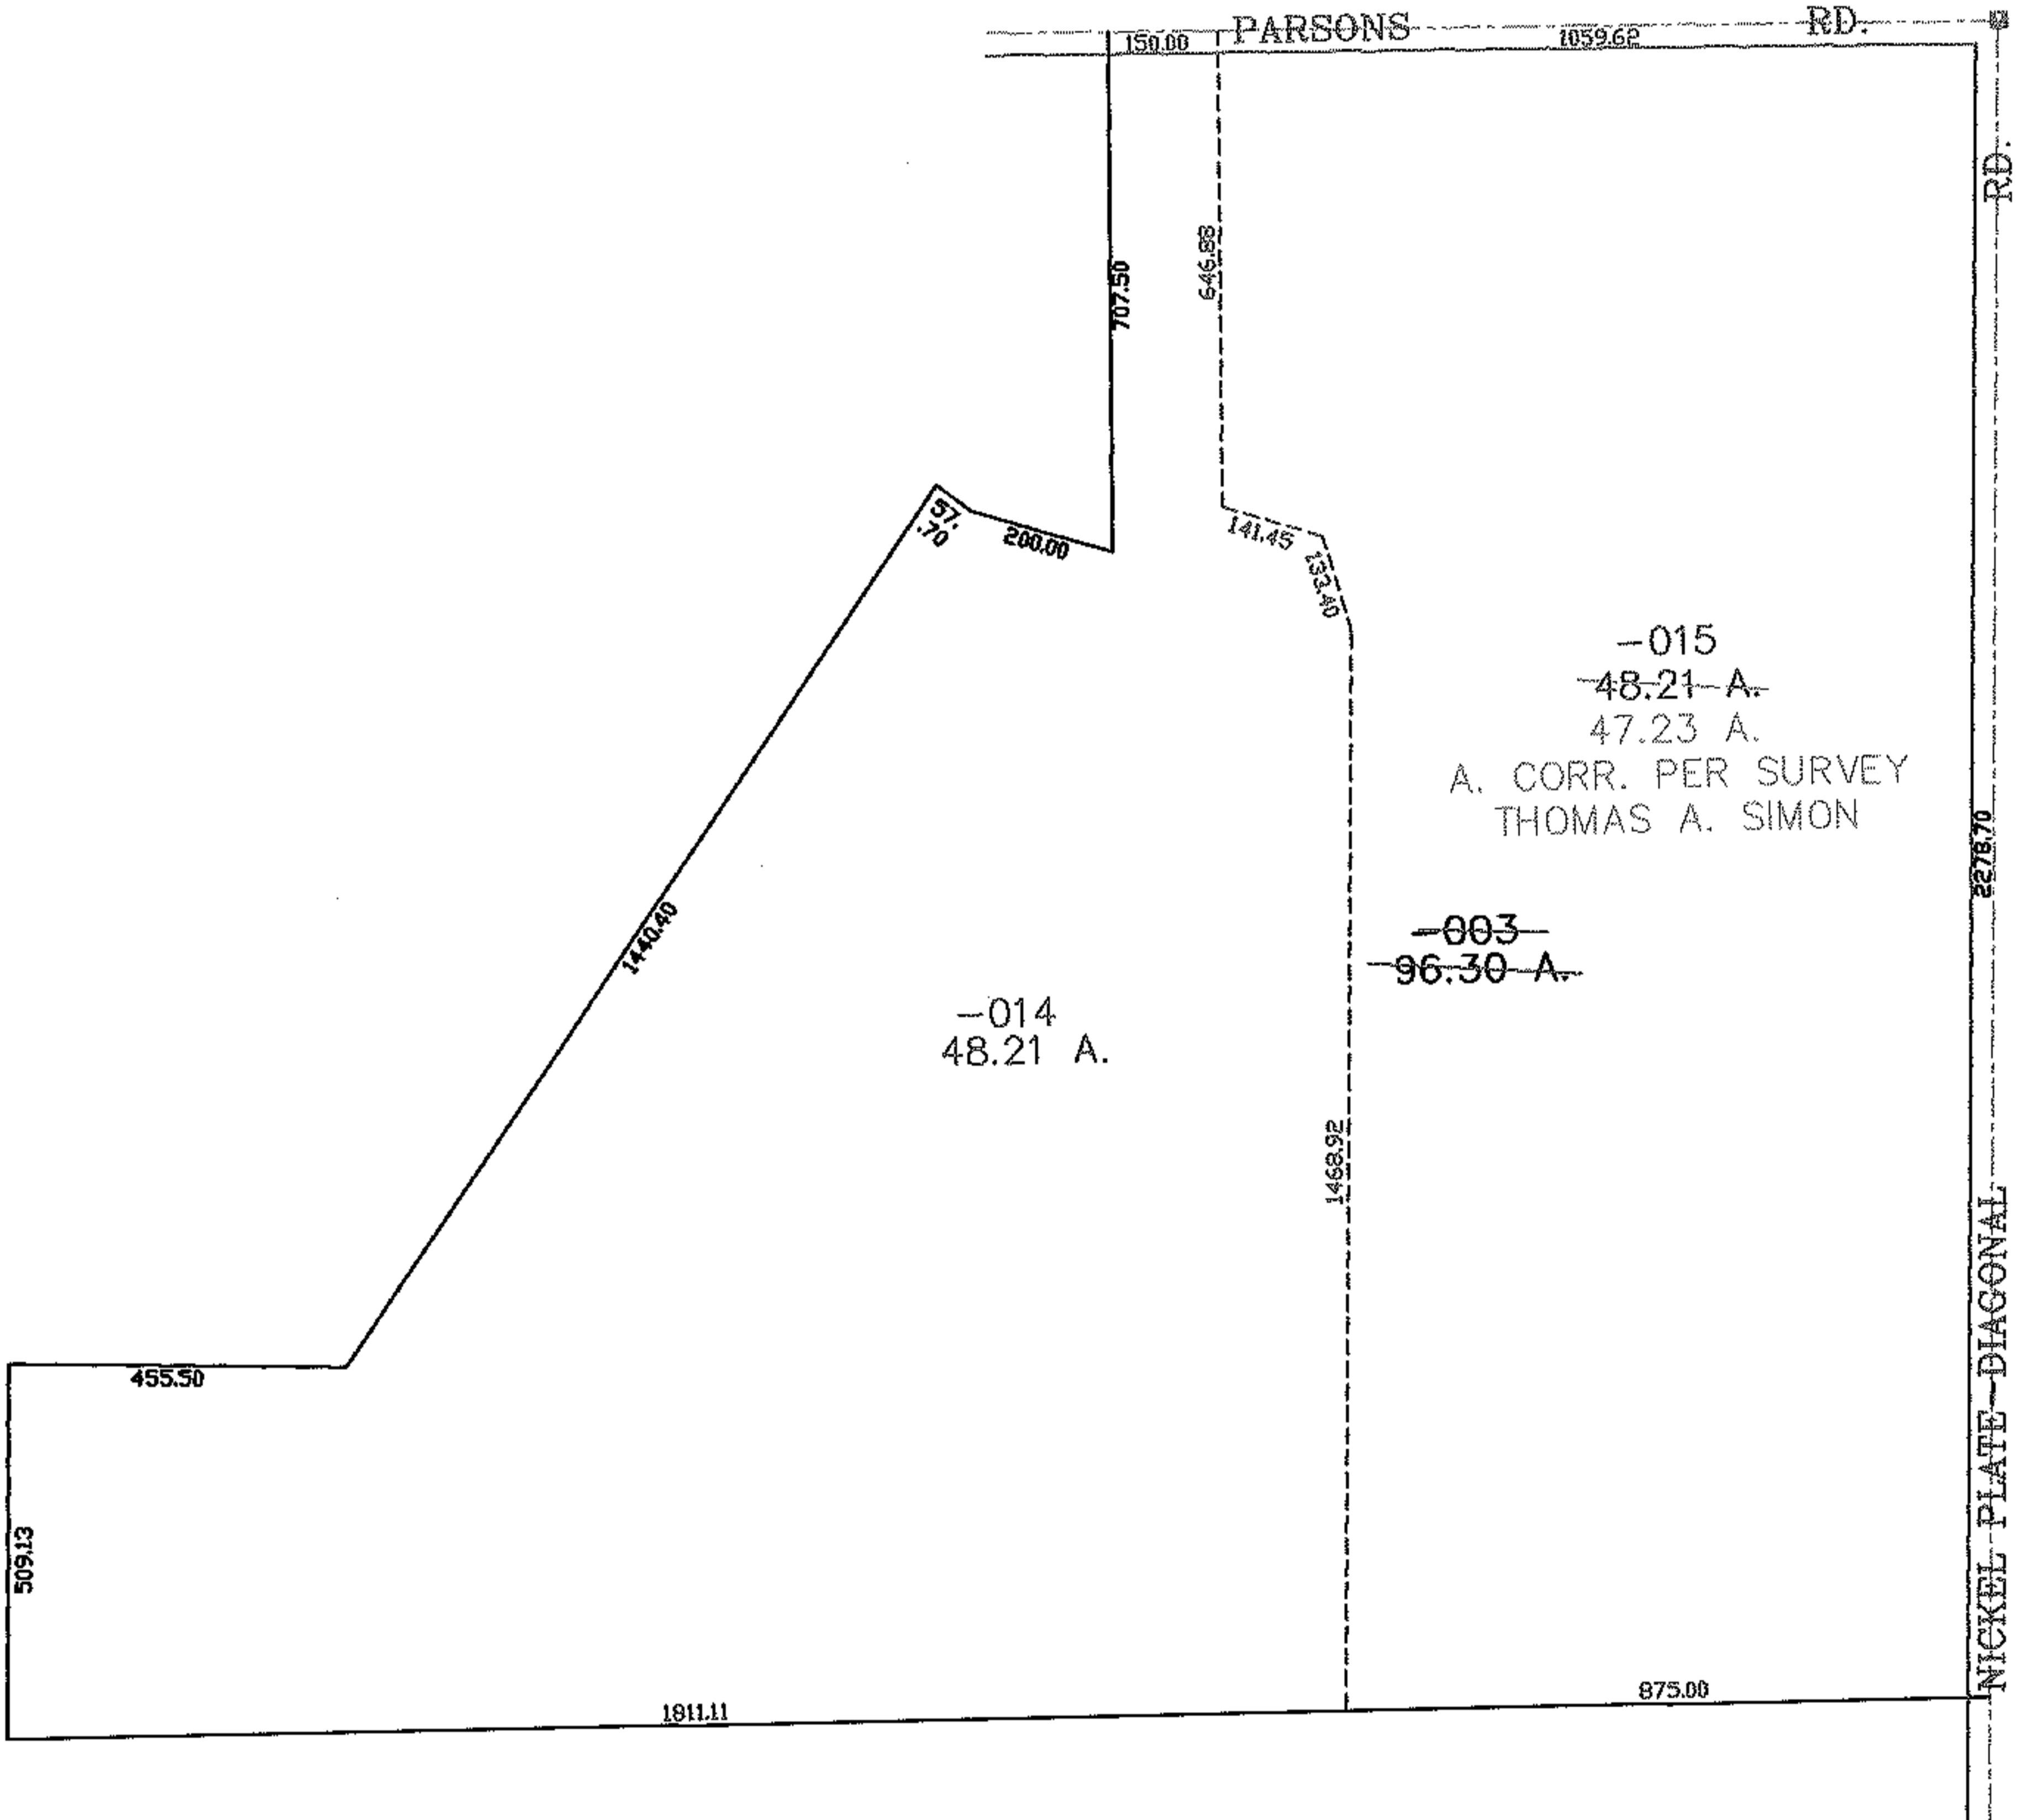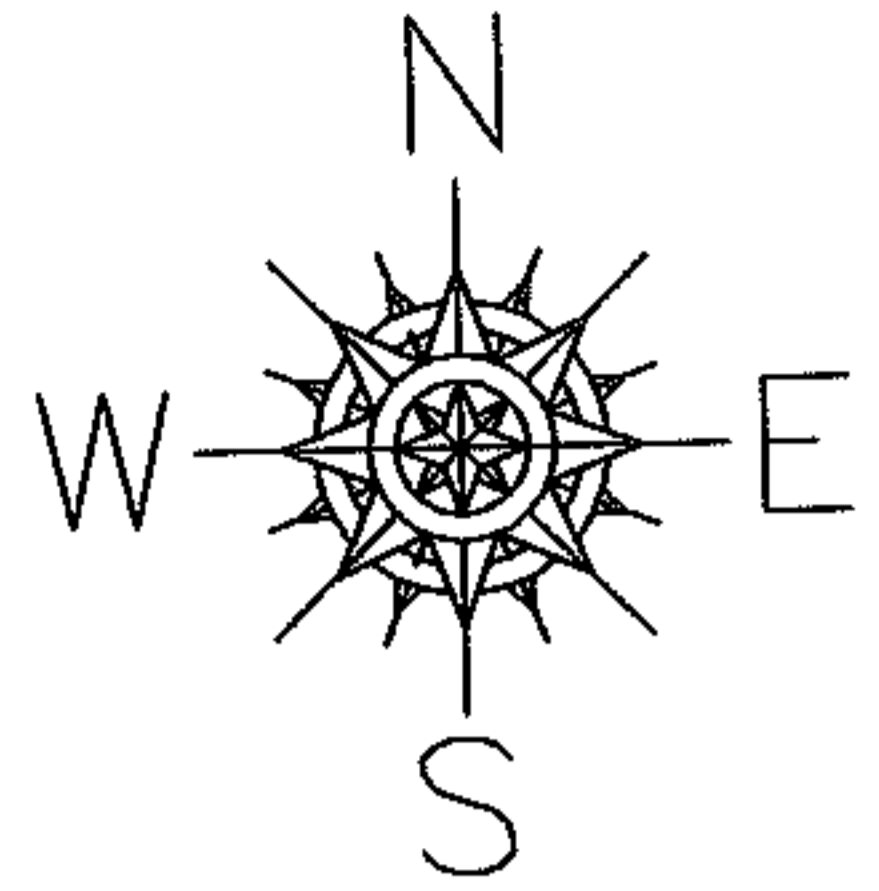

-015  
48.21 A.  
47.23 A.  
A. CORR. PER SURVEY  
THOMAS A. SIMON

-014  
48.21 A.

-003  
96.30 A.



**SPLITS/DEEDS PROCESSED**  
LORAIN COUNTY TAX MAP DEPARTMENT  
226 MIDDLE AVE. ELYRIA, OHIO

SURVEYED BY:	THOMAS A. SIMON
CLOSURE:	0.00 : 10.000
MAP PAGE(S):	15-00-001-B
APPROVED BY:	JAH DATE: 3-16-04
SCALE:	1" = 400 PRIOR INSTRUMENT: DV 470/435