
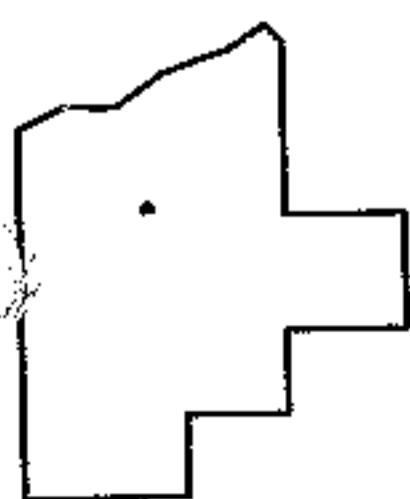
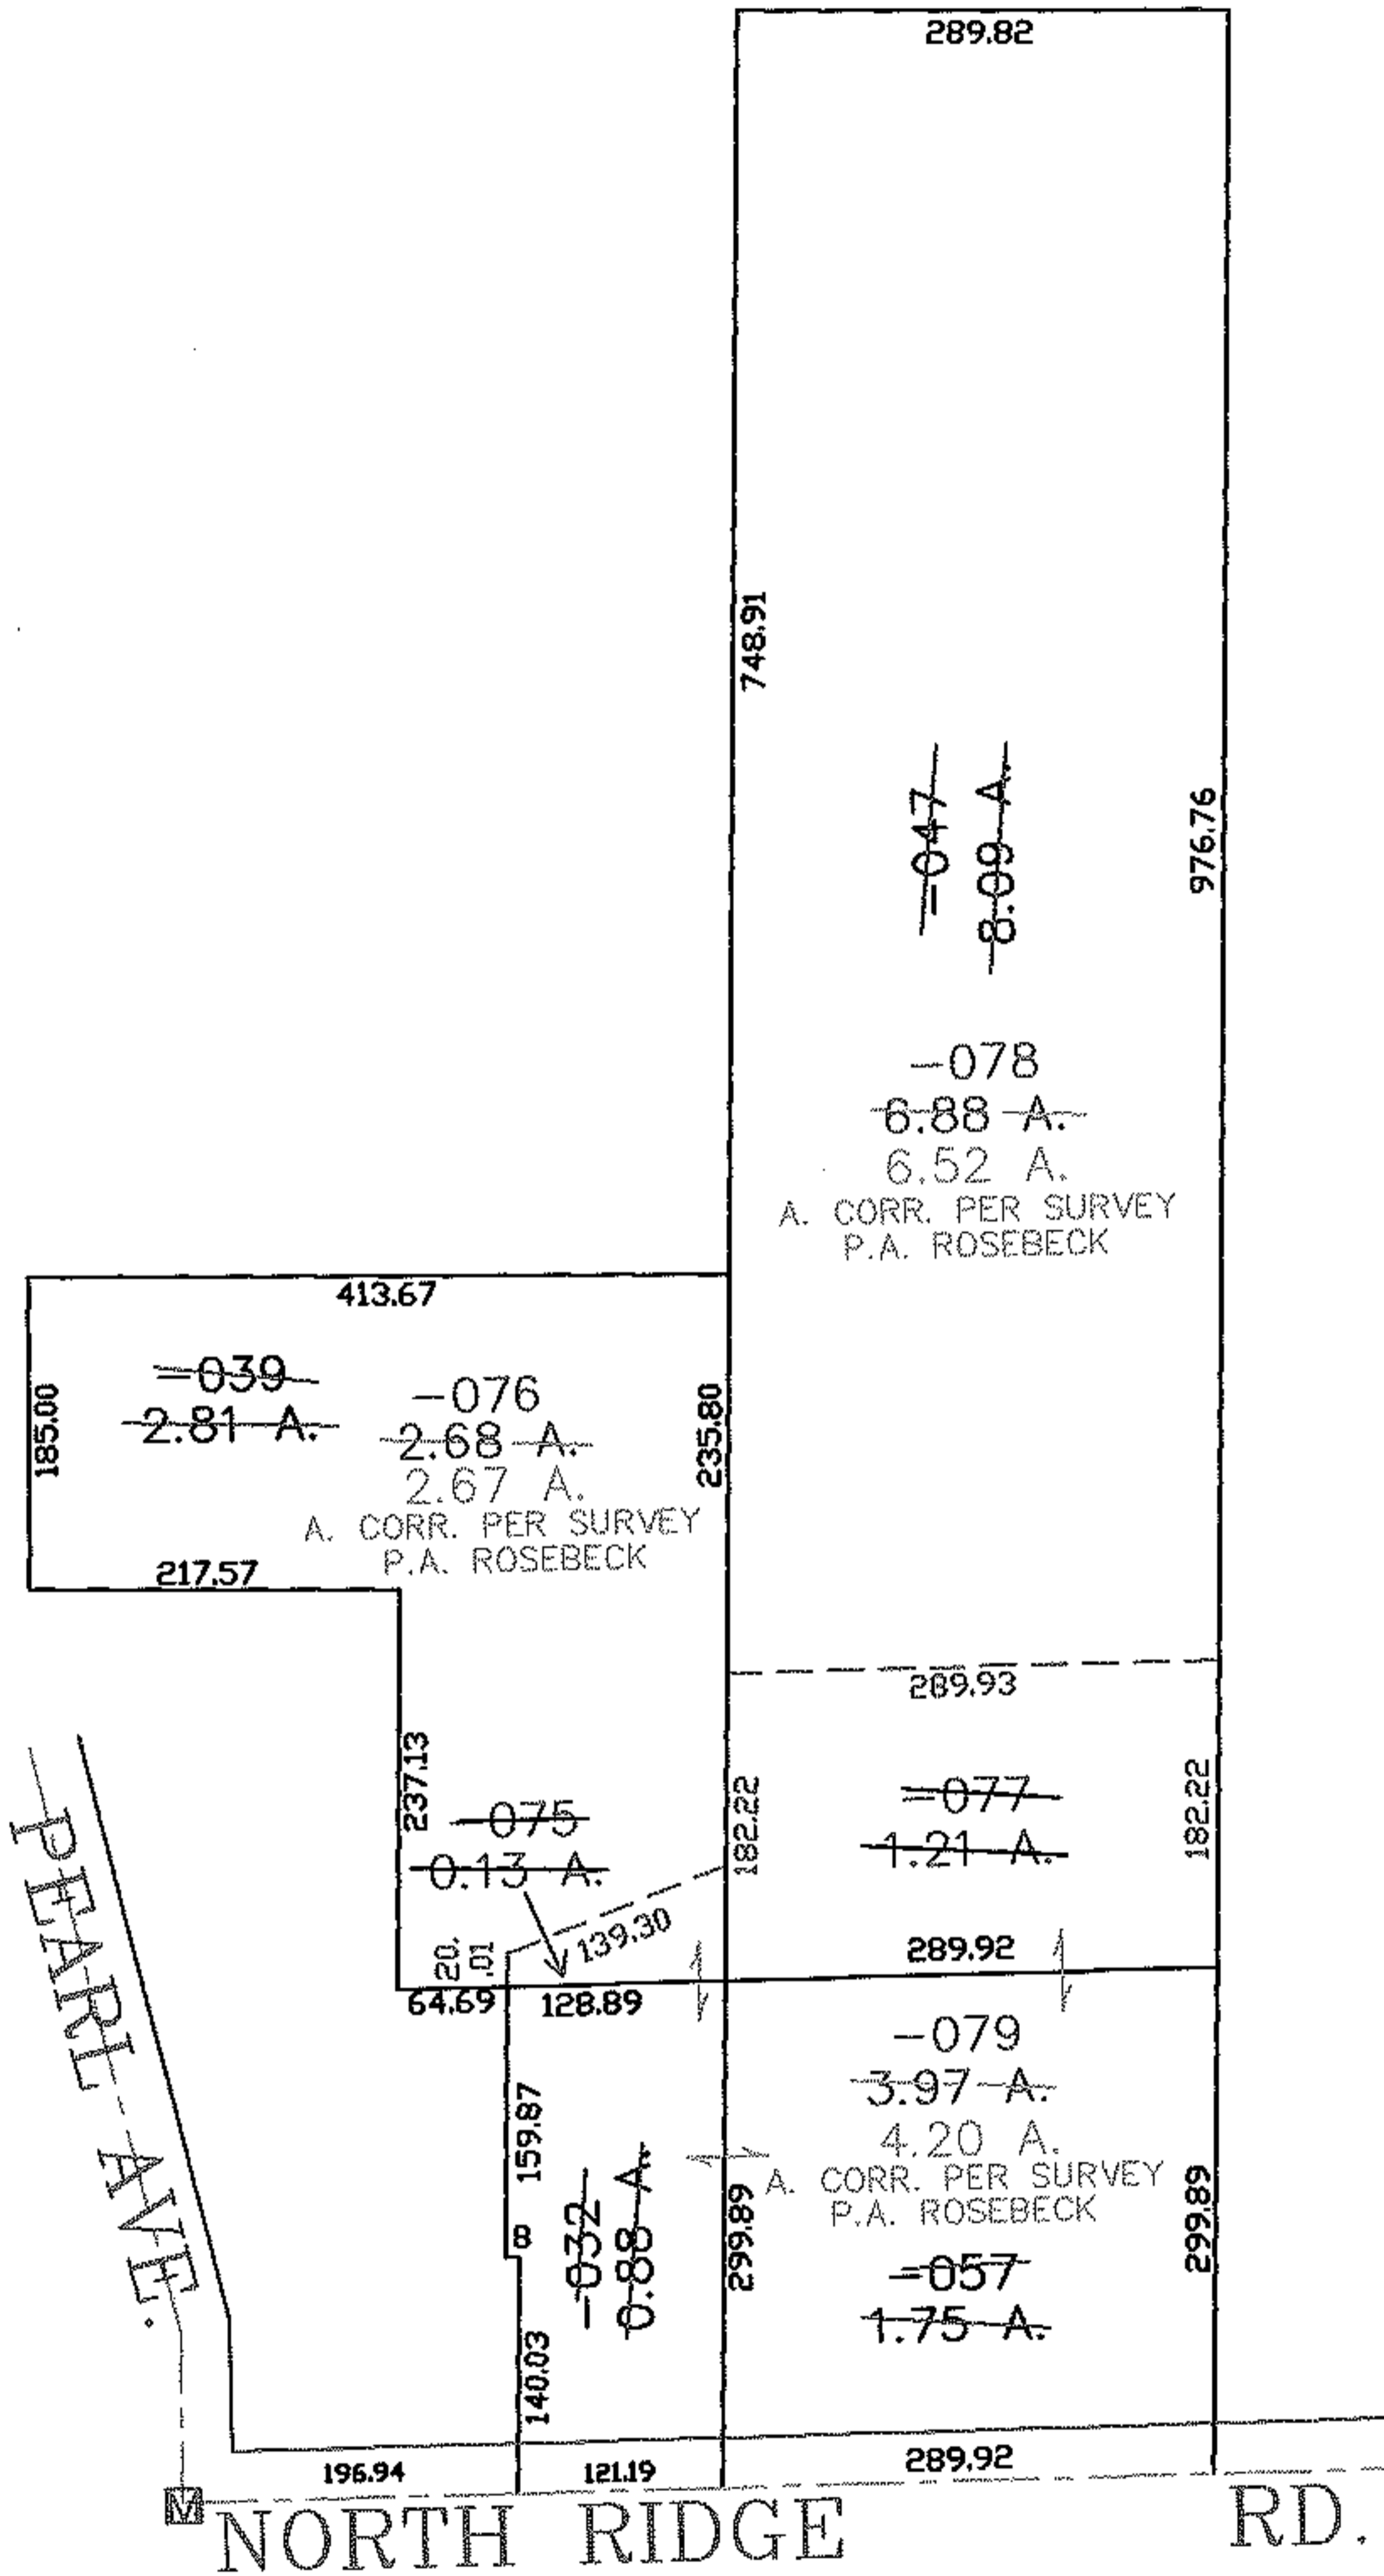


PARENT PARCEL: 03-00-110-105-039, -047, -032, -057

CHILD PARCEL: 03-00-110-105-075 THRU -079

STARTING POINT: CENTERLINE OF PEARL AVE. & NORTH RIDGE RD.

NO. 01612

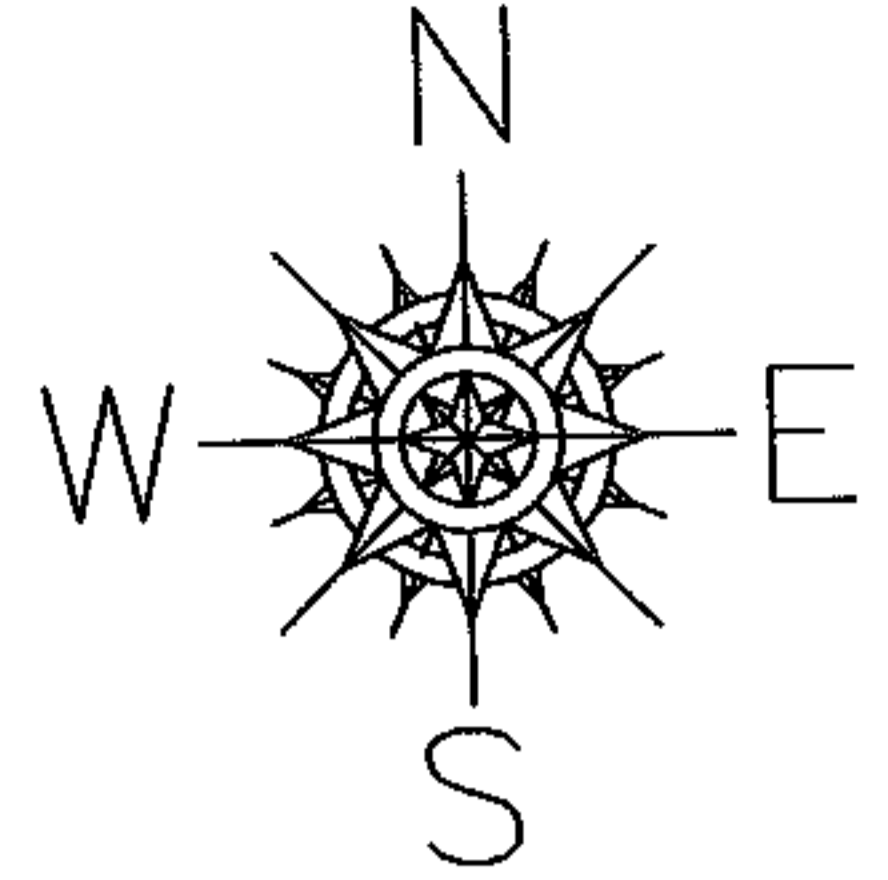

SPLITS/DEEDS PROCESSED
 LORAIN COUNTY TAX MAP DEPARTMENT
 226 MIDDLE AVE. ELYRIA, OHIO

SURVEYED BY: PHILIP A. ROSEBECK
 CLOSURE: 0.00 : 10.000
 MAP PAGE(S): 03-00-110-A
 APPROVED BY: JAH DATE: 3-17-04
 SCALE: 1" = 200 PRIOR INSTRUMENT: DV XXXX/XXX