


PASTER

PARENT PARCEL: 01-00-003-139-036


CHILD PARCEL: 01-00-003-139-040 THRU -044

STARTING POINT: NORTHEAST CORNER OF S/L 4 IN NATURE'S PRESERVE SUBD.

NO. 01613

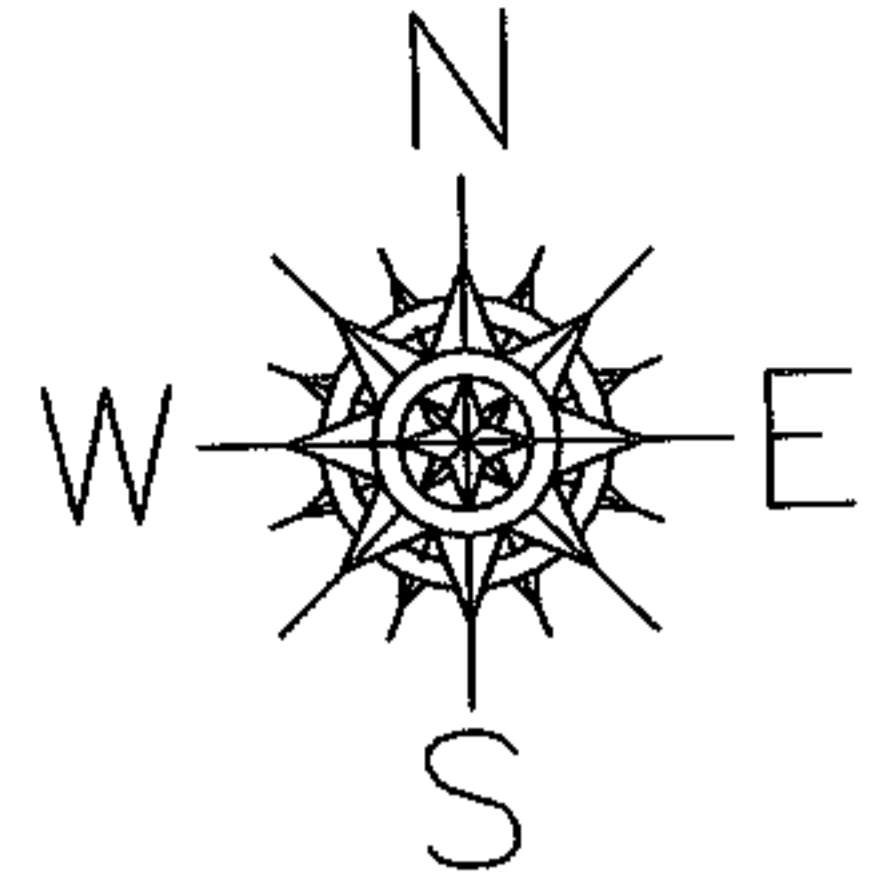

~~-036~~  
~~58.48 A.~~  
-044  
58.22 A.

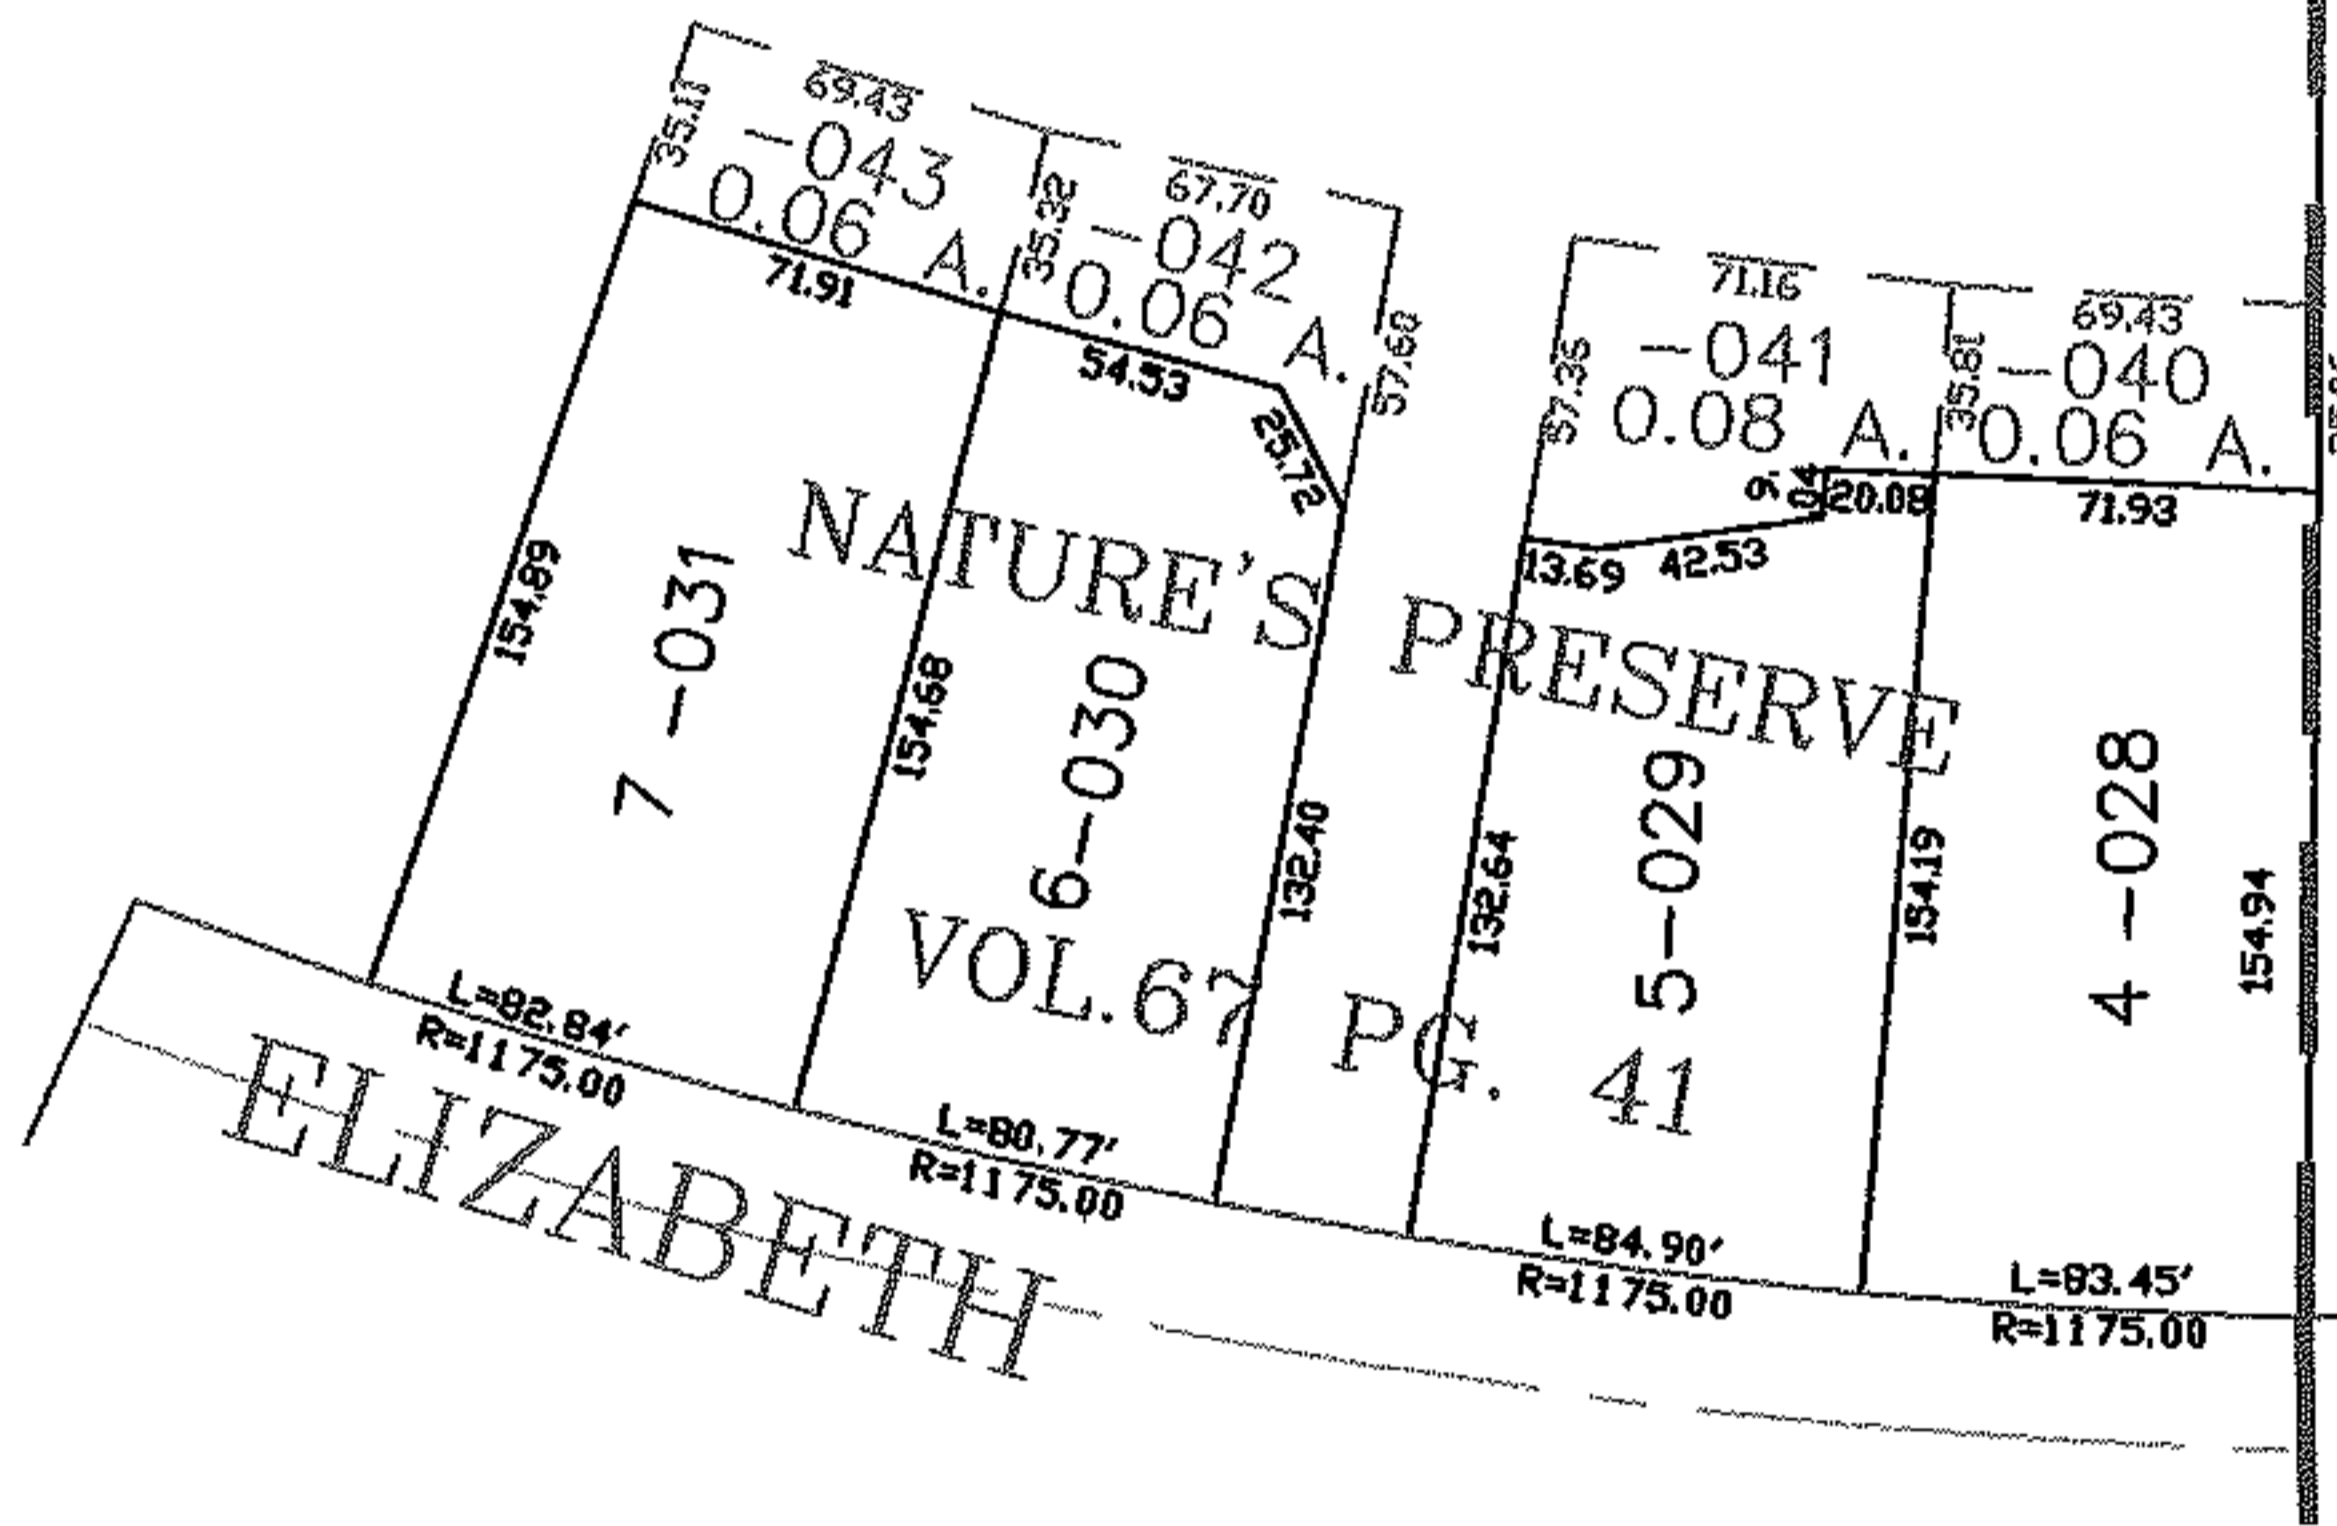

SPLITS/DEEDS PROCESSED

LORAIN COUNTY TAX MAP DEPARTMENT  
226 MIDDLE AVE. ELYRIA, OHIO

SURVEYED BY: CARL R. ANDERSON

CLOSURE: 0.00 : 10.000

MAP PAGE(S): 01-00-003-C

APPROVED BY: JAH DATE: 3-19-04

SCALE: 1" = 100 PRIOR INSTRUMENT: 20000723771