



RASTER

PARENT PARCEL: 09-00-058-000-028

CHILD PARCEL: 09-00-058-000-029, -030

STARTING POINT: CENTERLINE OF BUTTERNUT RIDGE RD. & OBERLIN RD.

NO. 01614

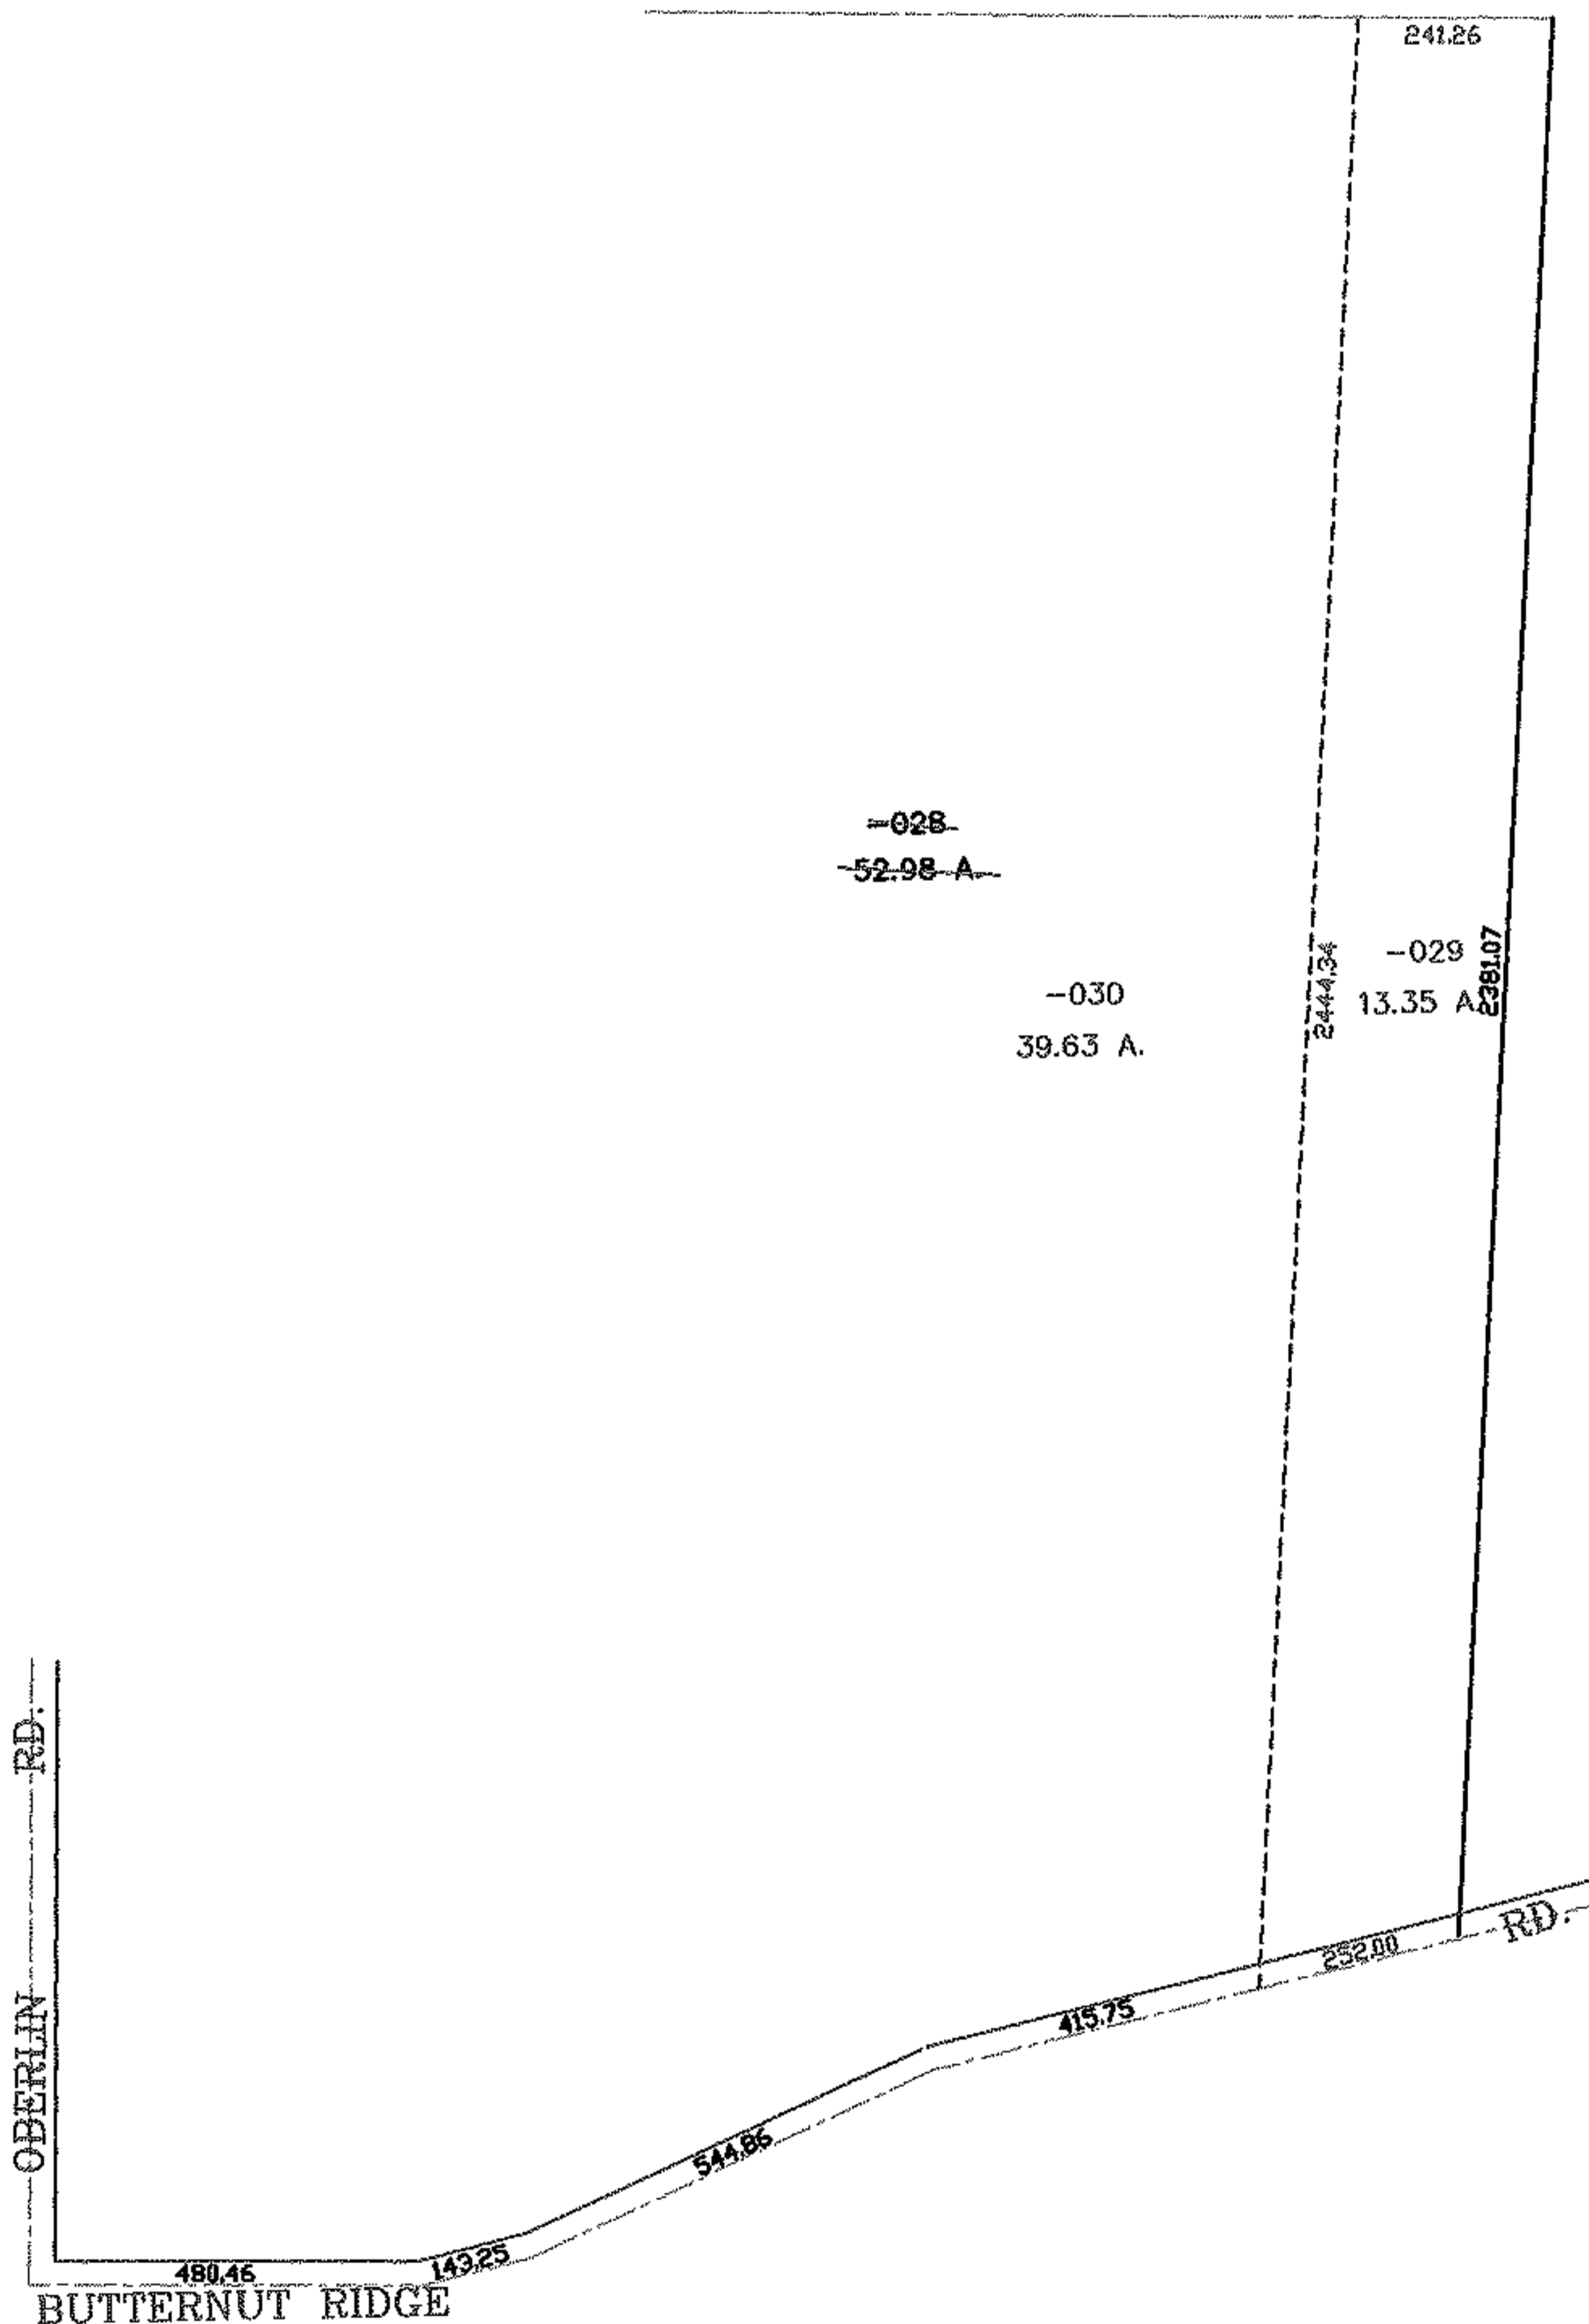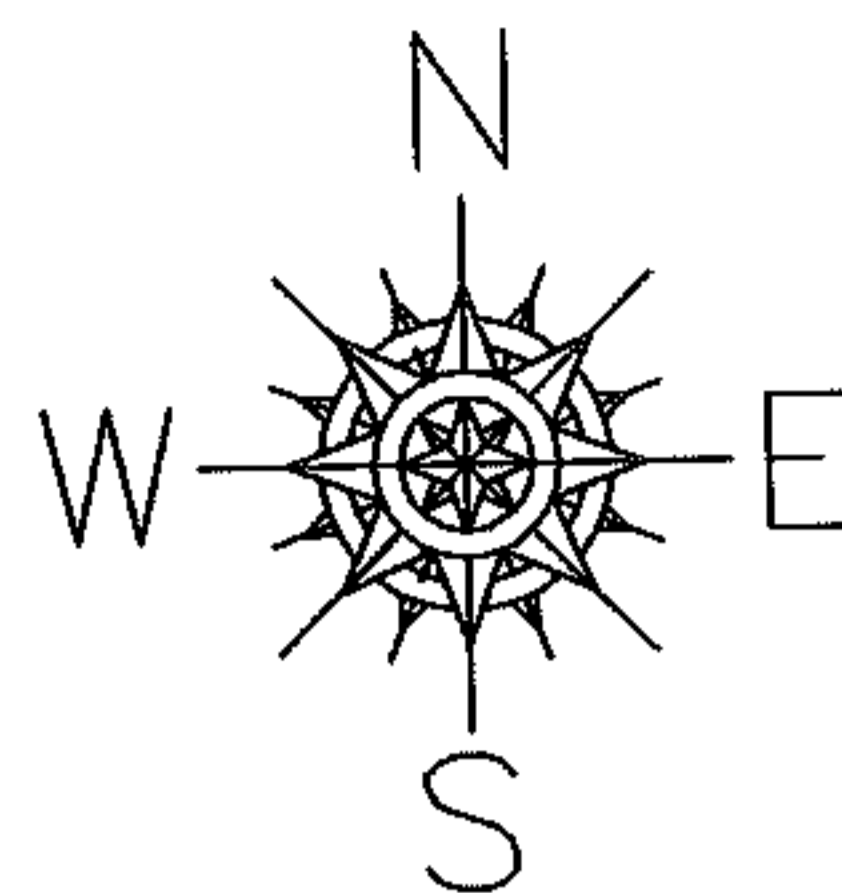

SURVEYED BY: RICHARD D. CARLSON

CLOSURE: 0.00 : 10.000

MAP PAGE(S): 9-00-058-A

APPROVED BY: JAH DATE: 3-17-04

SCALE: 1" = 400 PRIOR INSTRUMENT: 2002081790

SPLITS/DEEDS PROCESSED

LORAIN COUNTY TAX MAP DEPARTMENT
226 MIDDLE AVE. ELYRIA, OHIO

