


PARENT PARCEL: 10-00-018-101-026


CHILD PARCEL: 10-00-018-101-093, -094, -095, 10-00-019-000-117

STARTING POINT: S.E. CORNER OF S/L 14, IN CARLISLE WOODS SUB.

NO. 01615

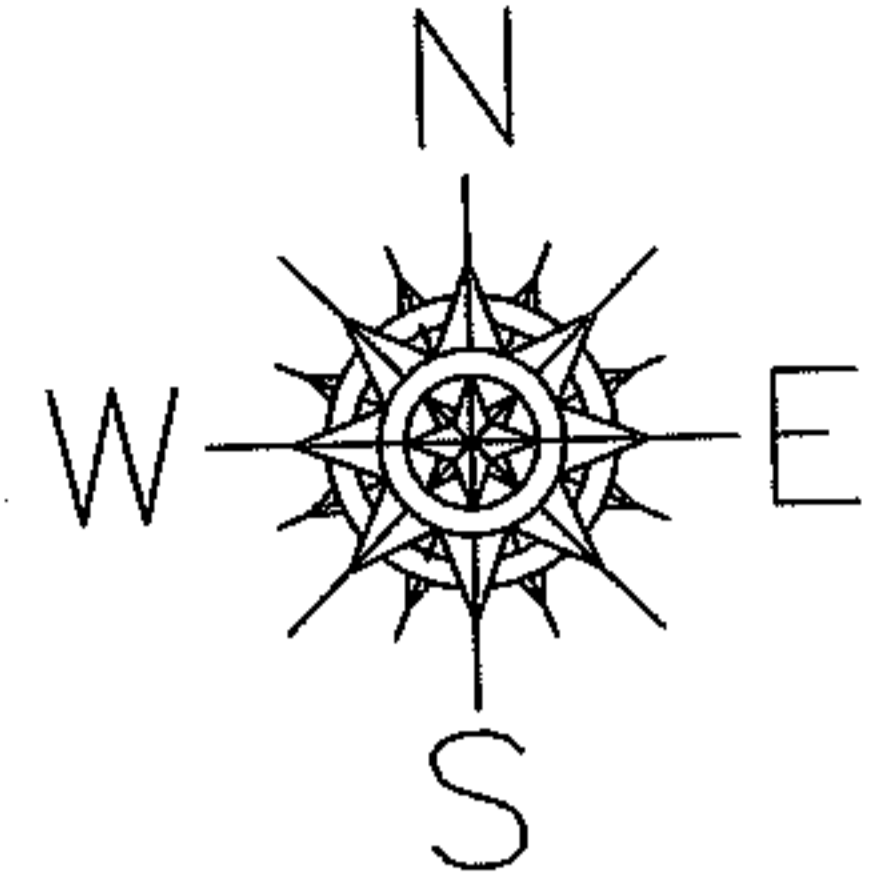

CARLISLE WOODS
V. 58 PG. 58-60

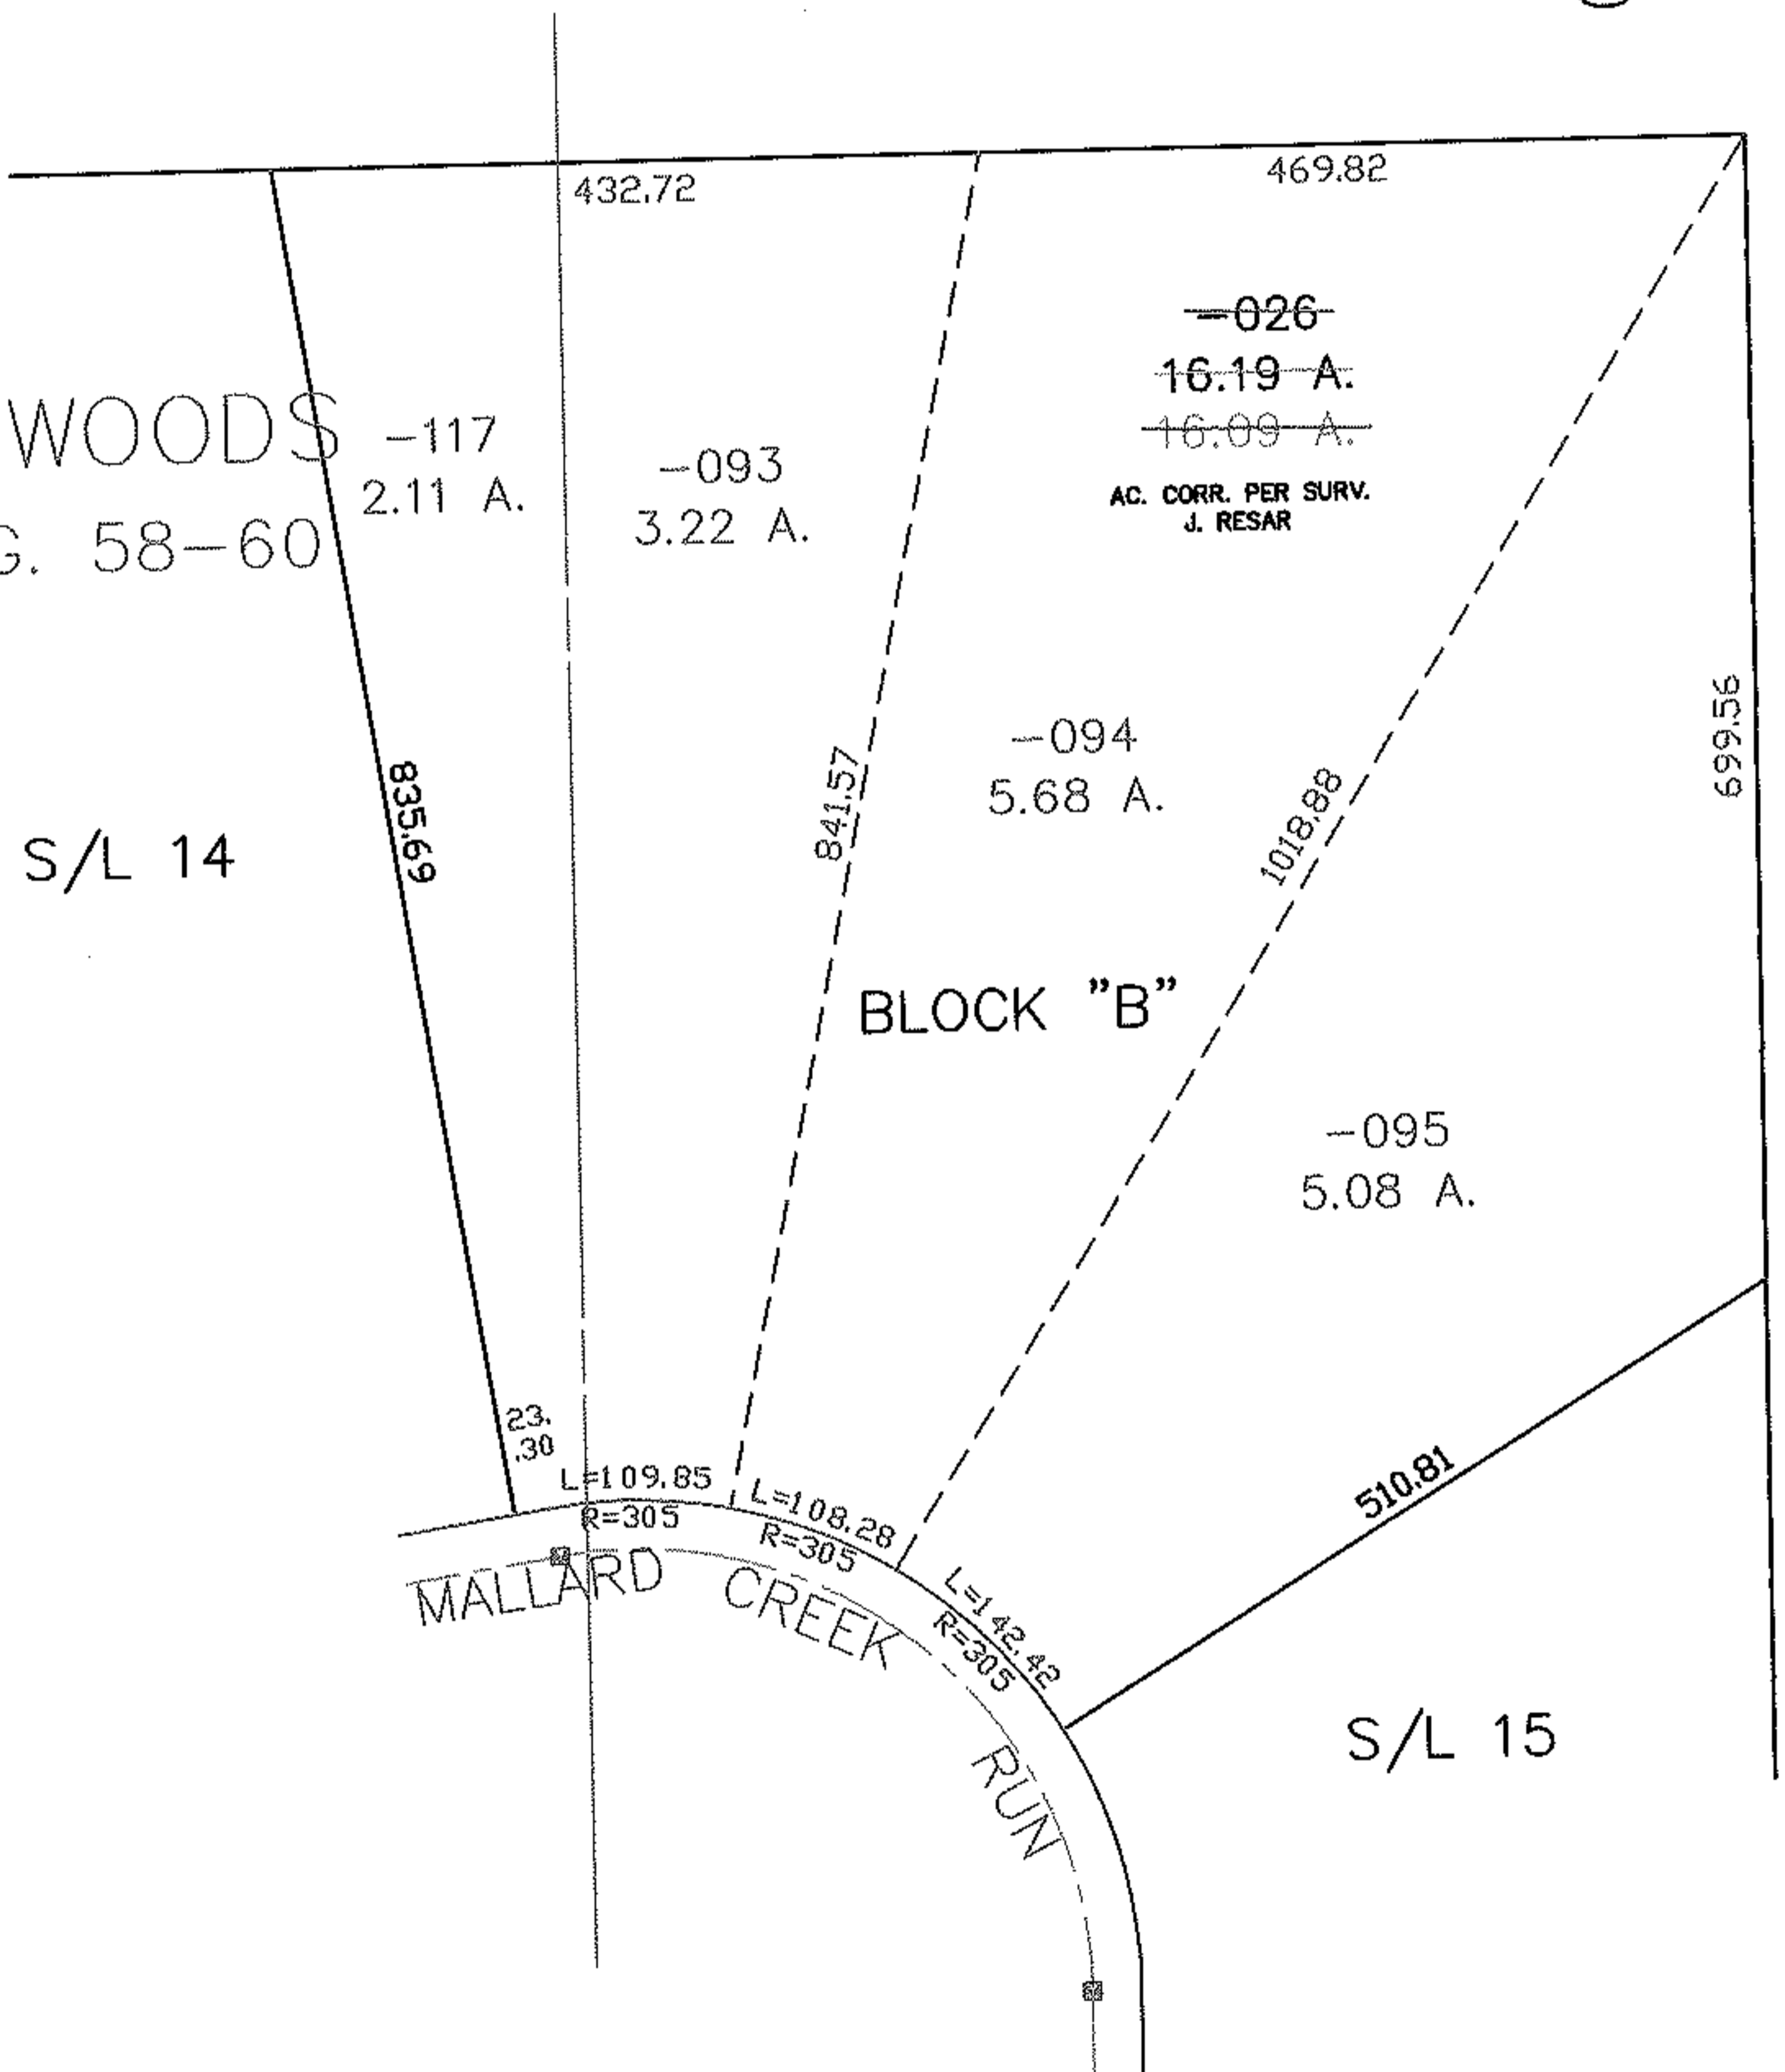

PRIOR INSTRUMENT: PV. 58 PG. 58-60

SURVEYED BY: JAMES A. RESAR
CLOSURE: 0.01 : 10.000
MAP PAGE(S): 10-00-018-A
APPROVED BY: IJS DATE: 4/02/04
SCALE: 1" = 200

SPLITS/DEEDS PROCESSED
LORAIN COUNTY TAX MAP DEPARTMENT
226 MIDDLE AVE. ELYRIA, OHIO

