



RASTER

PARENT PARCEL: 04-00-022-102-015

CHILD PARCEL: 04-00-022-102-069, -070

STARTING POINT: CENTERLINE OF DETROIT RD. & LEAR NAGLE RD.

NO. 01618

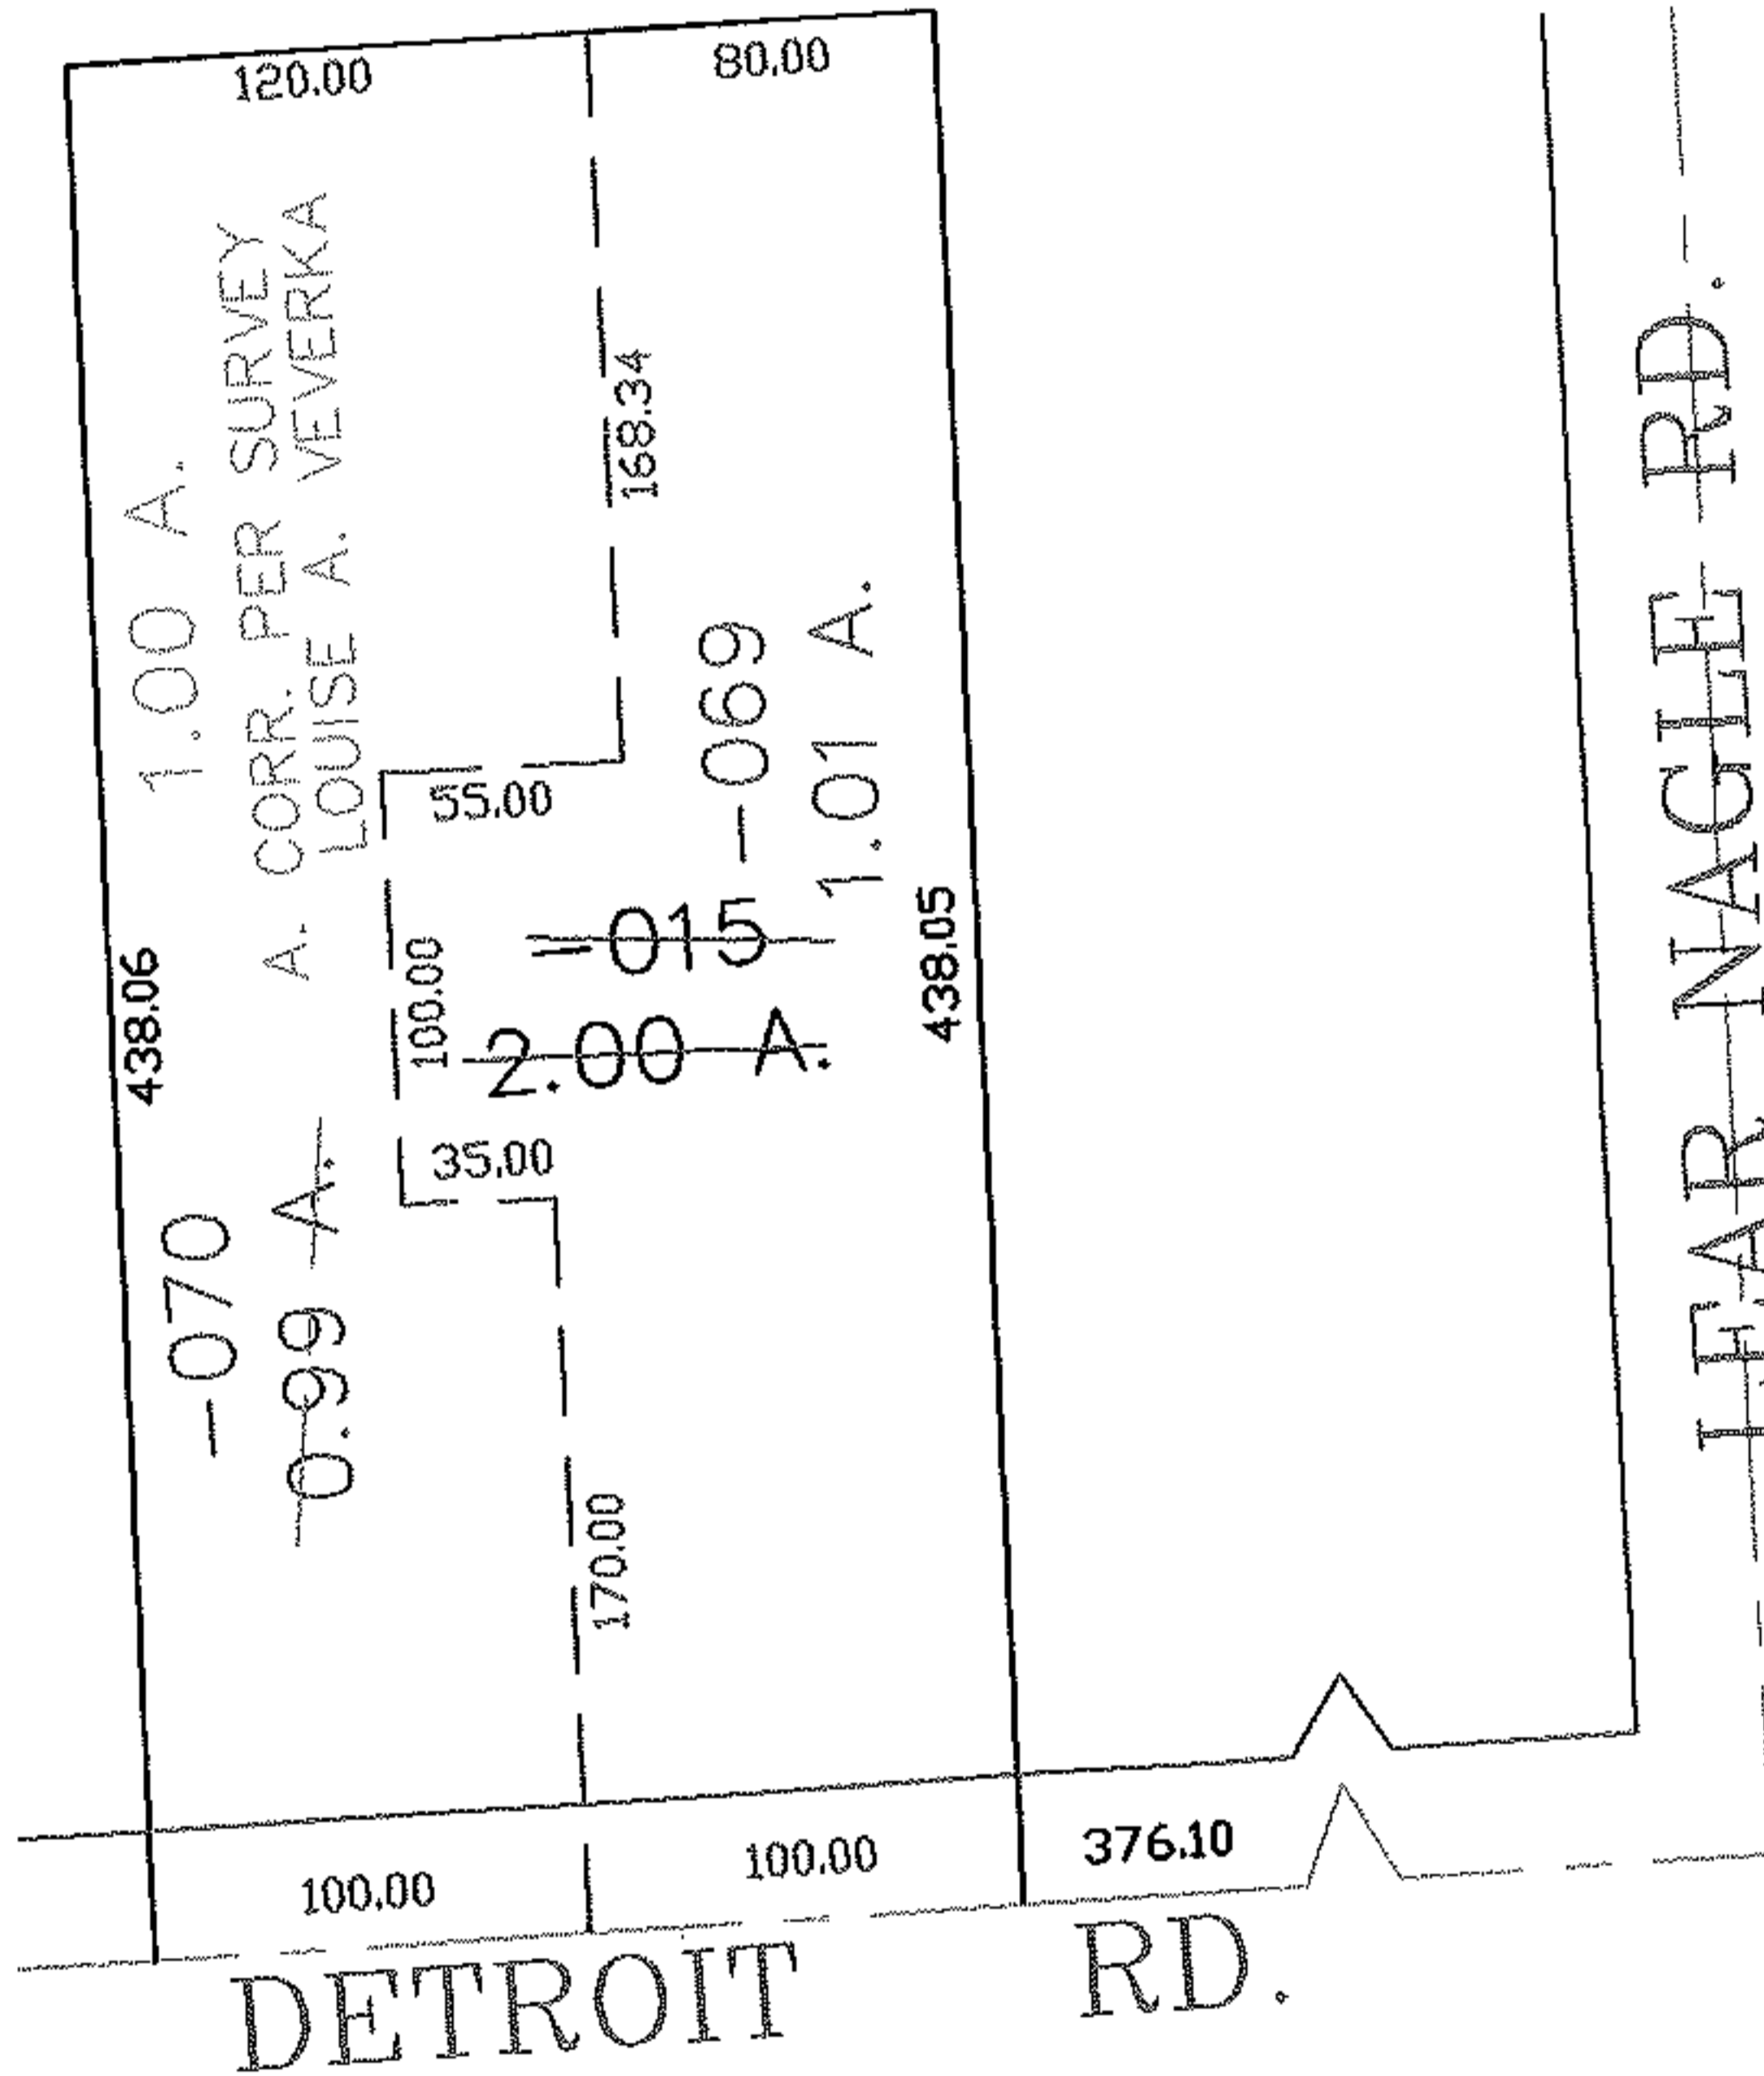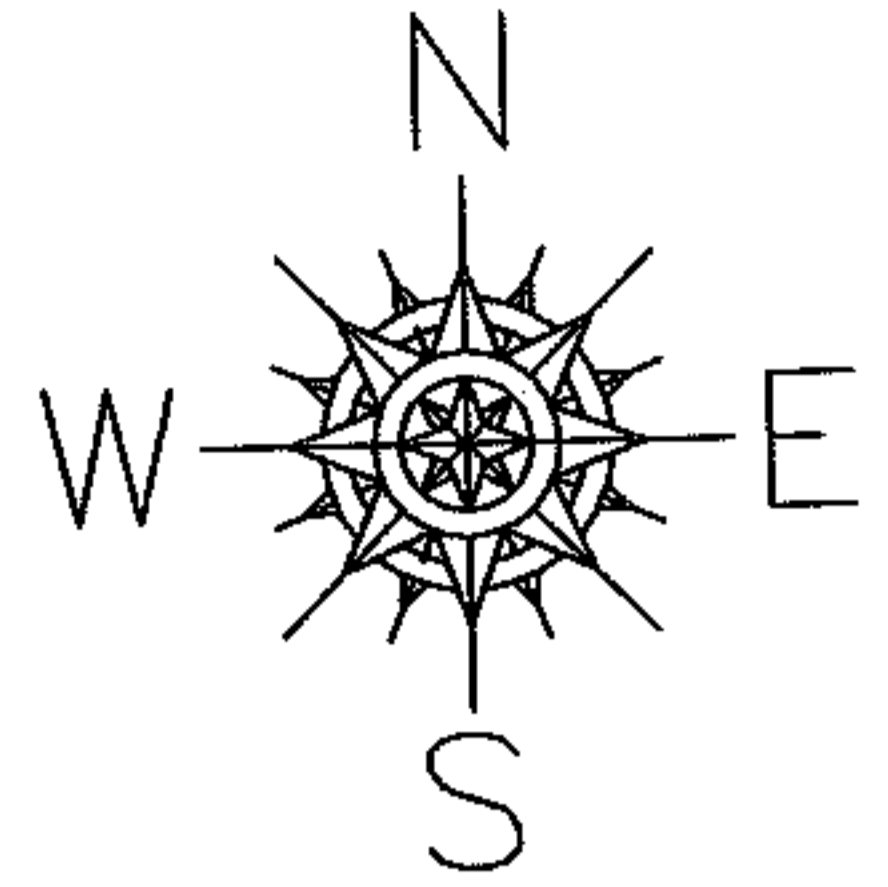

SPLITS/DEEDS PROCESSED

LORAIN COUNTY TAX MAP DEPARTMENT  
226 MIDDLE AVE. ELYRIA, OHIO

SURVEYED BY: LOUISE A. VEVERKA

CLOSURE: 0.00 : 10.000

MAP PAGE(S): 4-00-022-H

APPROVED BY: JAH DATE: 3-24-04

SCALE: 1" = 100 PRIOR INSTRUMENT: 20010767025