
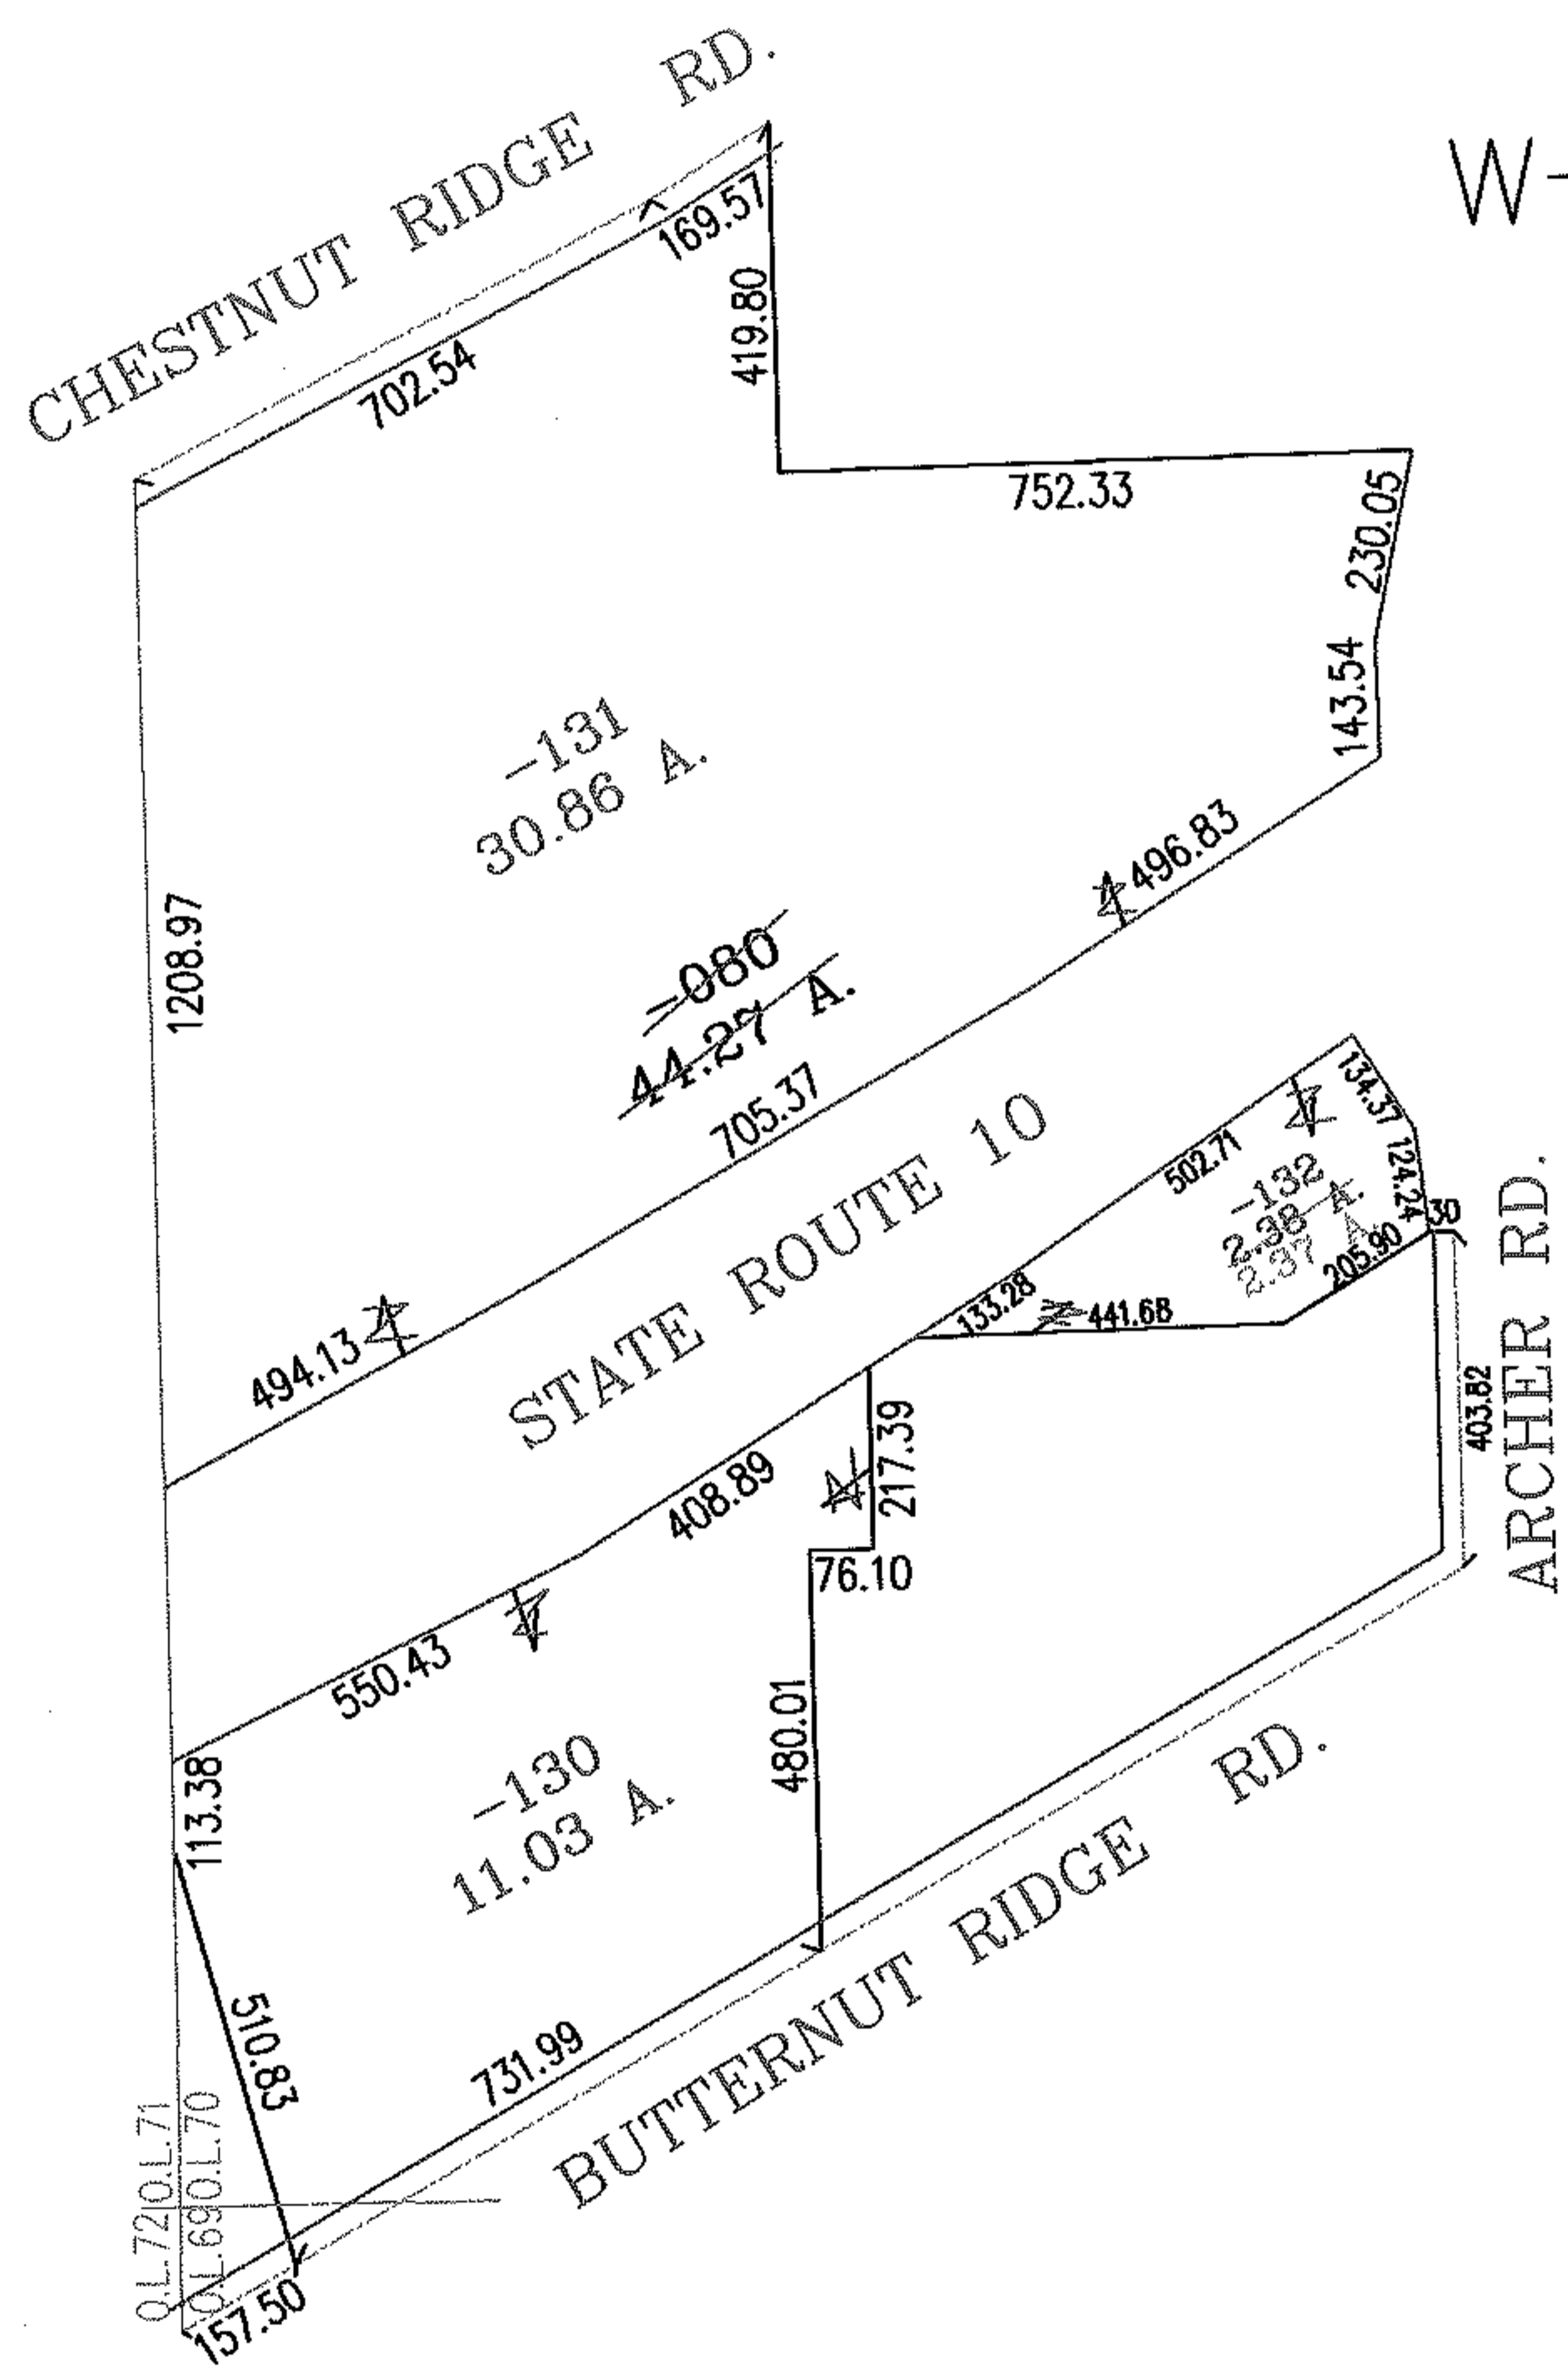


RASTER

NO. 01621

PARENT PARCEL: 11-00-070-000-080
CHILD PARCEL: 11-00-070-000-130 THRU -132
STARTING POINT: INTERSECTION WEST LINE O.L. 70 AND C/L OF BUTTERNUT RIDGE RD.

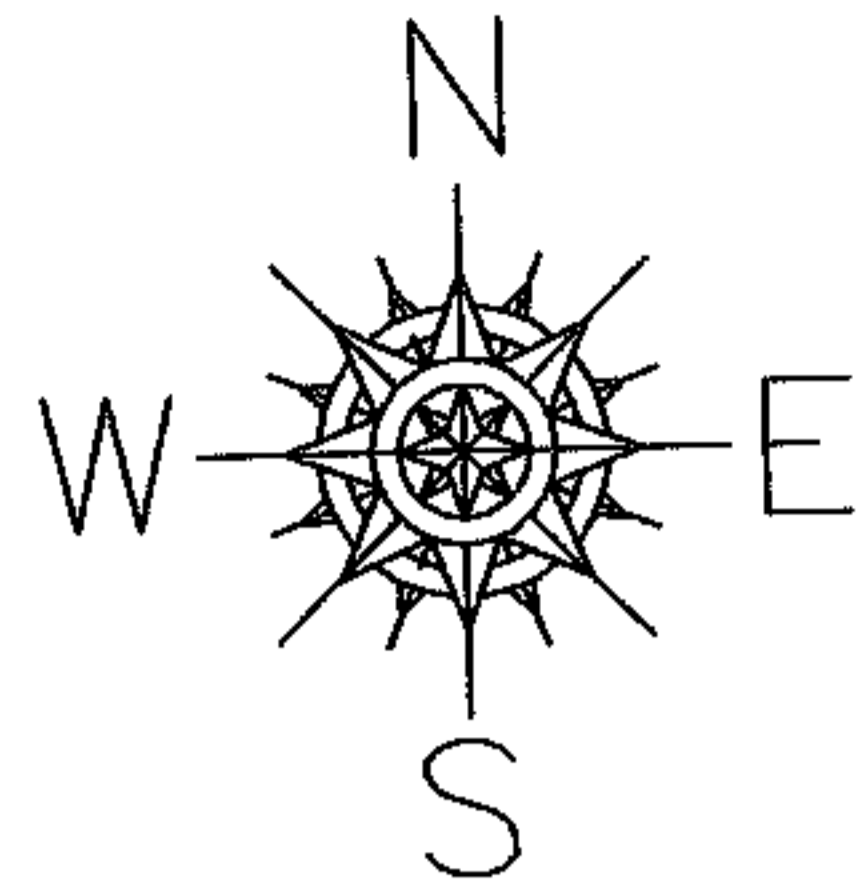

SPLITS/DEEDS PROCESSED
LORAIN COUNTY TAX MAP DEPARTMENT
226 MIDDLE AVE. ELYRIA, OHIO

SURVEYED BY: MARK ALLEN YEAGER
CLOSURE: .01:10.000
MAP PAGE(S): 11-00-070-A&B
APPROVED BY: RRM DATE: 3-30-04
SCALE: 1" = 400 PRIOR INSTRUMENT: 20030972204