



MASTER

PARENT PARCEL: 11-00-070-000-080

CHILD PARCEL: 11-00-070-000-130 THRU -132

STARTING POINT: INTERSECTION WEST LINE O.L. 70 AND C/L OF BUTTERNUT RIDGE RD.

NO. 01621

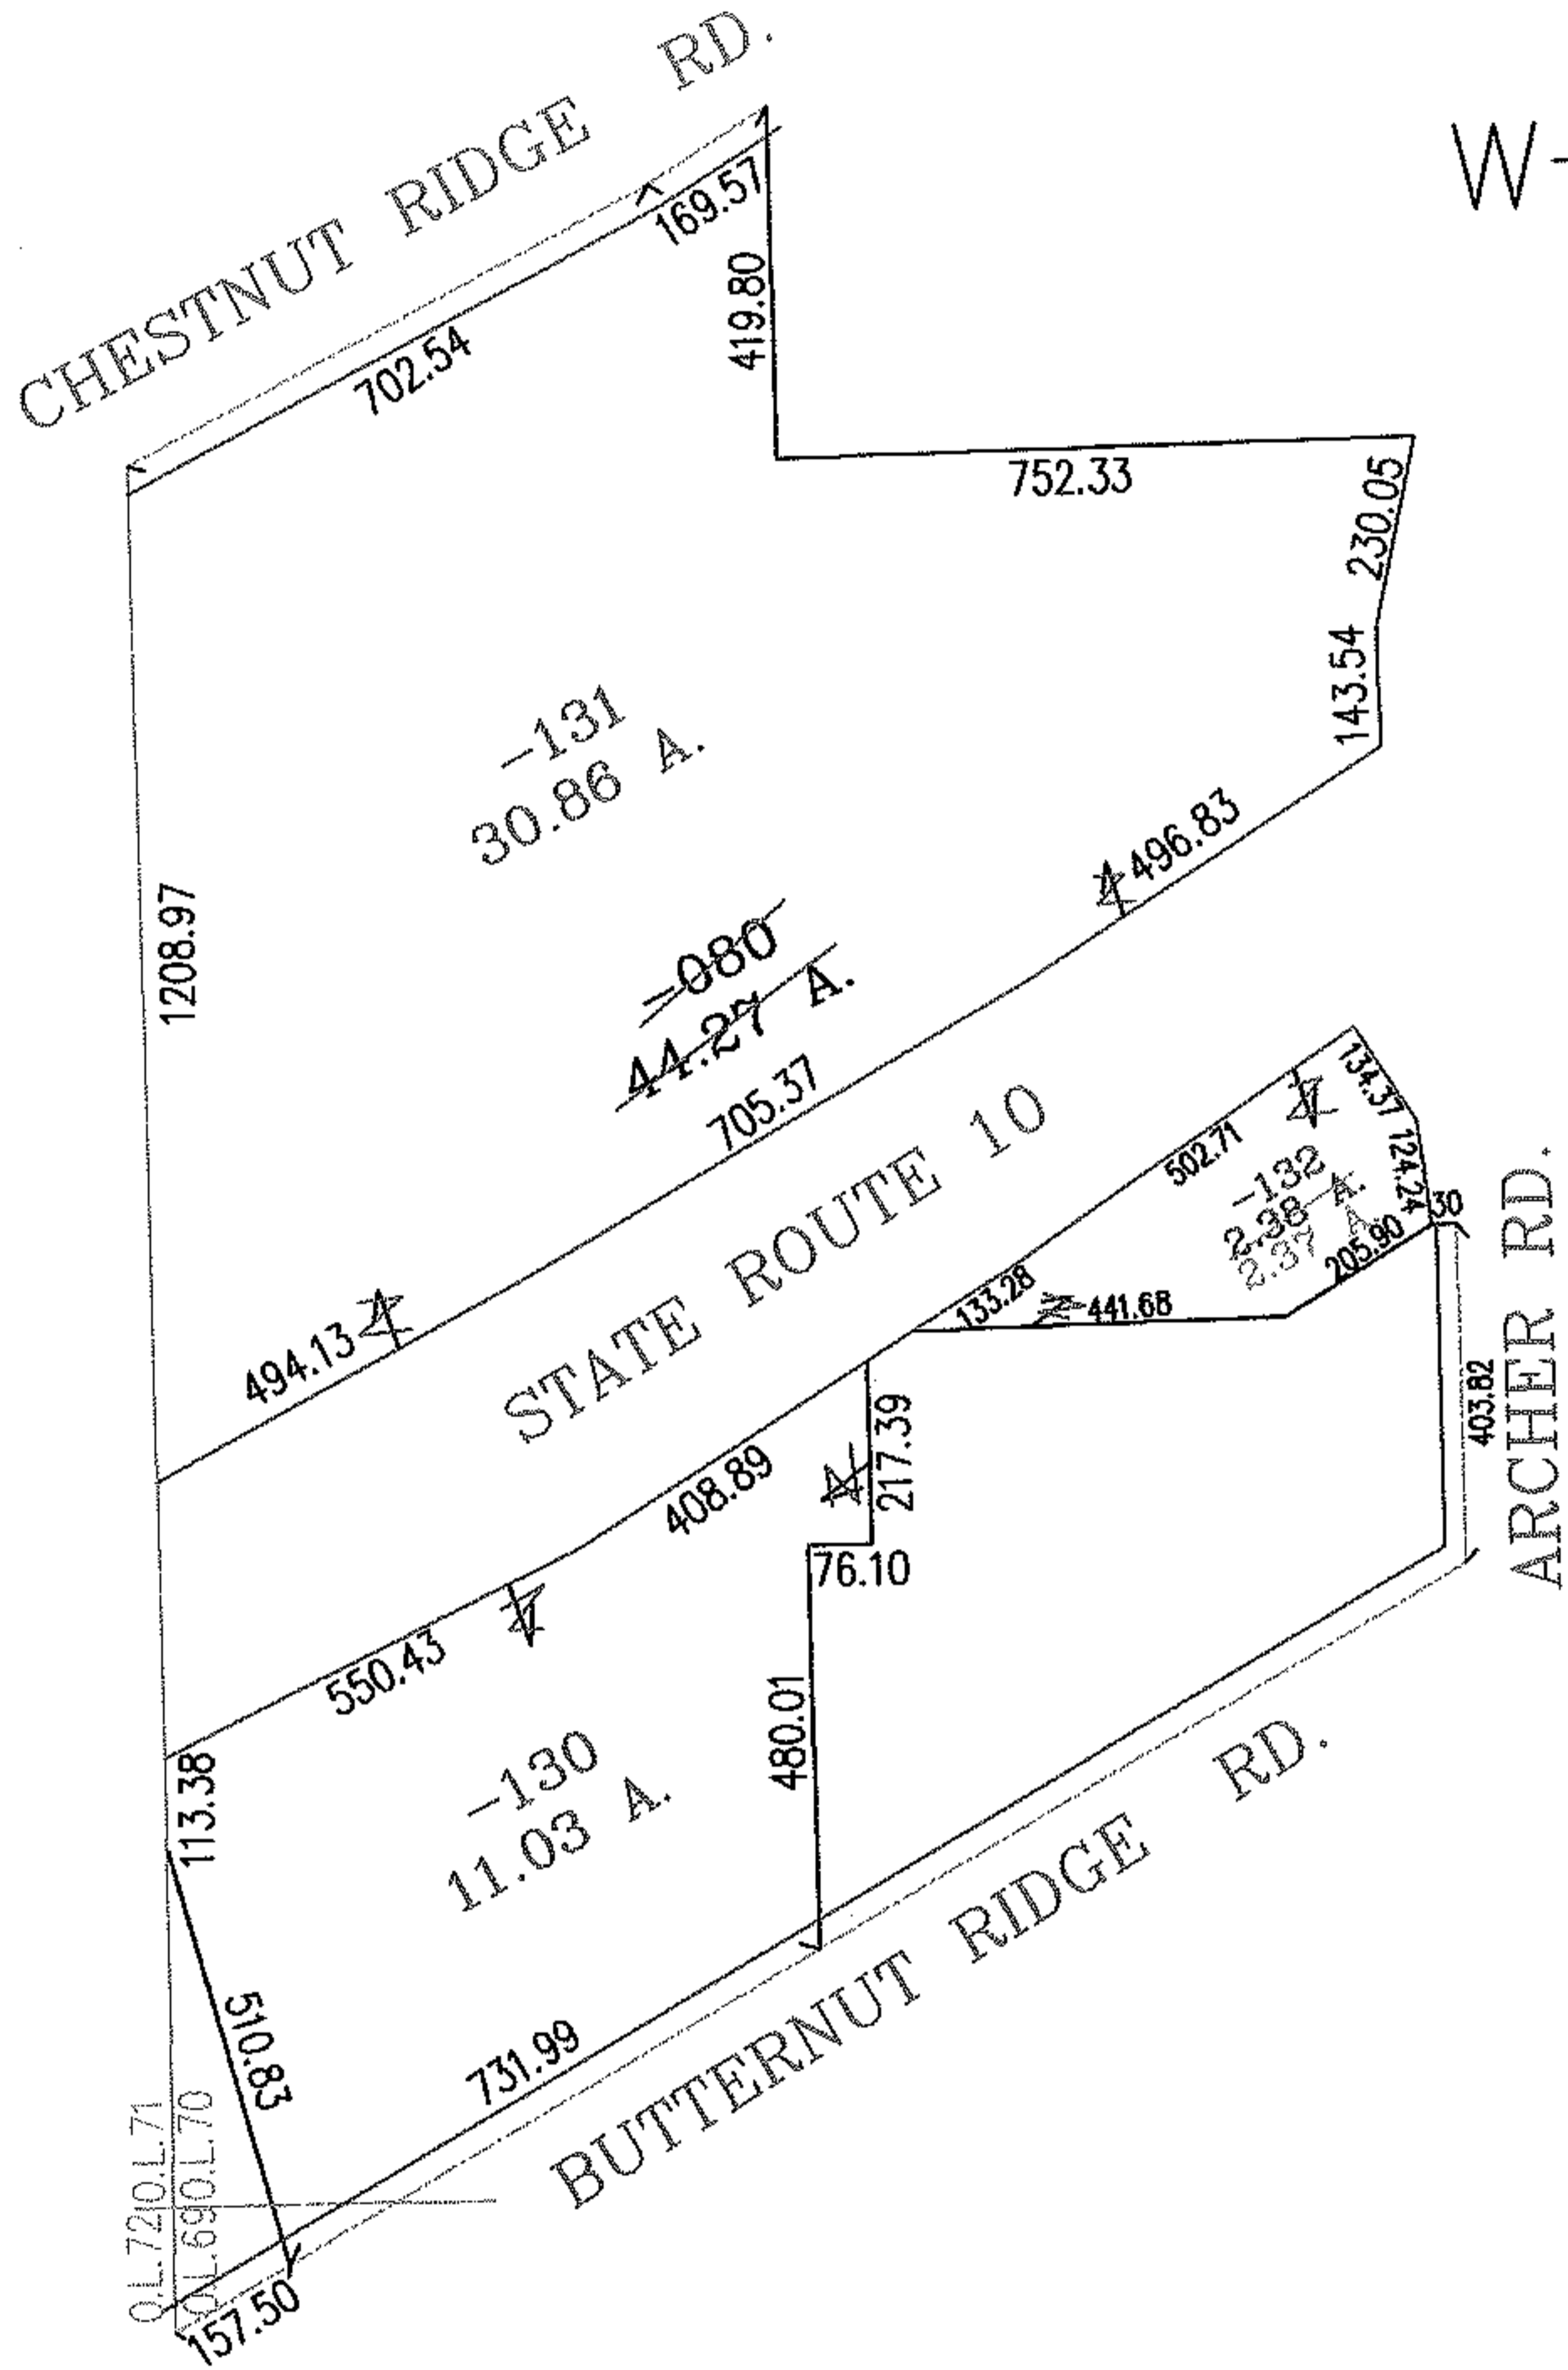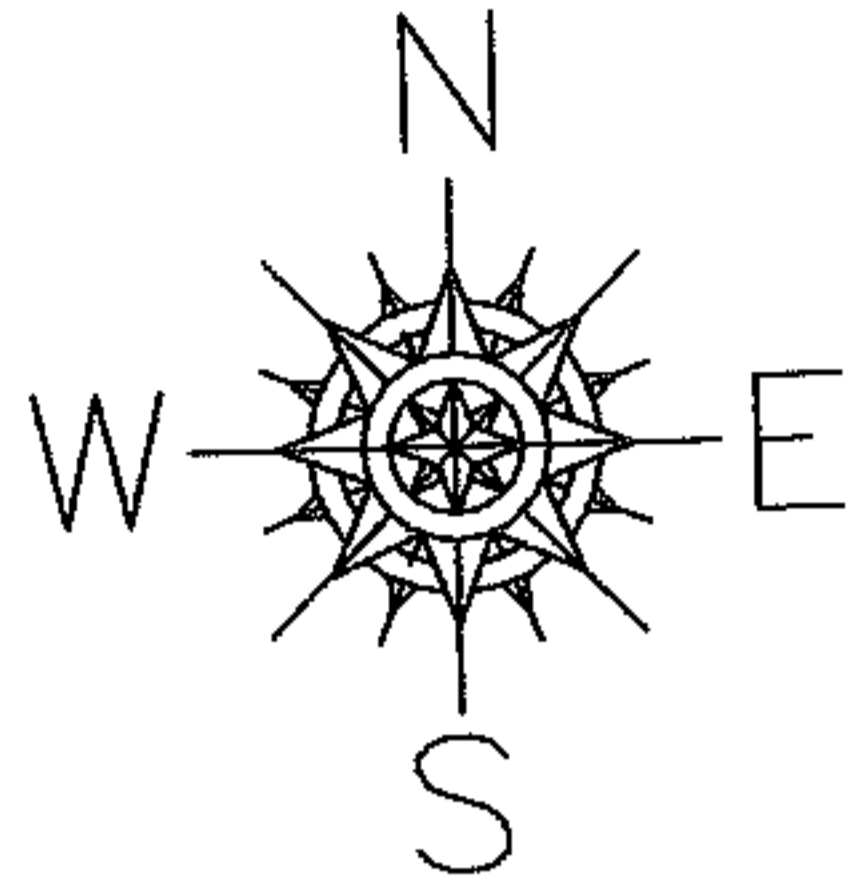

SPLITS/DEEDS PROCESSED
 LORAIN COUNTY TAX MAP DEPARTMENT
 226 MIDDLE AVE. ELYRIA, OHIO

SURVEYED BY: MARK ALLEN YEAGER
 CLOSURE: .01:10.000
 MAP PAGE(S): 11-00-070-A&B
 APPROVED BY: RRM DATE: 3-30-04
 SCALE: 1" = 400' PRIOR INSTRUMENT: 20030972204