


RASTER

PARENT PARCEL: 12-00-024-000-027,-028


CHILD PARCEL: 12-00-024-000-029

STARTING POINT: INTERSECTION OF C/L OF BOONE RD. AND NORTH LINE OF O.L.24


NO. 01655

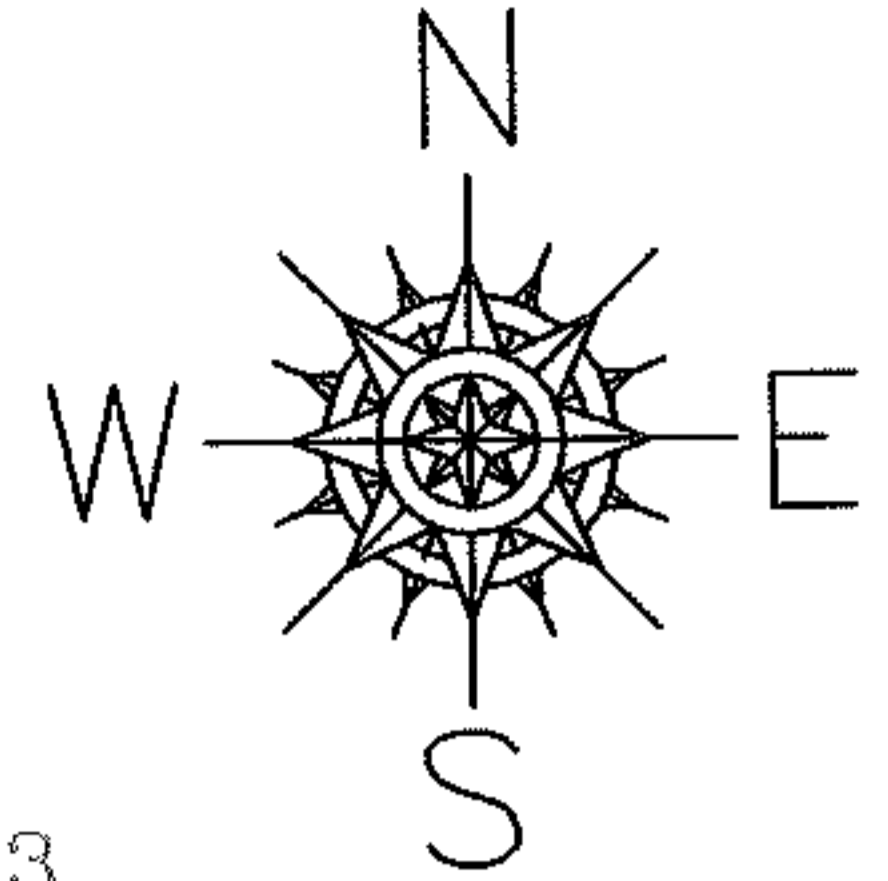

O.L.23  
O.L.24

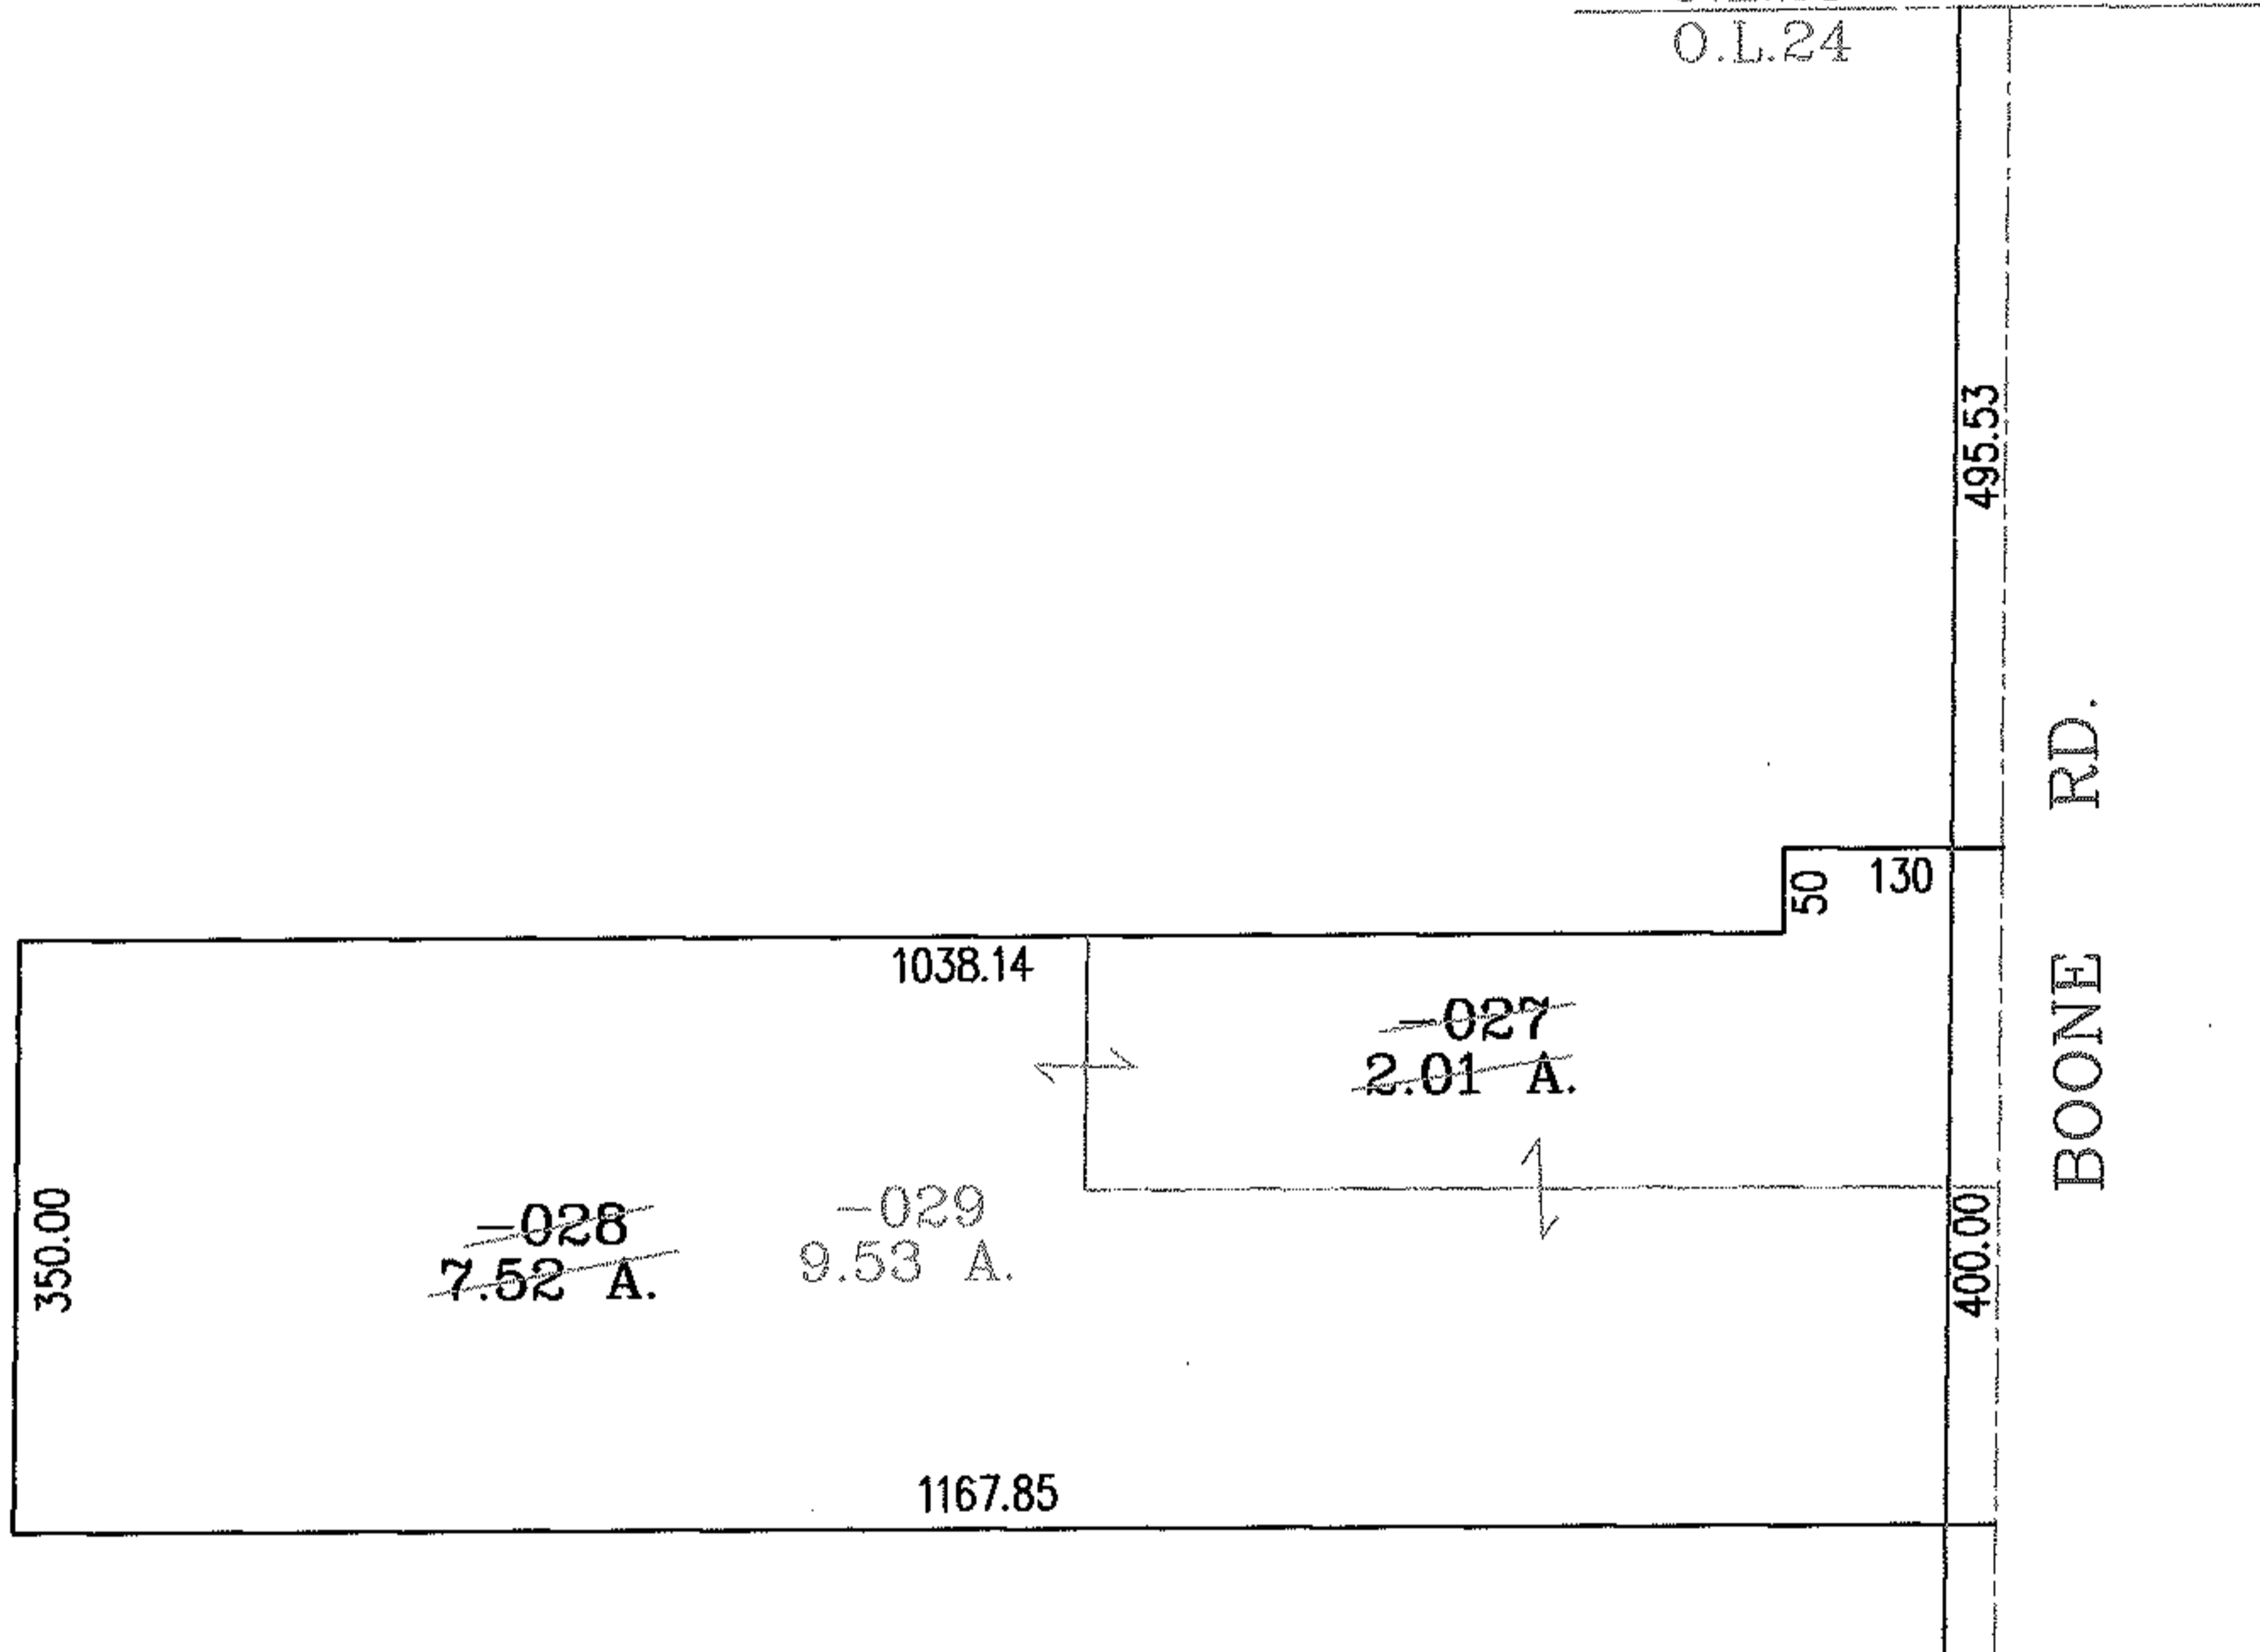

PRIOR INSTRUMENT: 2000699433  
20010766995

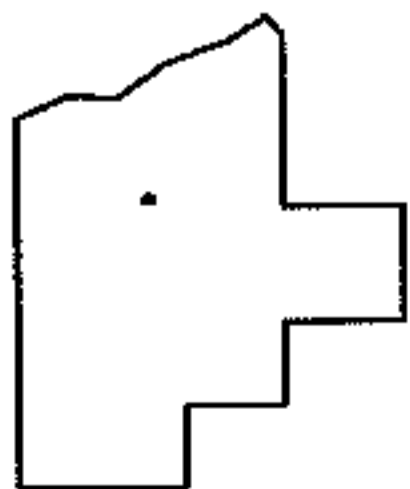

**SPLITS/DEEDS PROCESSED**  
LORAIN COUNTY TAX MAP DEPARTMENT  
226 MIDDLE AVE. ELYRIA, OHIO

SURVEYED BY: TIMOTHY J. FELLER  
CLOSURE: .00:10.000  
MAP PAGE(S): 12-00-024-B  
APPROVED BY: RRM DATE: 5-12-04  
SCALE: 1" = 200 PRIOR INSTRUMENT: \_\_\_\_\_