
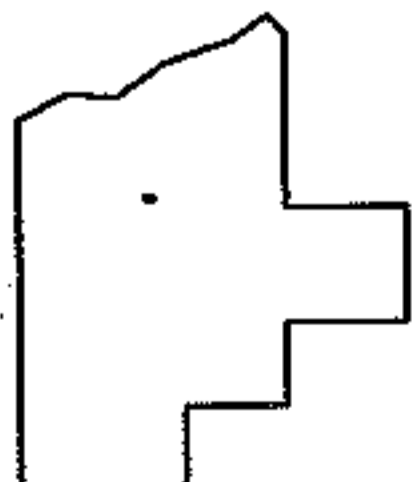
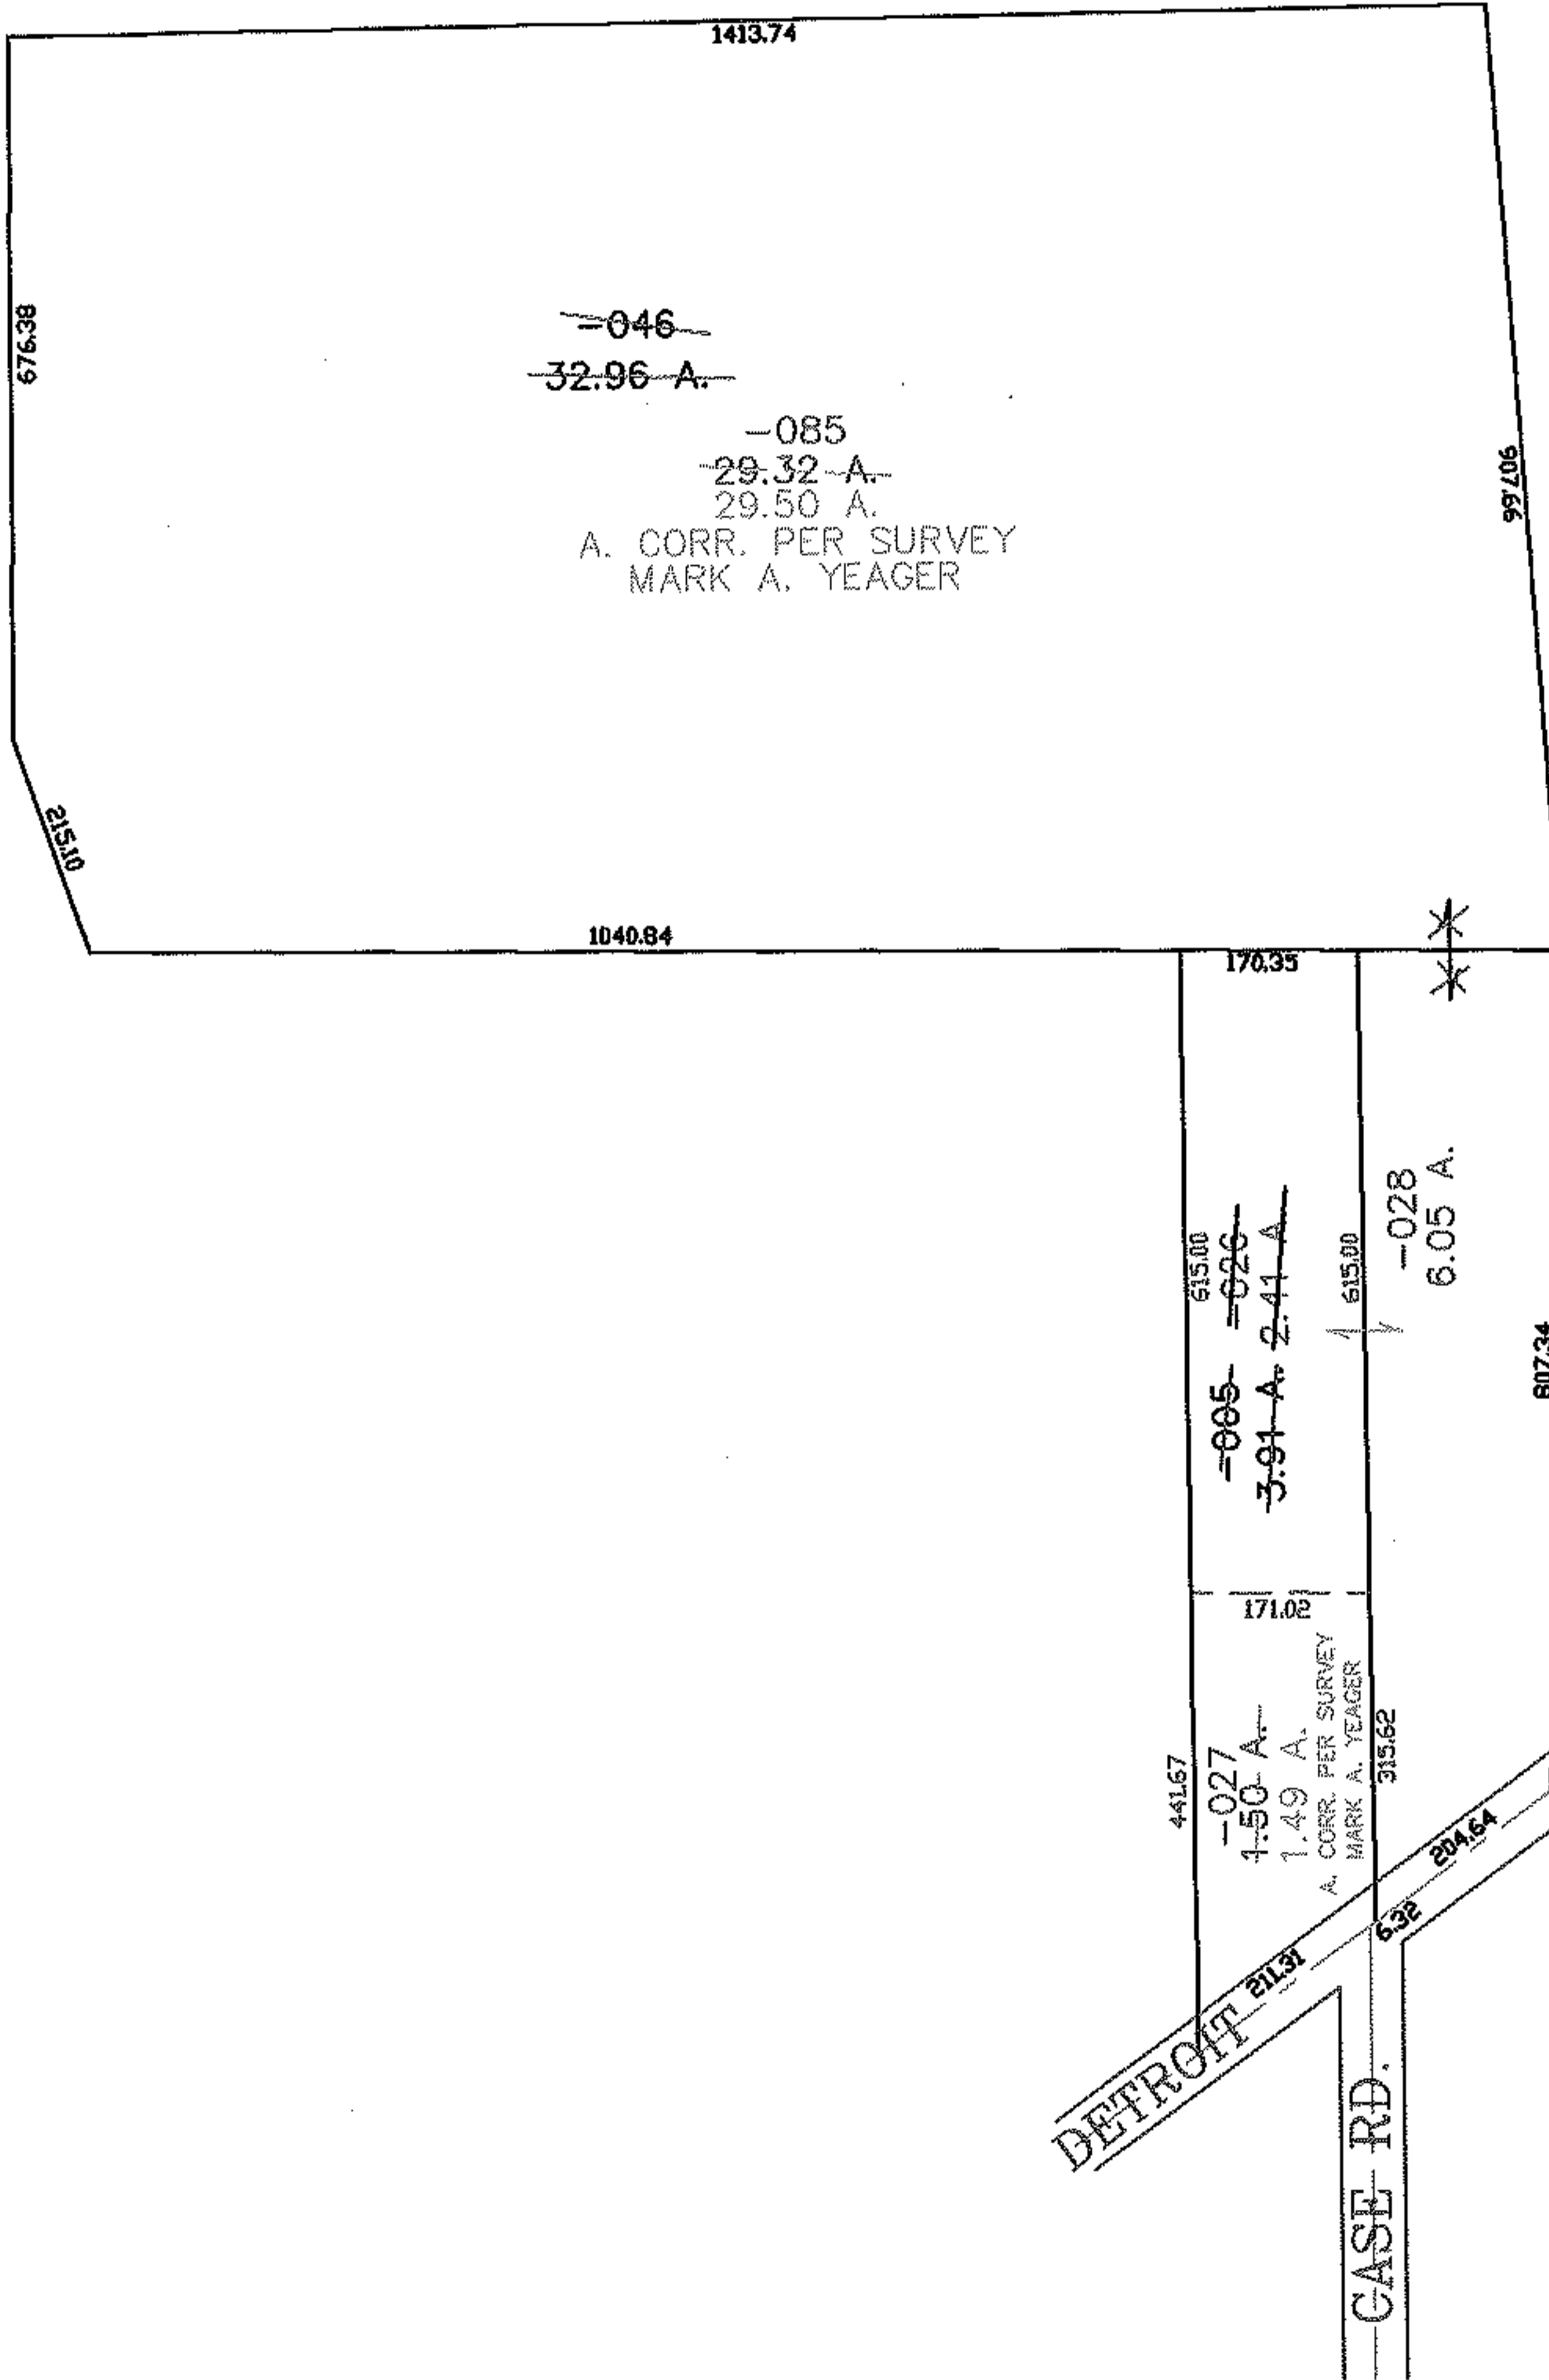


PARENT PARCEL: 04-00-001-101-005, 04-00-002-101-046
CHILD PARCEL: 04-00-001-101-026 THRU -028, 04-00-002-101-085
STARTING POINT: CENTERLINE OF DETROIT RD. & CASE RD.

NO. 01659

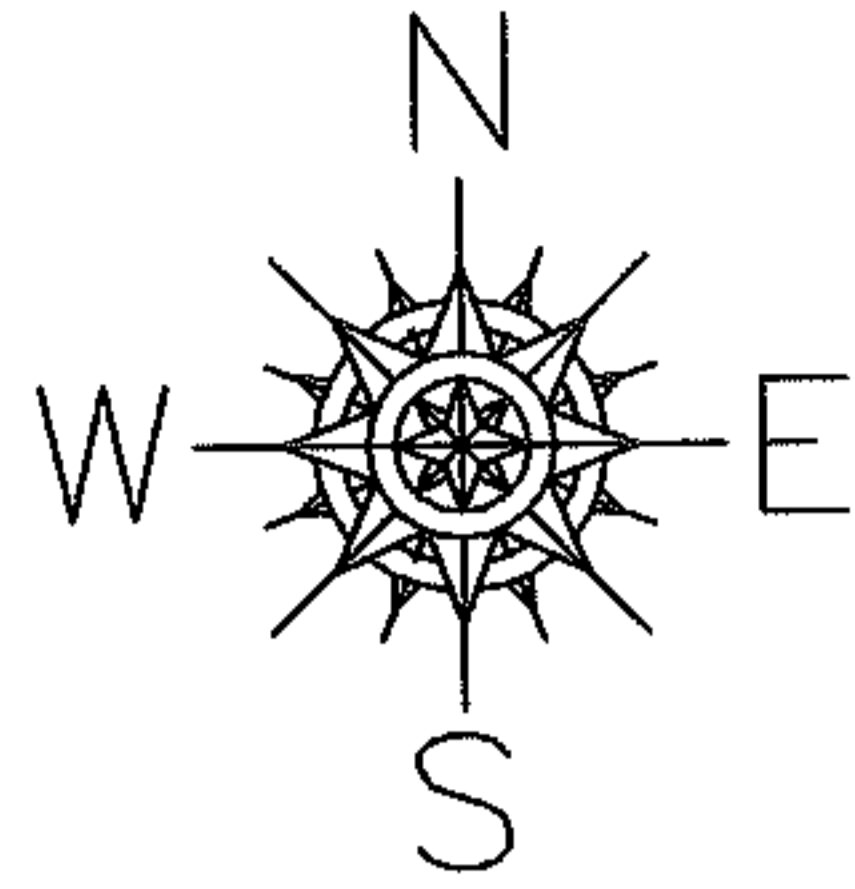

SPLITS/DEEDS PROCESSED
LORAIN COUNTY TAX MAP DEPARTMENT
226 MIDDLE AVE. ELYRIA, OHIO

SURVEYED BY: MARK A. YEAGER
CLOSURE: 0.00 : 10.000
MAP PAGE(S): 04-00-001-A, 002-E
APPROVED BY: JAH DATE: 5-19-04
SCALE: 1" = 300 PRIOR INSTRUMENT: OR 950/302