
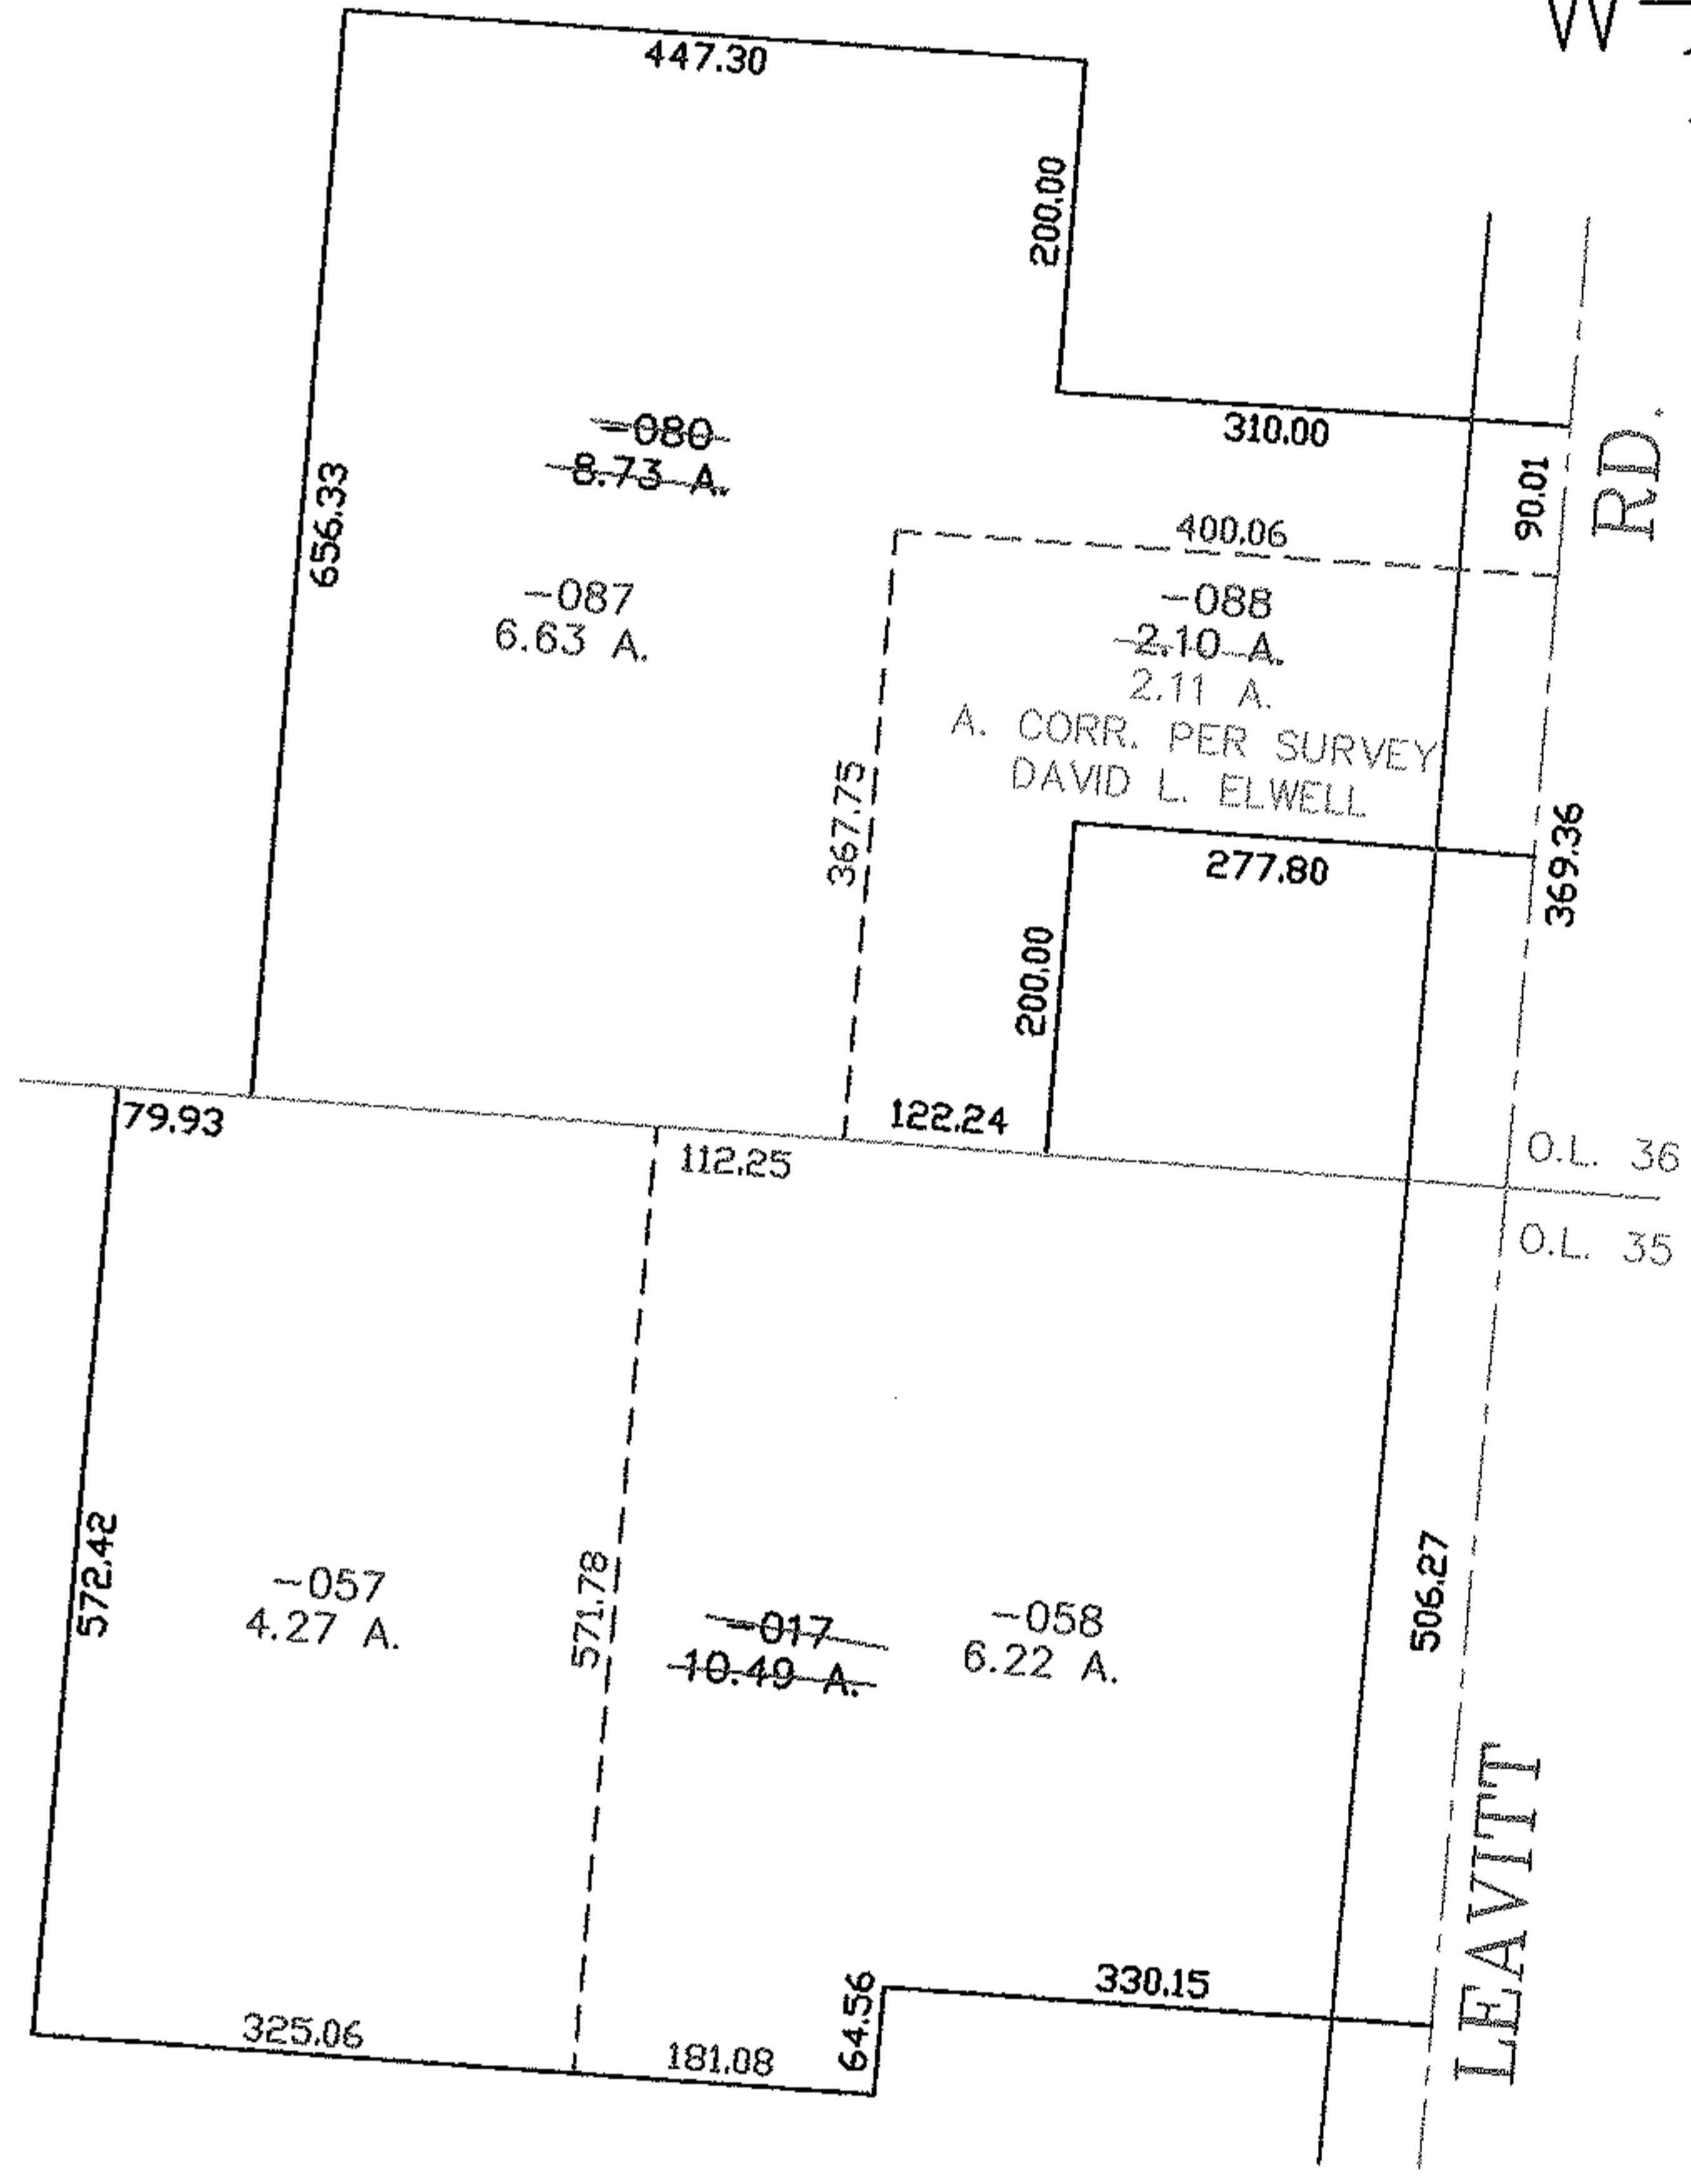


MASTER

PARENT PARCEL: 05-00-036-108-080 & 05-00-035-105-017  
CHILD PARCEL: 05-00-036-108-087, -088 & 05-00-035-105-057, -058  
STARTING POINT: CENTERLINE OF LEAVITT RD. & O.L. 35 & 36

NO. 01661

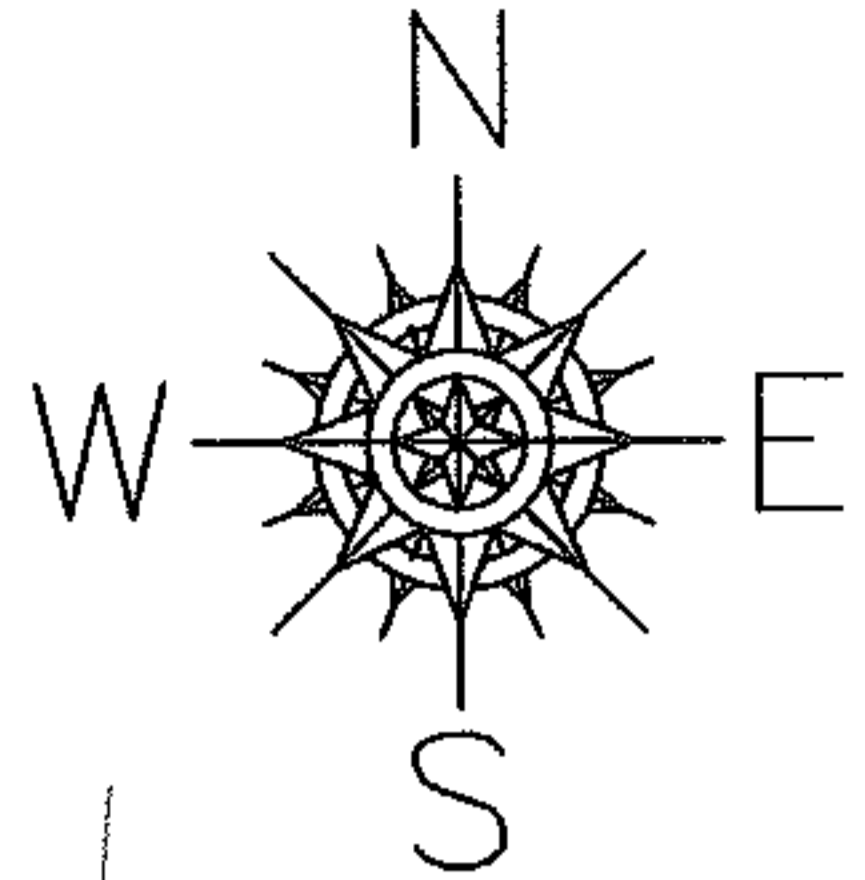

**SPLITS/DEEDS PROCESSED**  
LORAIN COUNTY TAX MAP DEPARTMENT  
226 MIDDLE AVE. ELYRIA, OHIO

SURVEYED BY: DAVID L. ELWELL  
CLOSURE: 0.00 : 10.000  
MAP PAGE(S): 05-00-035-B  
APPROVED BY: JAH DATE: 6-11-04  
SCALE: 1" = 200 PRIOR INSTRUMENT: 980524788