
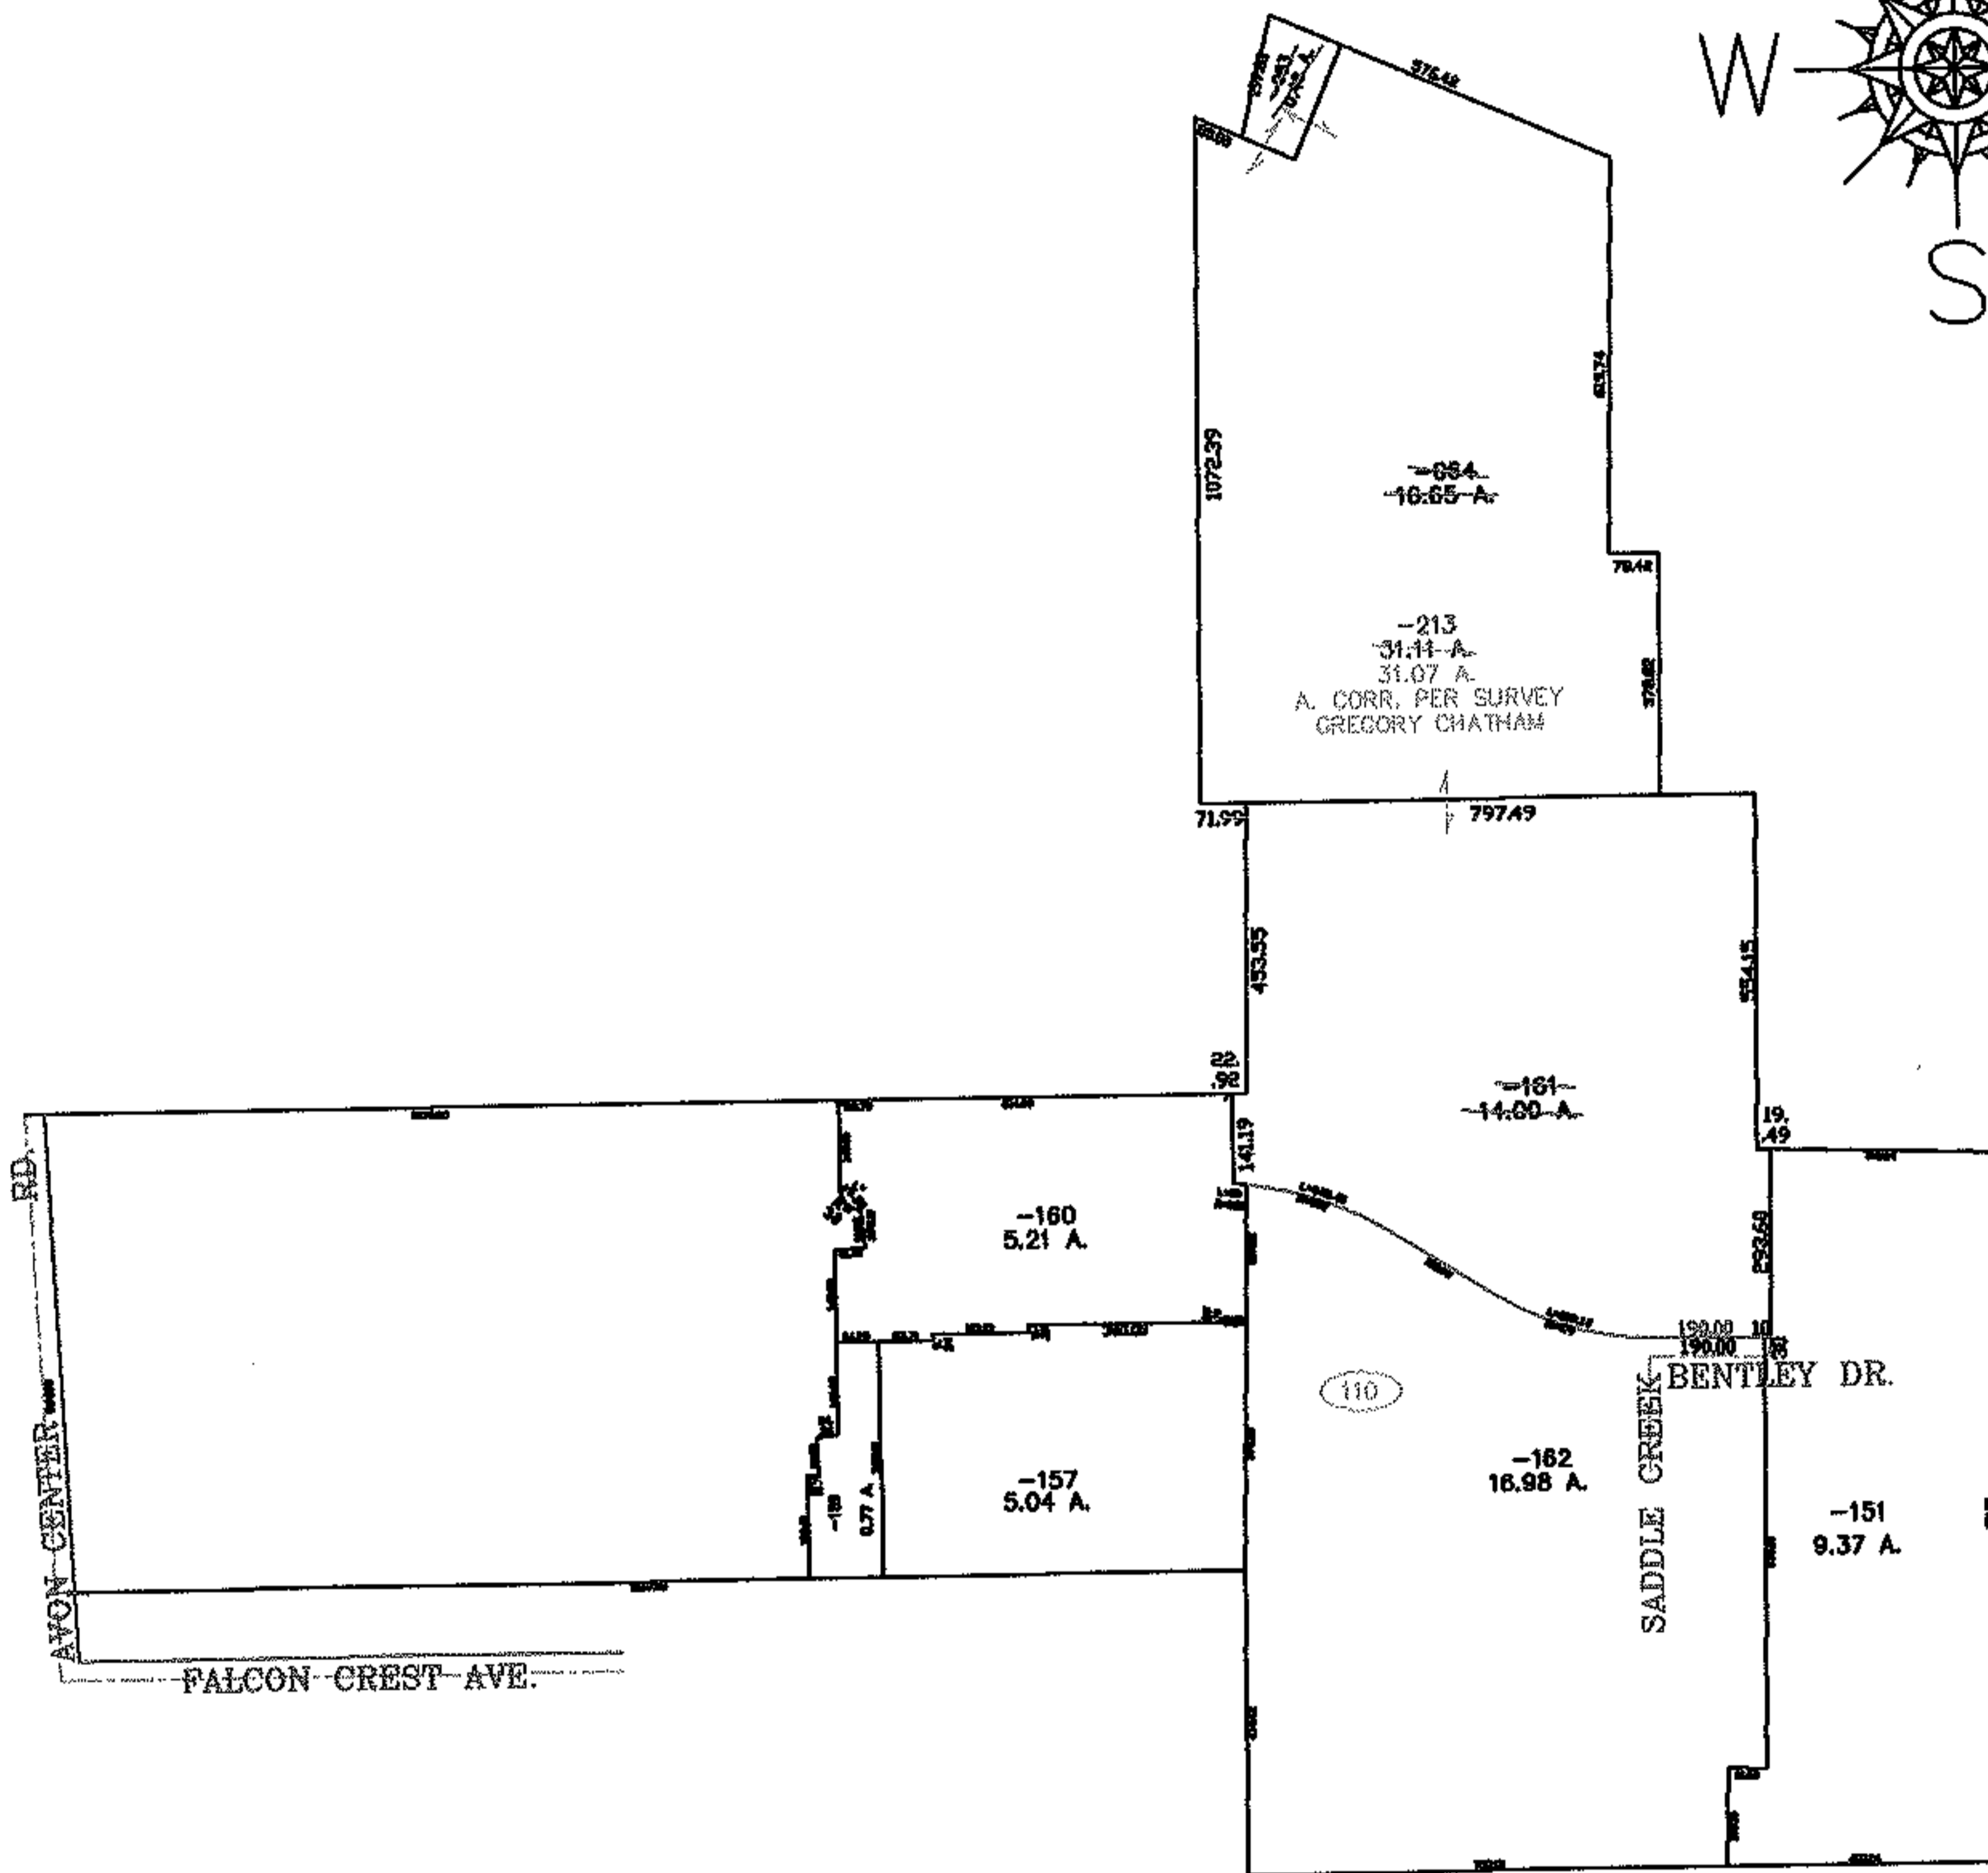


PARENT PARCEL: 04-00-015-110-161, -063, -064

CHILD PARCEL: 04-00-015-110-213

STARTING POINT: CENTERLINE OF BENTLEY DR. & SADDLE CREEK DR.

NO. 01663

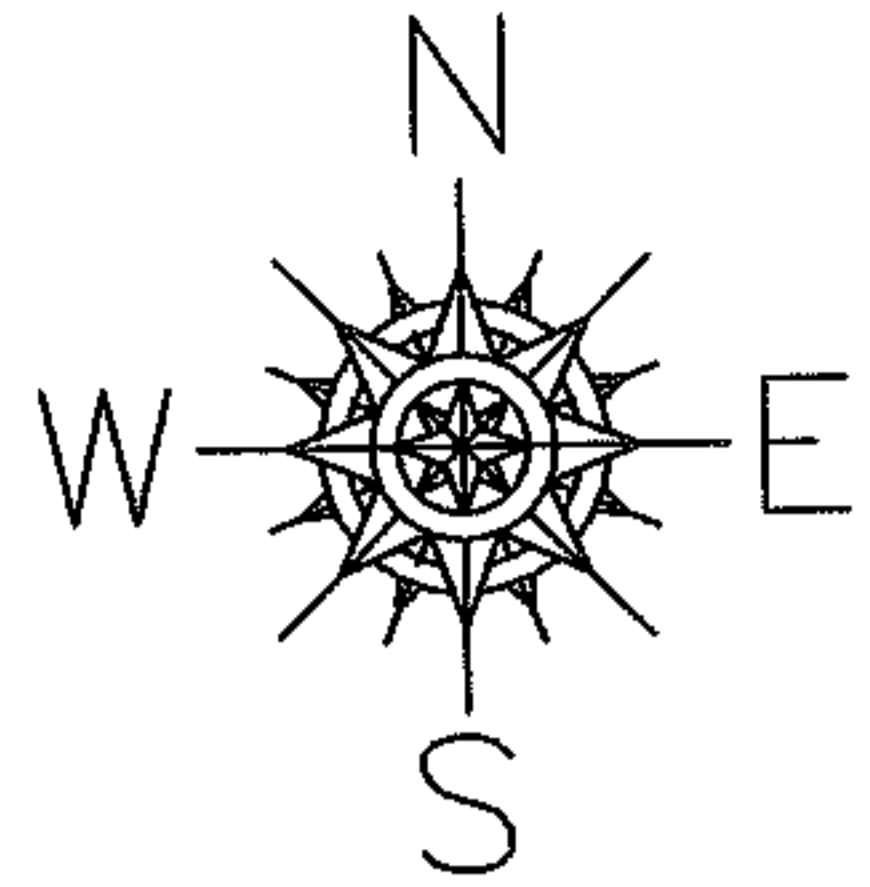

**SPLITS/DEEDS PROCESSED**

LORAIN COUNTY TAX MAP DEPARTMENT  
226 MIDDLE AVE. ELYRIA, OHIO

SURVEYED BY: RICHARD A. THOMPSON

CLOSURE: 0.00 ; 10.000

MAP PAGE(S): 04-00-015-H

APPROVED BY: JAH DATE: 8-23-04

SCALE: 1" = 500 PRIOR INSTRUMENT: 20020833687