



RASTER

PARENT PARCEL: 04-00-002-101-074, -078, -042, -017, -043

CHILD PARCEL: 04-00-002-101-086 THRU -097

STARTING POINT: CENTERLINE OF FRENCH CREEK RD. & MOON RD.

NO. 01671

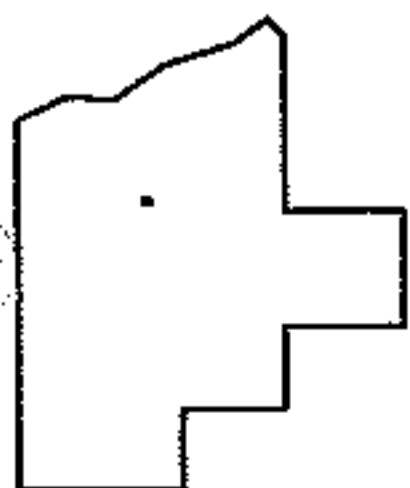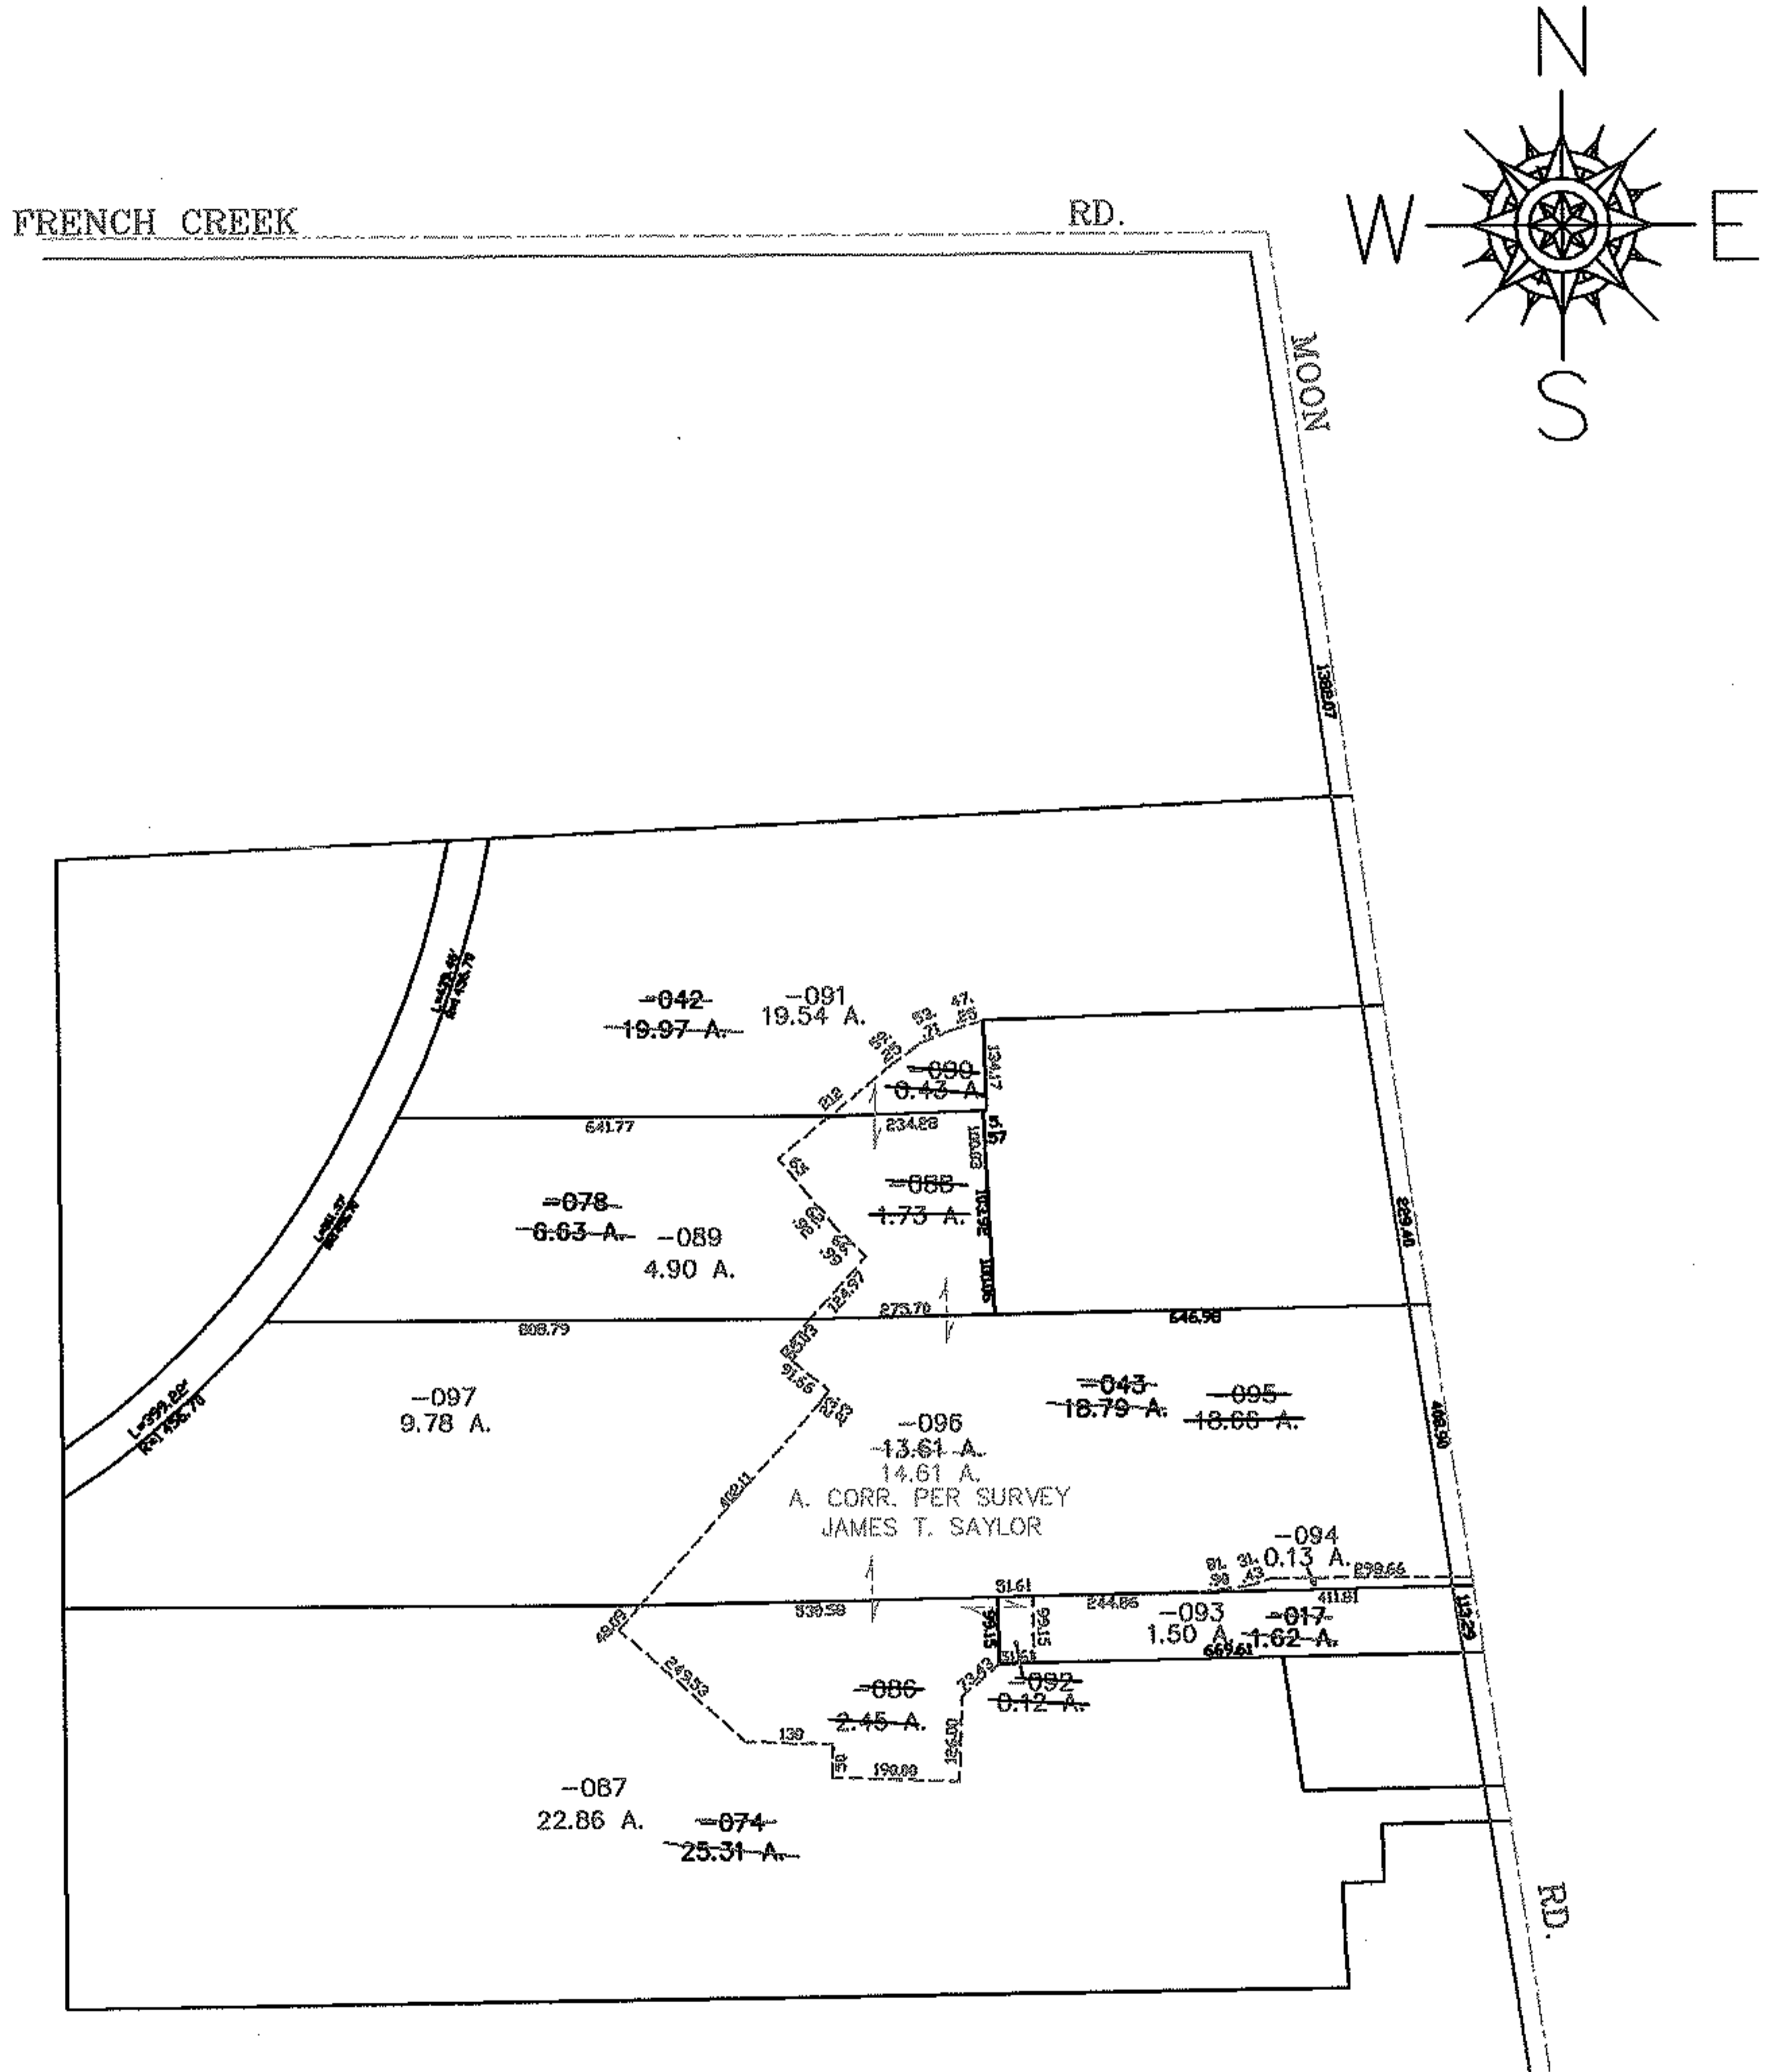

**SPLITS/DEEDS PROCESSED**  
 LORAIN COUNTY TAX MAP DEPARTMENT  
 226 MIDDLE AVE. ELYRIA, OHIO

SURVEYED BY: JAMES T. SAYLOR  
 CLOSURE: 0.01 : 10,000  
 MAP PAGE(S): 04-00-002-A, B  
 APPROVED BY: JAH DATE: 5-26-04  
 SCALE: 1" = 400 PRIOR INSTRUMENT: 19970865507