
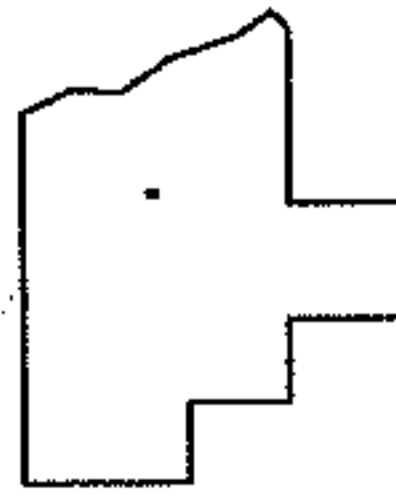
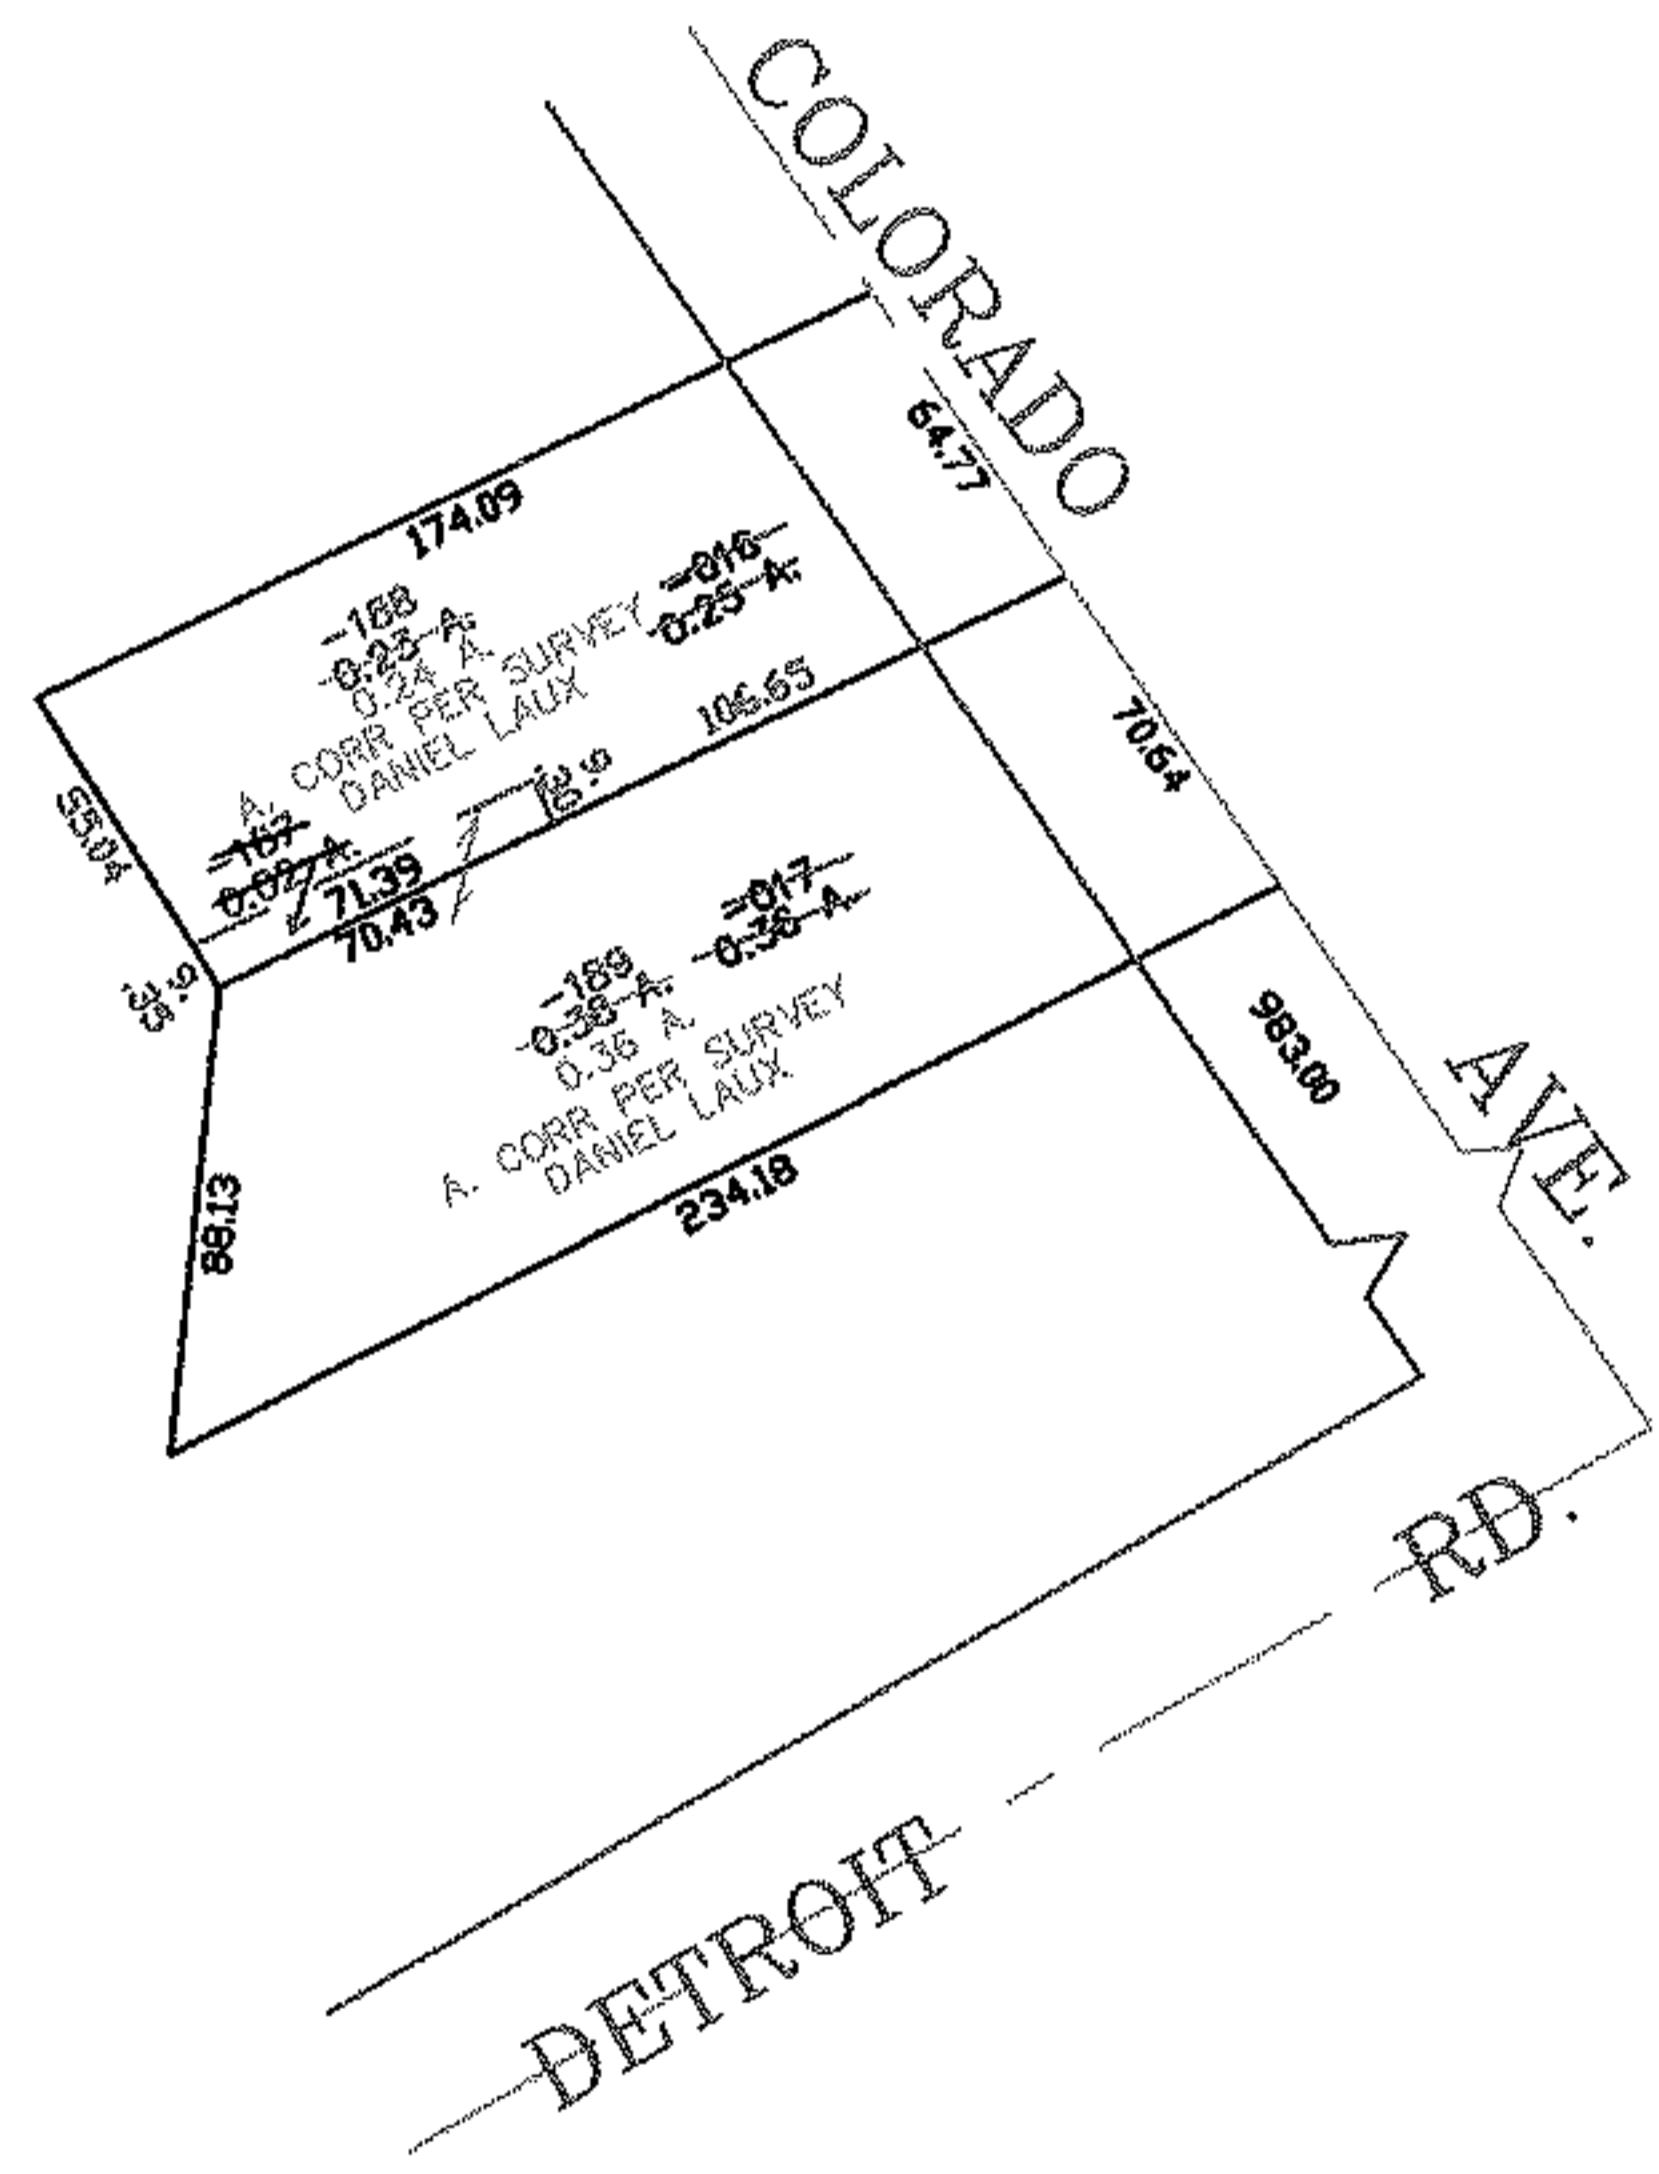


RASTER

PARENT PARCEL: 04-00-010-113-016, -017
CHILD PARCEL: 04-00-010-113-187 THRU -189
STARTING POINT: CENTERLINE OF DETROIT RD. & COLORADO AVE.

NO. 01673

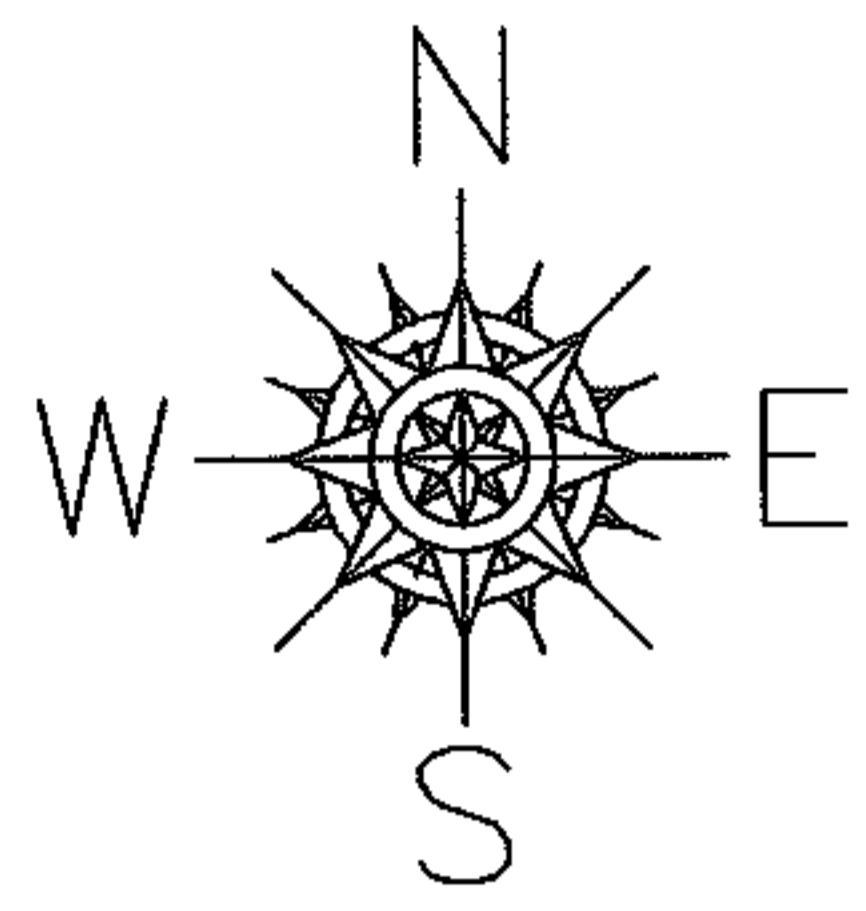

SPLITS/DEEDS PROCESSED

LORAIN COUNTY TAX MAP DEPARTMENT
226 MIDDLE AVE. ELYRIA, OHIO

SURVEYED BY: DANIEL LAUX
CLOSURE: 0.00 : 10.000
MAP PAGE(S): 04-00-010-F
APPROVED BY: JAH DATE: 6-11-04
SCALE: 1" = 100 PRIOR INSTRUMENT: 20030931786