



RASTER

PARENT PARCEL: 08-00-099-000-002

CHILD PARCEL: 08-00-099-000-013 THRU -024

STARTING POINT: CENTERLINE OF MILAN-ELYRIA RD. & BAIRD RD.

NO. 01675

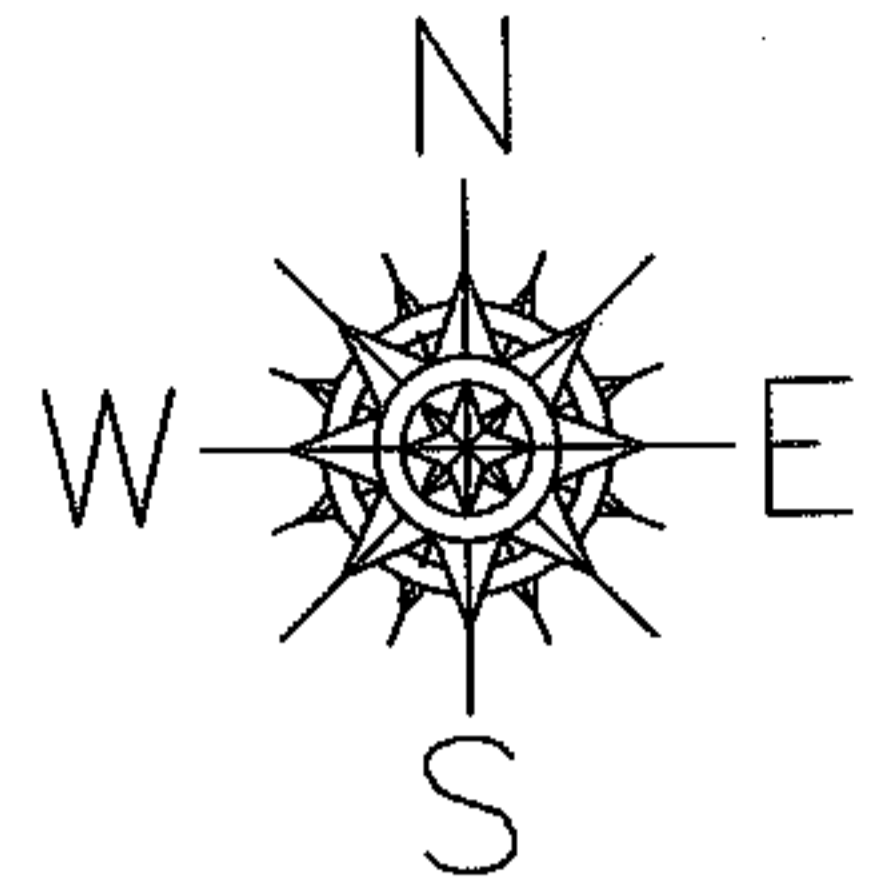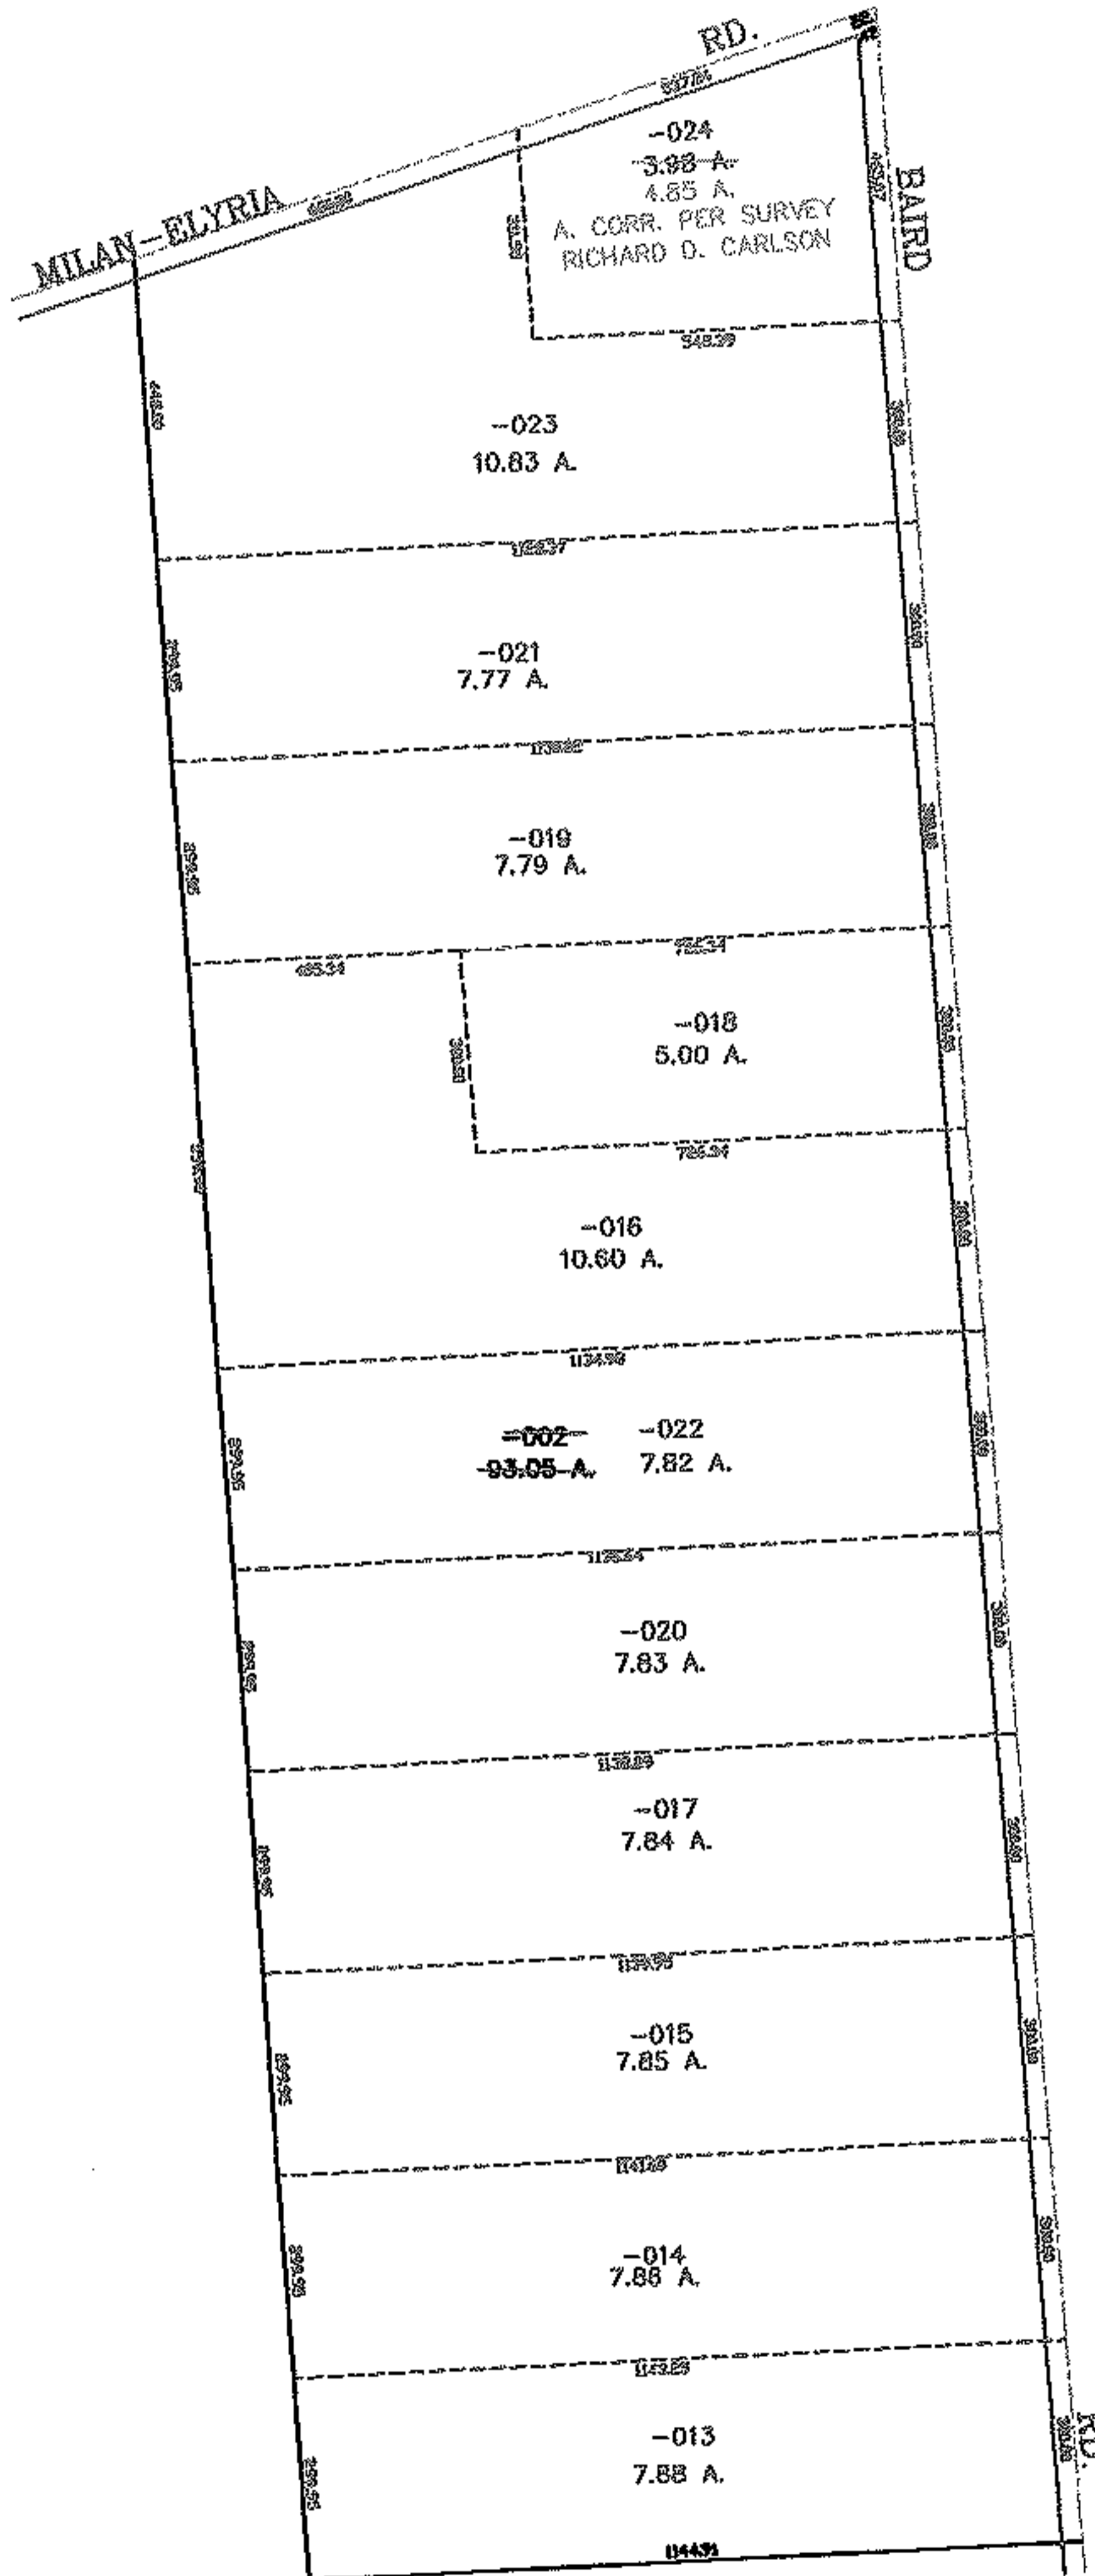

SPLITS/DEEDS PROCESSED

LORAIN COUNTY TAX MAP DEPARTMENT
226 MIDDLE AVE. ELYRIA, OHIO

SURVEYED BY: RICHARD D. CARLSON

CLOSURE: 0.00 : 10.000

MAP PAGE(S): 08-00-099-A

APPROVED BY: JAH DATE: 6-7-04

SCALE: 1" = 500 PRIOR INSTRUMENT: 20040979942