




RASTER

PARENT PARCEL: 21-03-000-000-024

CHILD PARCEL: 21-03-000-000-105, -106

STARTING POINT: CENTERLINE OF ASHLAND-OBERLIN RD. & TRACT 3

NO. 01678

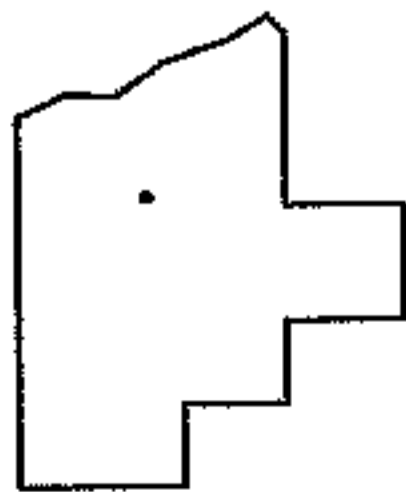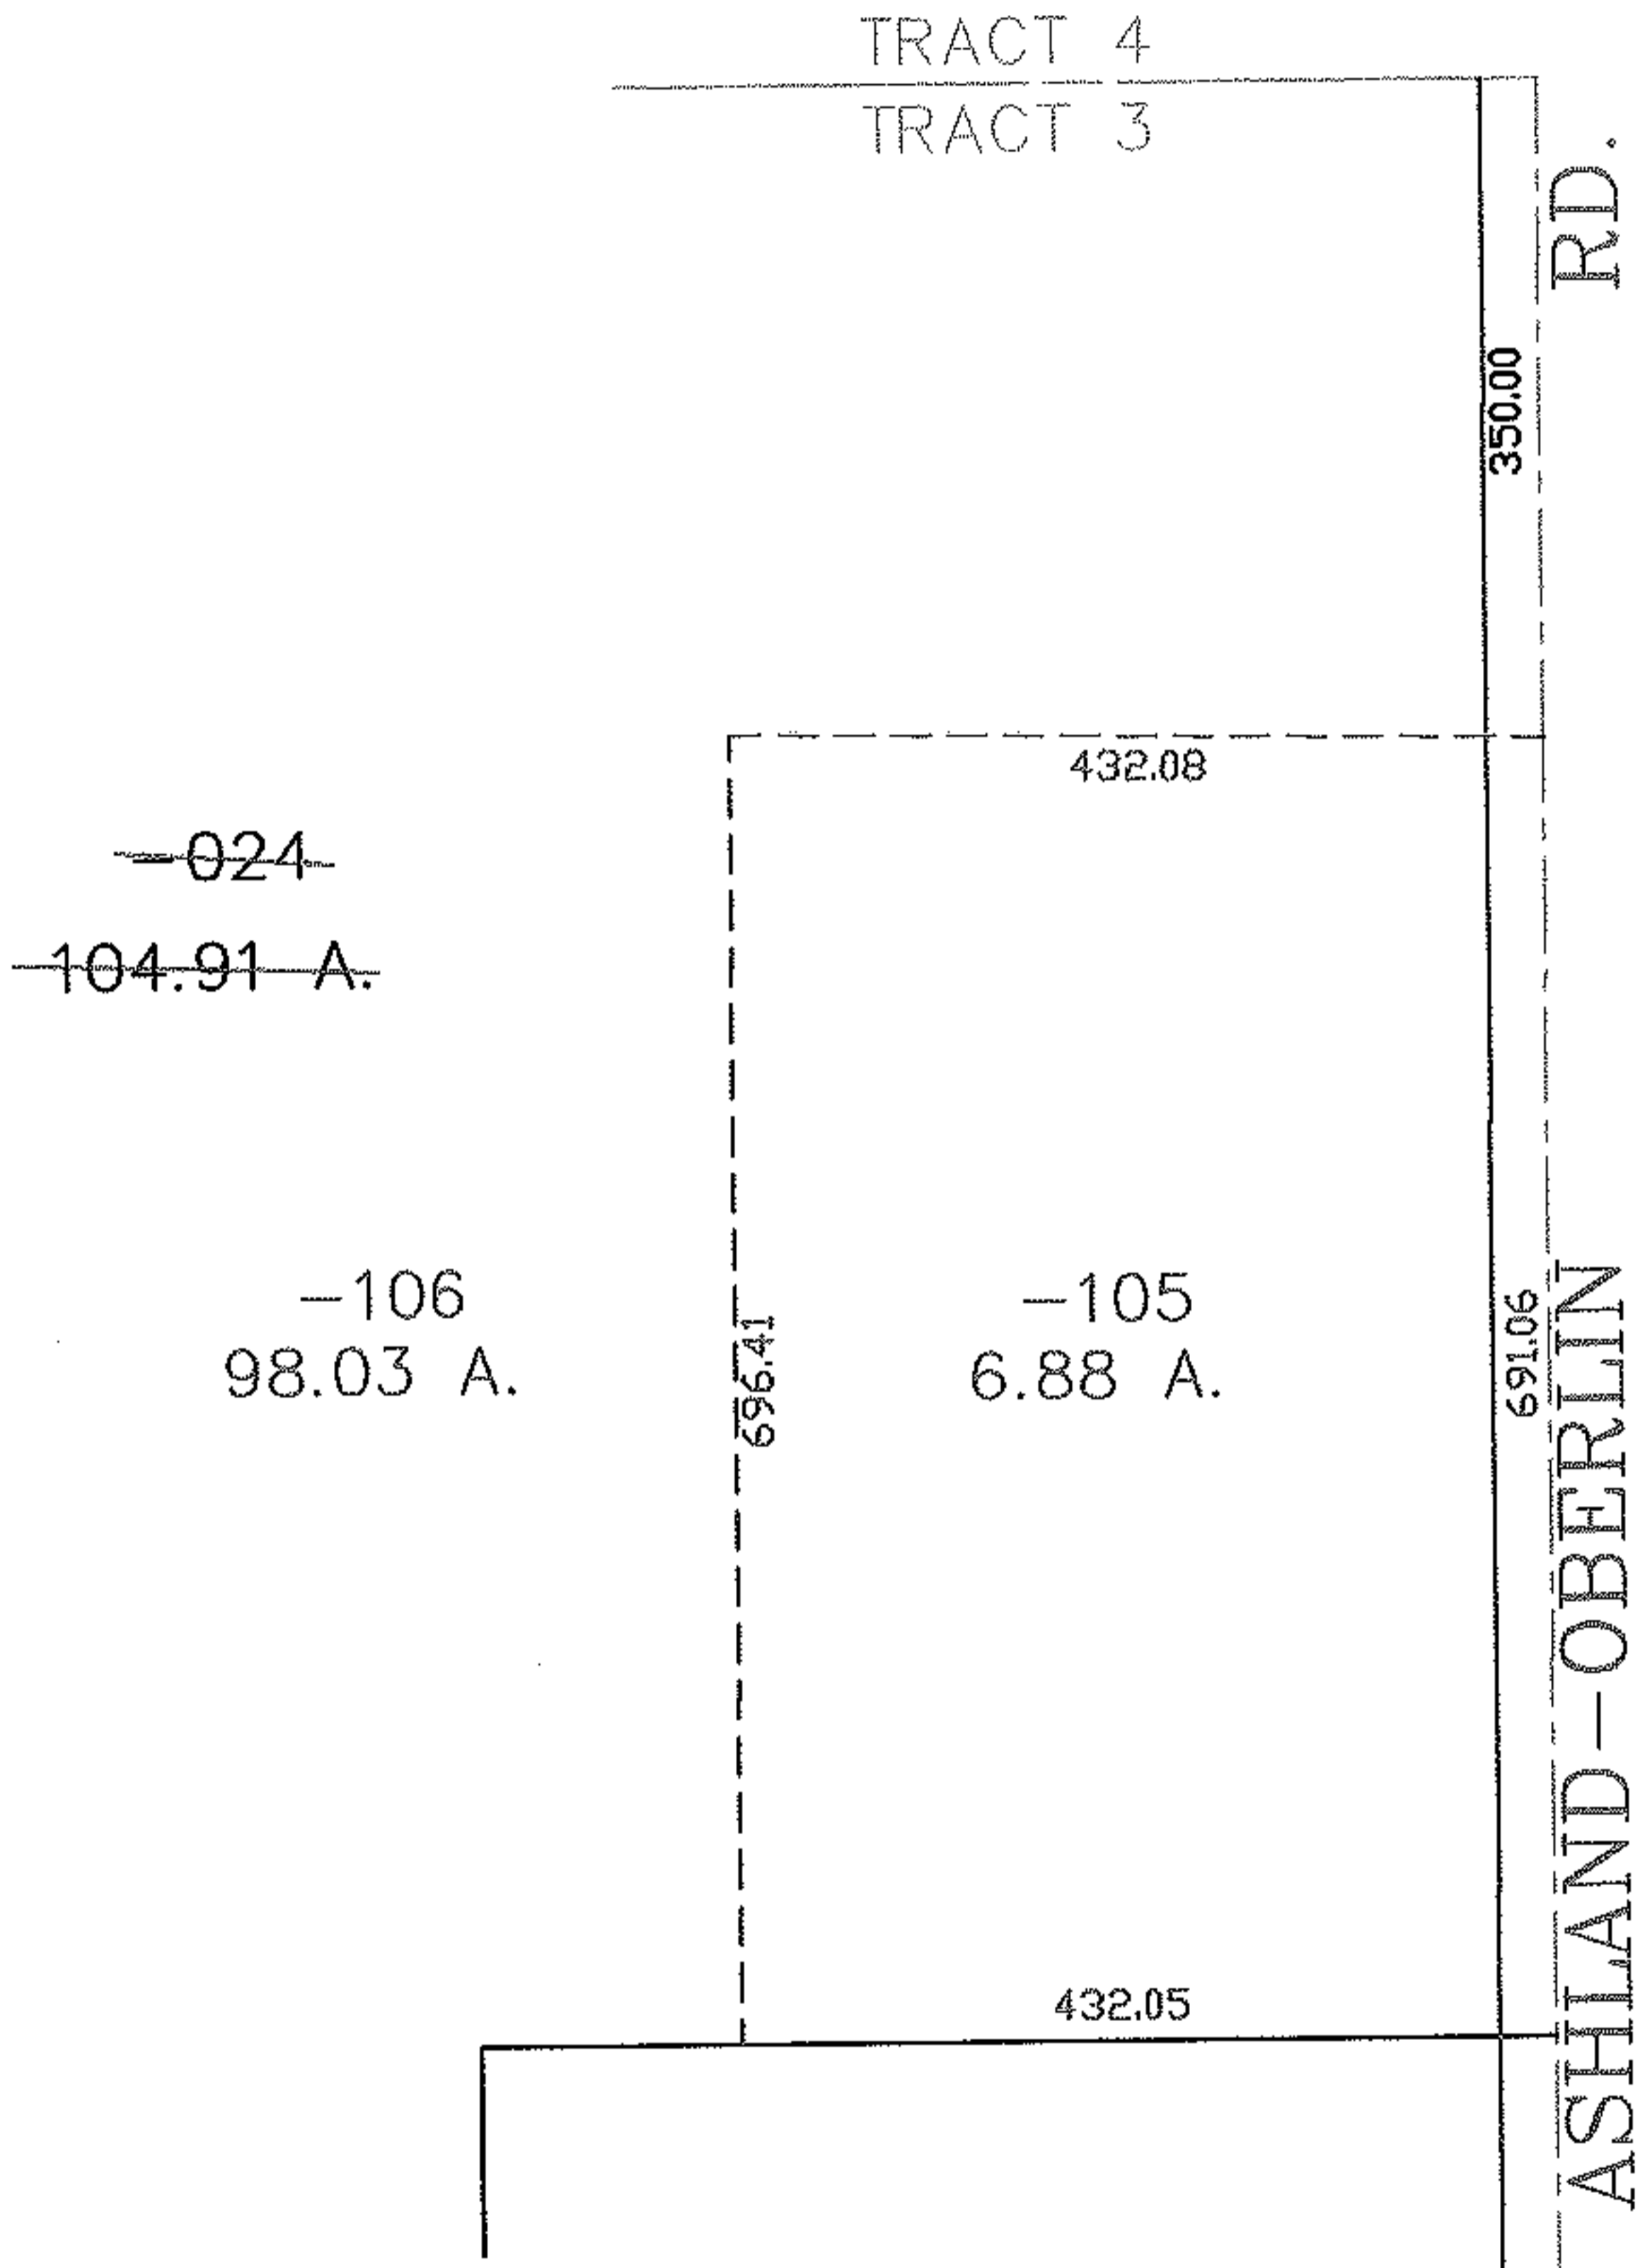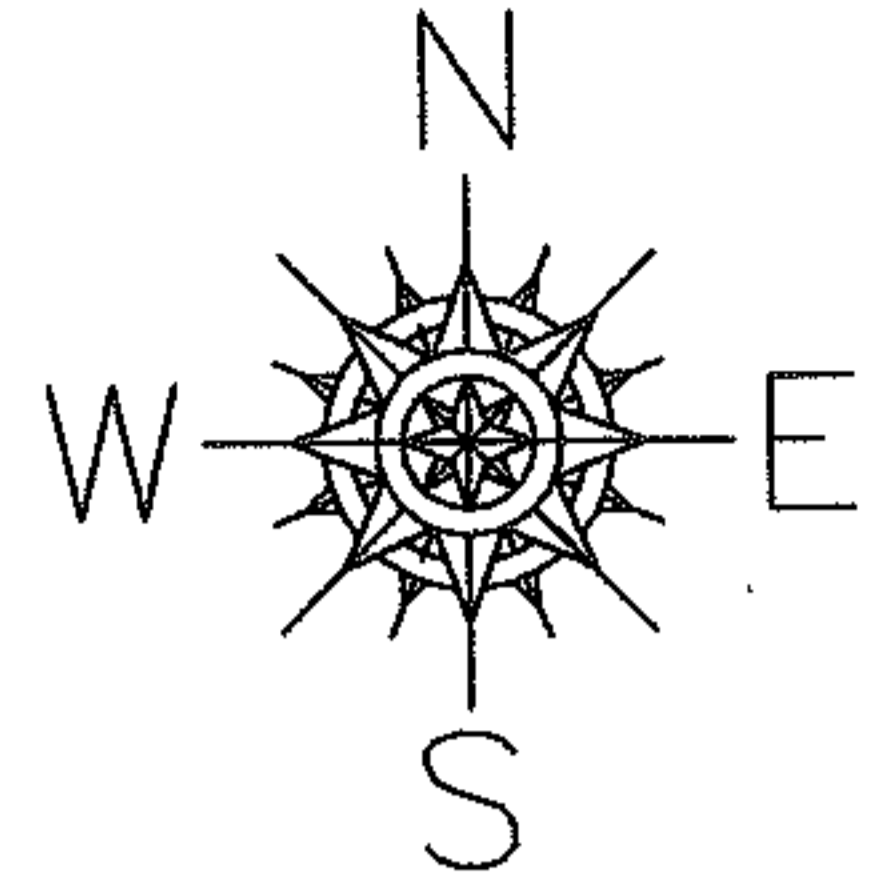

SPLITS/DEEDS PROCESSED
LORAIN COUNTY TAX MAP DEPARTMENT
 226 MIDDLE AVE. ELYRIA, OHIO

SURVEYED BY: THOMAS M. SNEZEK
 CLOSURE: 0.00 : 10.000
 MAP PAGE(S): 21-F
 APPROVED BY: JAH DATE: 6-10-04
 SCALE: 1" = 200 PRIOR INSTRUMENT: 20020870236