


FASTER

PARENT PARCEL: 04-00-017-103-038, -107




CHILD PARCEL: 04-00-017-103-224 THRU -228

STARTING POINT: CENTERLINE OF WALKER RD. & AVON BELDEN RD.

NO. 01682

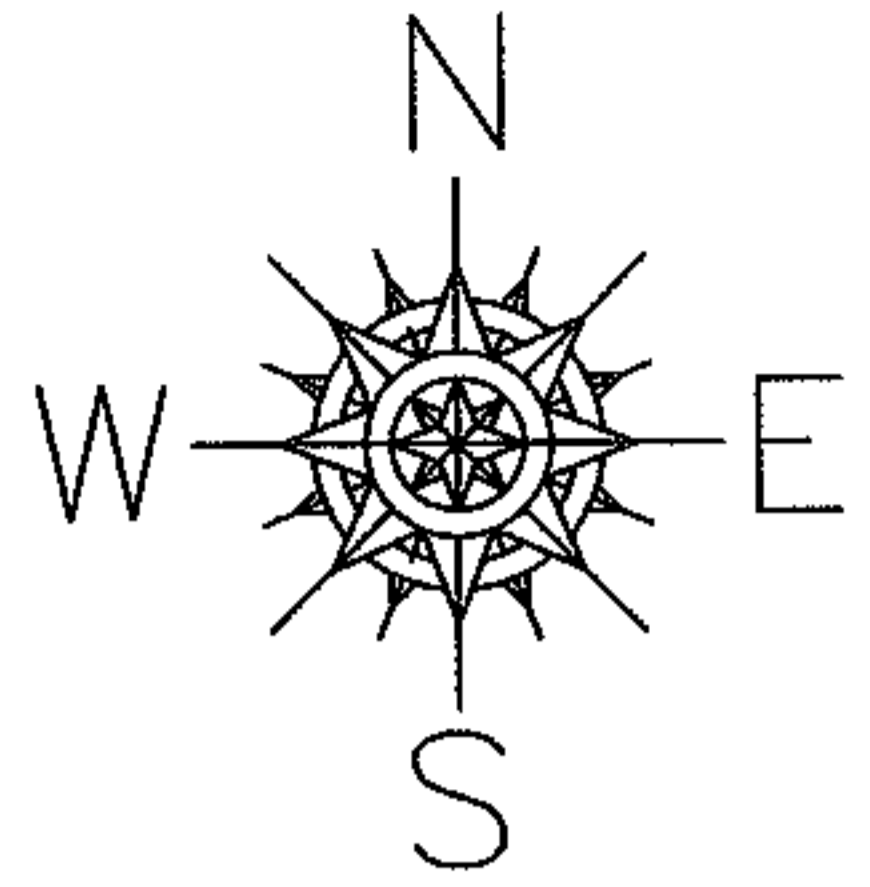

PLOT 1" = 100'

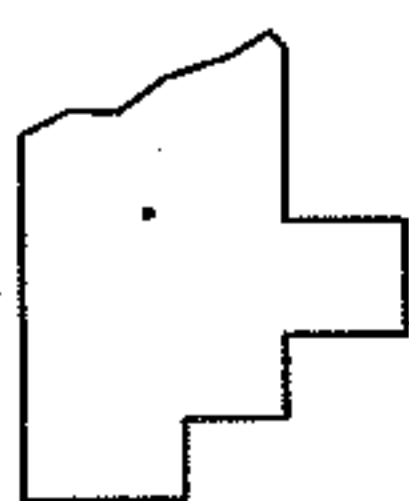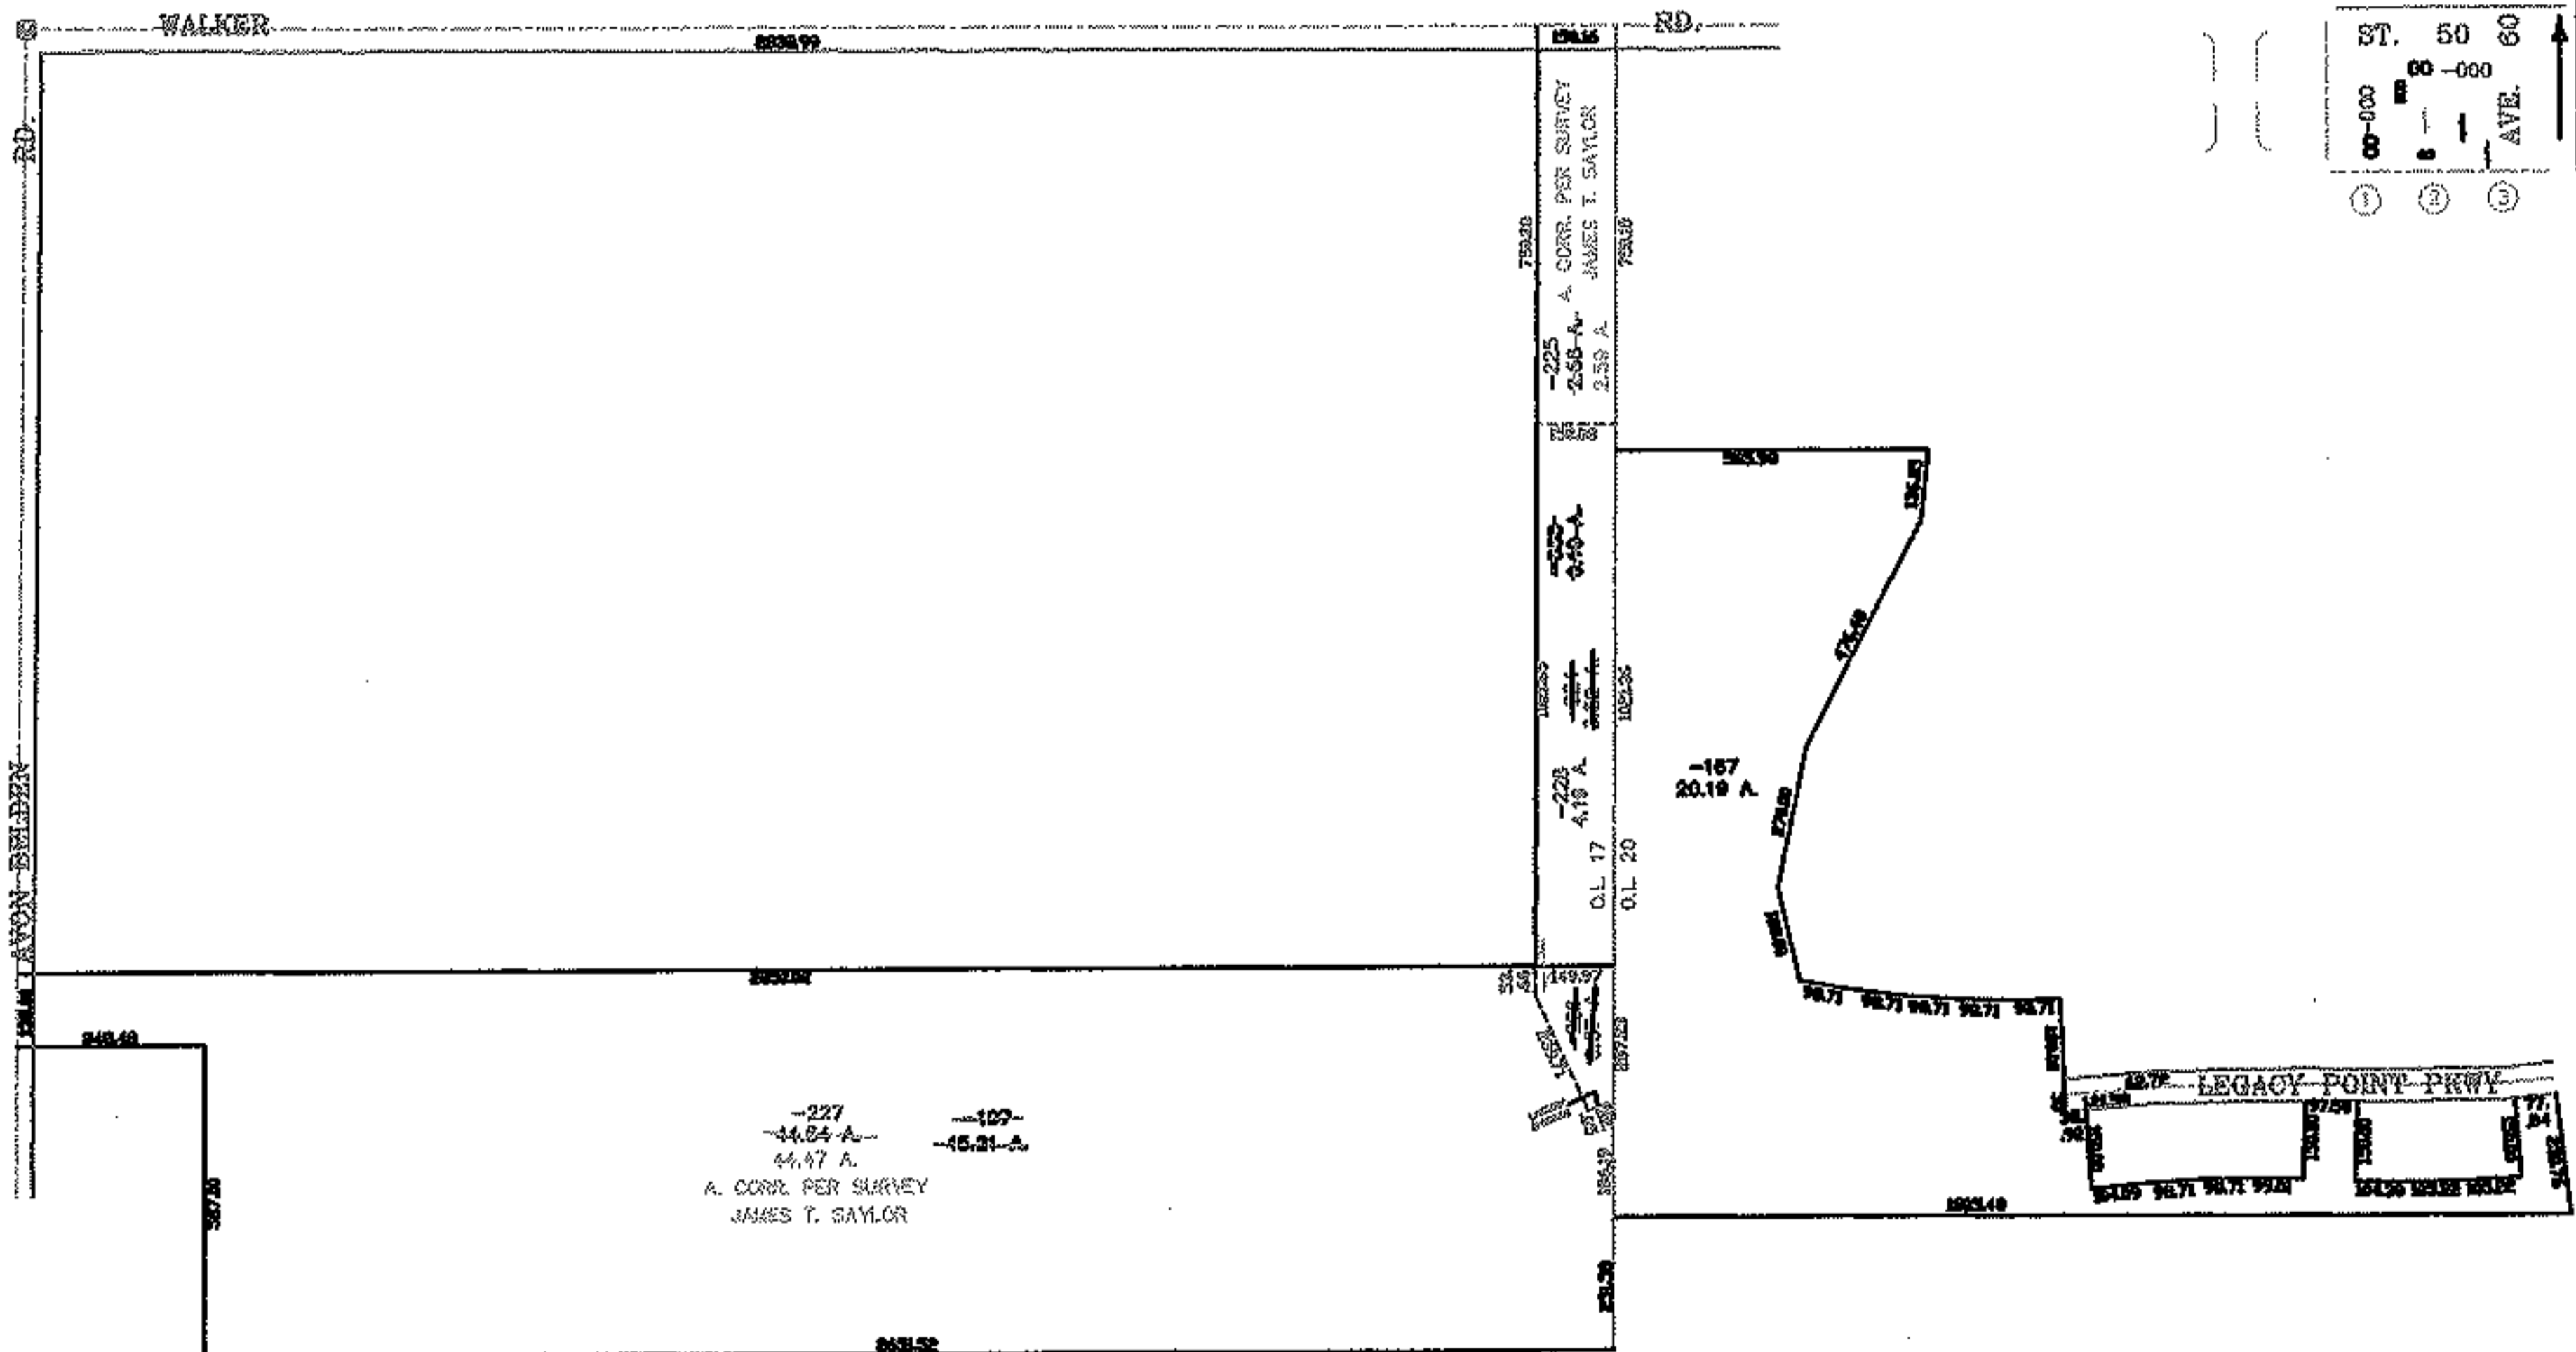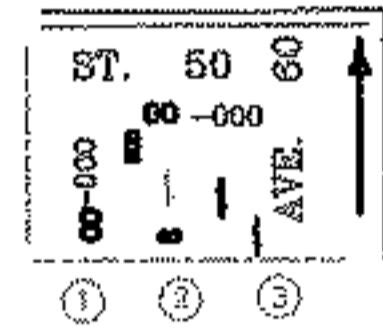

**SPLITS/DEEDS PROCESSED**

LORAIN COUNTY TAX MAP DEPARTMENT  
226 MIDDLE AVE. ELYRIA, OHIO

SURVEYED BY: JAMES T. SAYLOR

CLOSURE: 0.00 : 10,000

MAP PAGE(S): 04-00-017-D

APPROVED BY: JAH DATE: 6-22-04

SCALE: 1" = 700 PRIOR INSTRUMENT: 20000671296