




RASTER

NO. 01692

PARENT PARCEL: 11-00-046-000-034, -038, -033

CHILD PARCEL: 11-00-046-000-043 THRU -054

STARTING POINT: CENTERLINE OF ELYRIA-TWINSBURG RD. & WOOSTER-AVON LAKE RD.

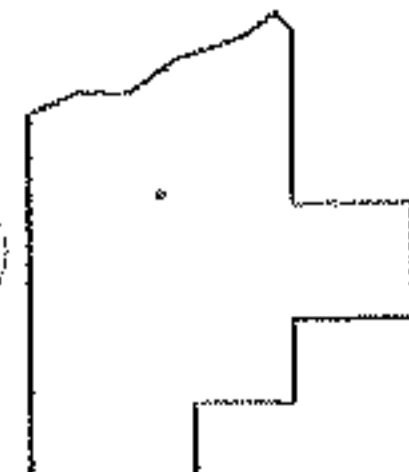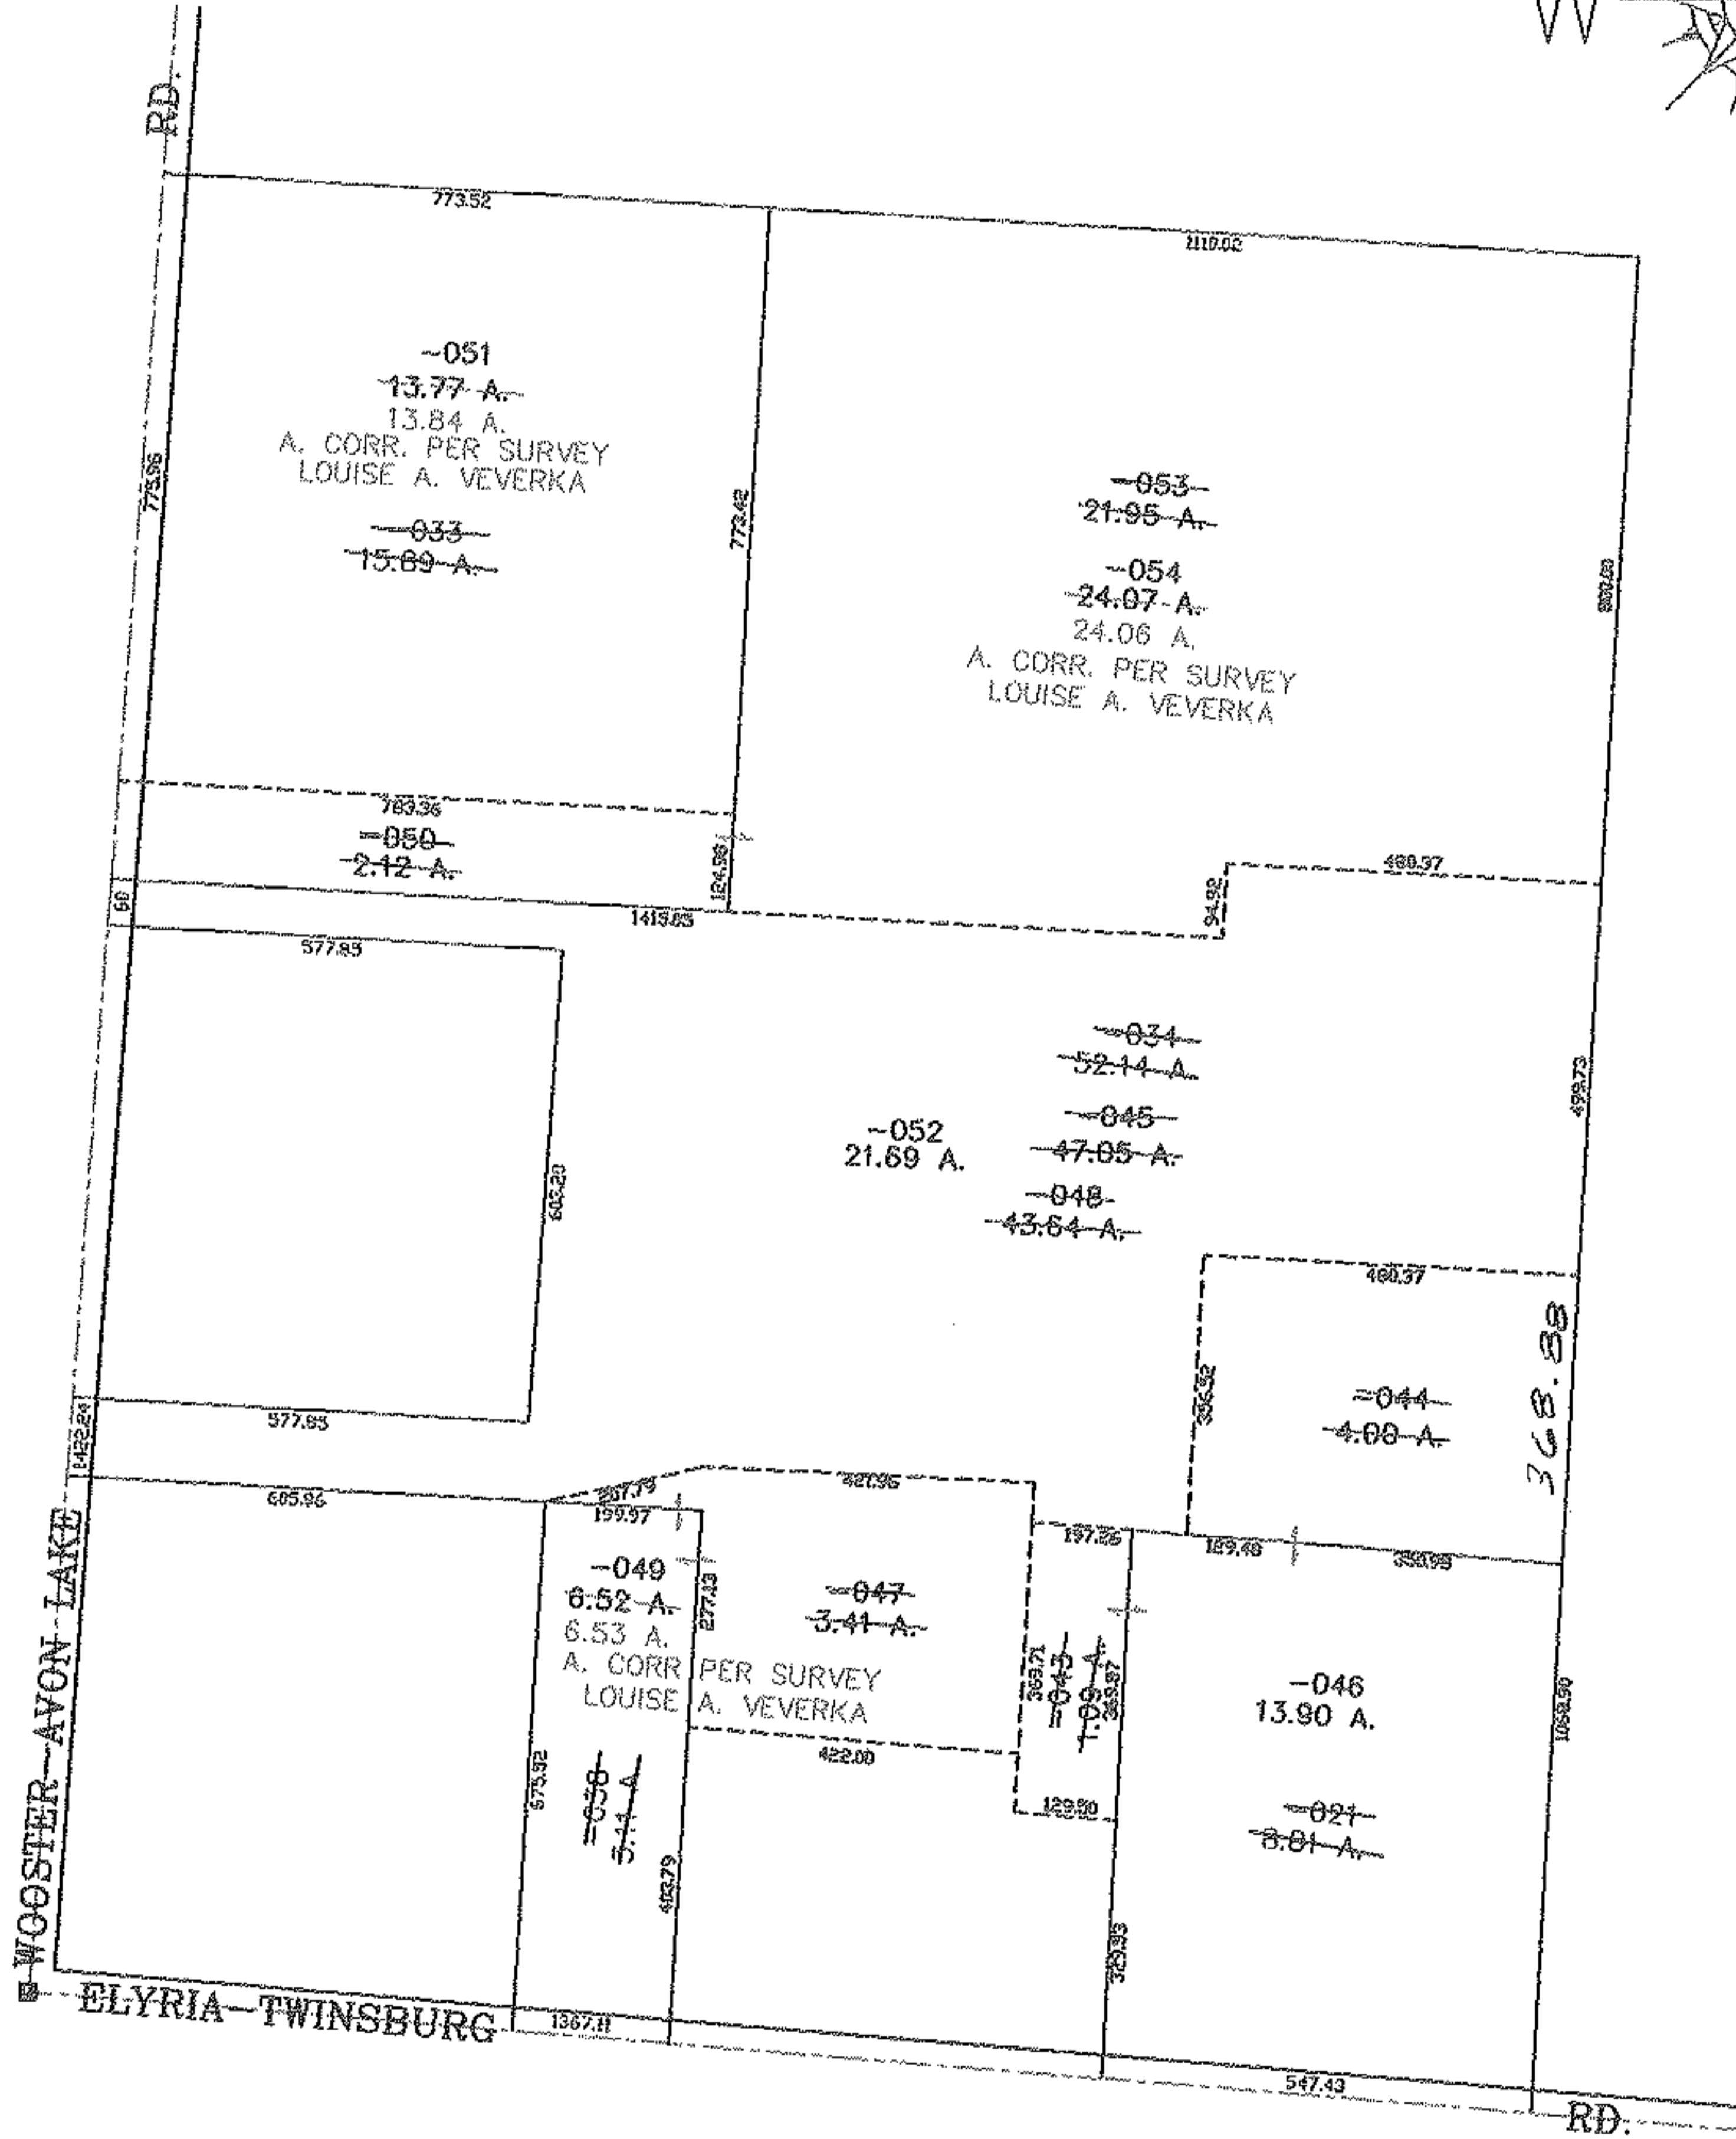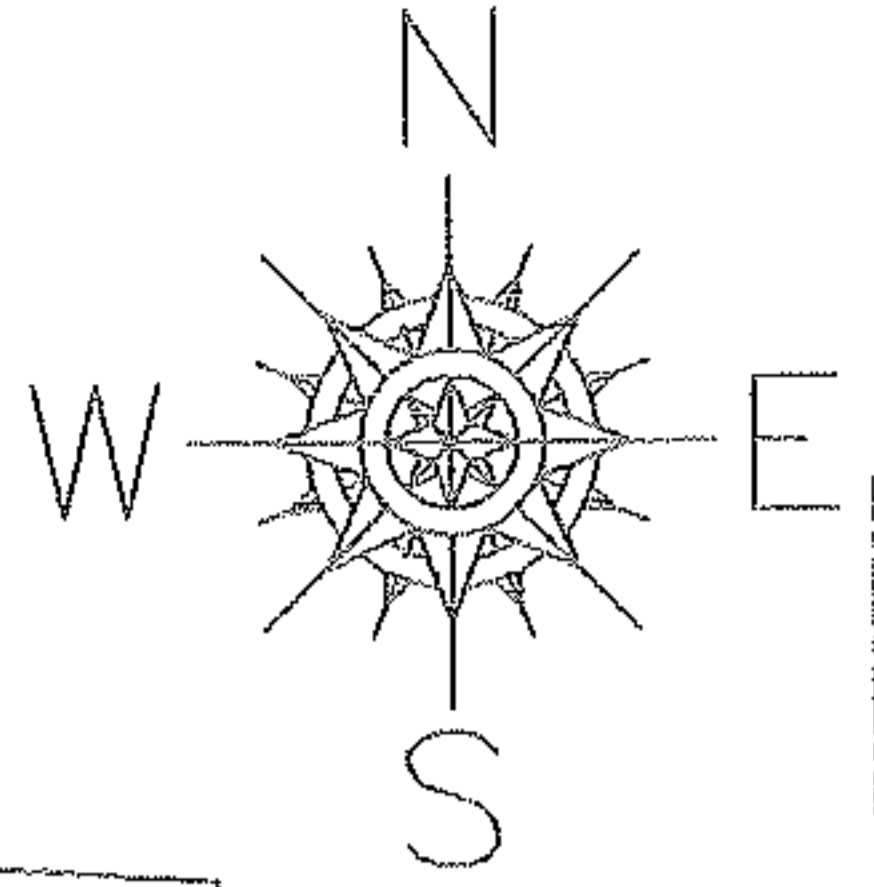

SPLITS/DEEDS PROCESSED
LORAIN COUNTY TAX MAP DEPARTMENT
226 MIDDLE AVE. ELYRIA, OHIO

SURVEYED BY: LOUISE A. VEVERKA
CLOSURE: 0.00 : 10.000
MAP PAGE(S): 11-00-046-A
APPROVED BY: JAH DATE: 6-30-04
SCALE: 1" = 400 PRIOR INSTRUMENT: OR 603/117