




RASTER

PARENT PARCEL: 02-01-003-270-031

NO. 01695

CHILD PARCEL: 02-01-003-270-033, -034

STARTING POINT: CENTERLINE OF CHERRYWOOD DR. & COOPER FOSTER PK RD.

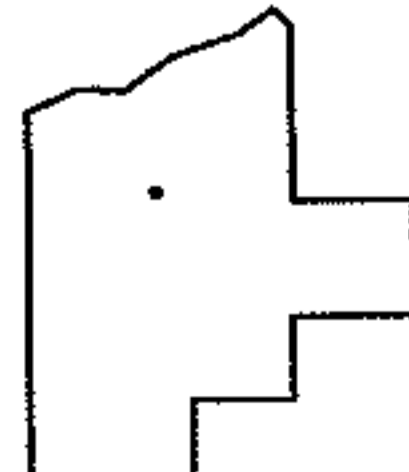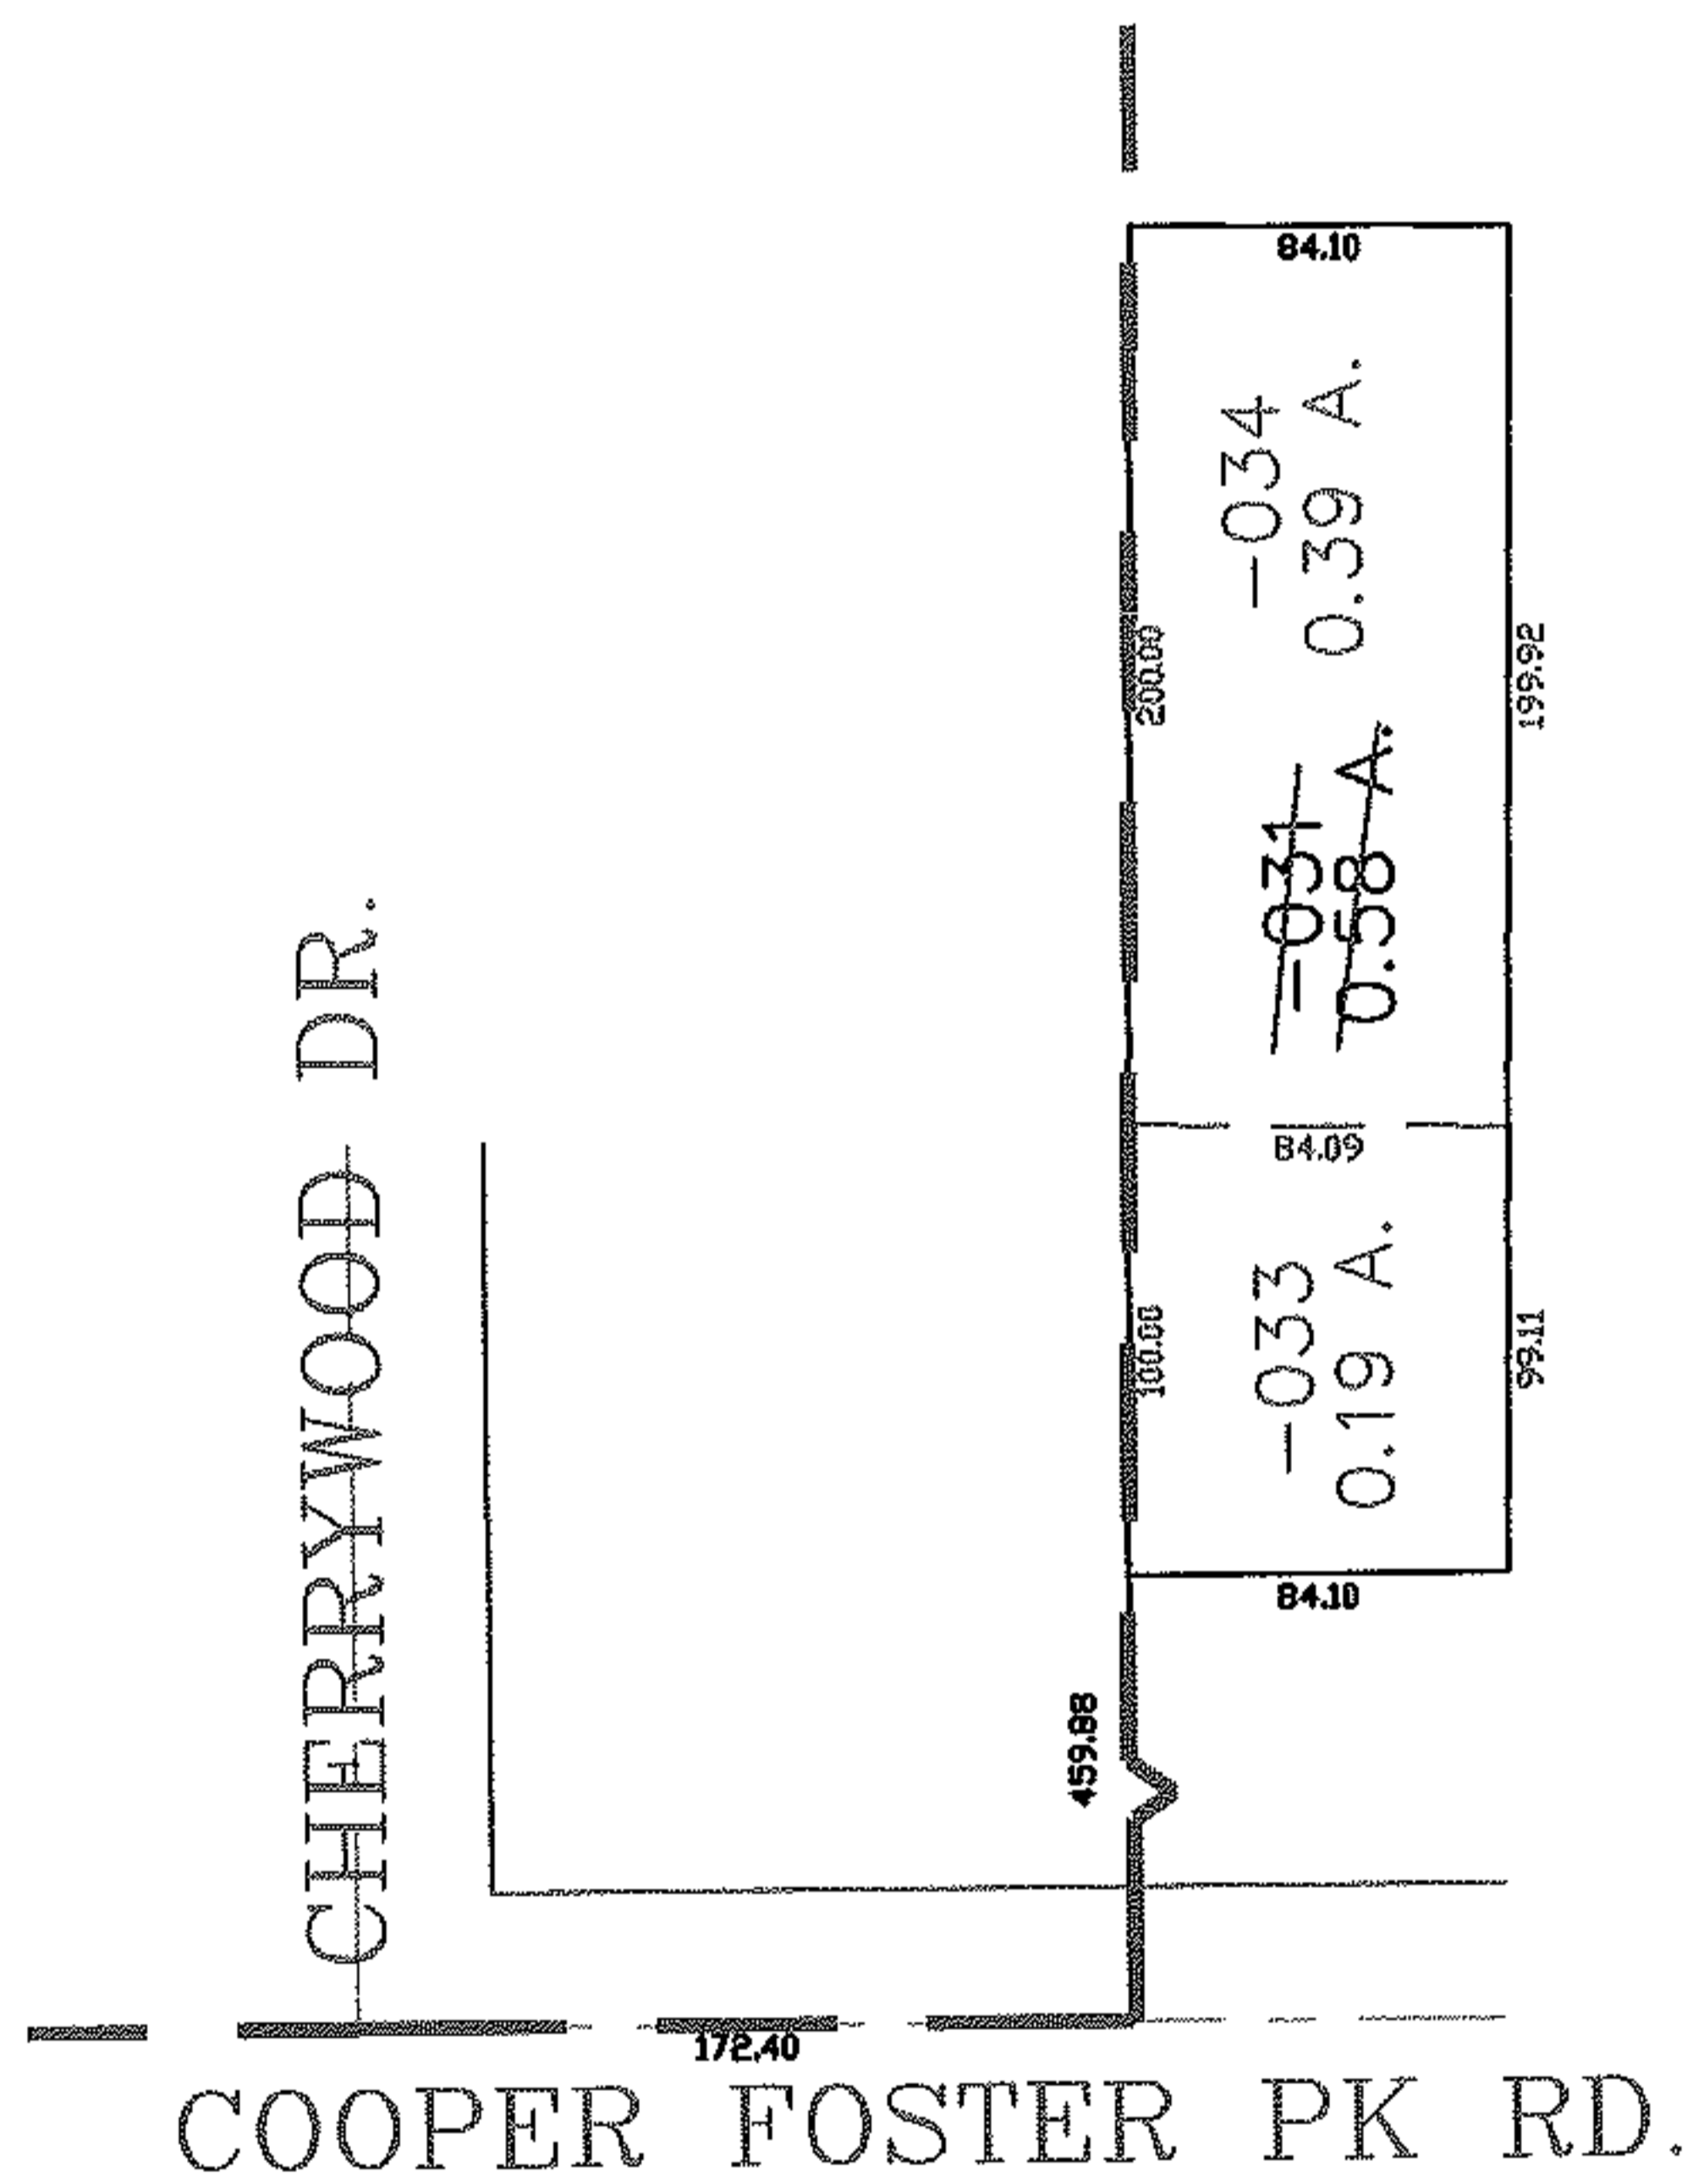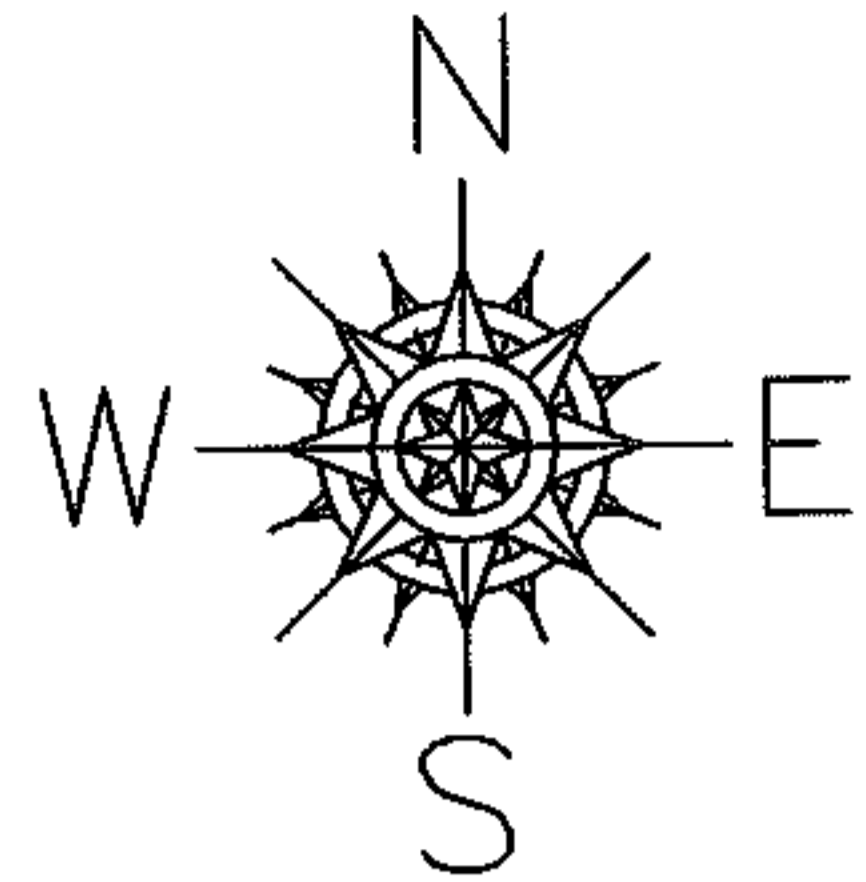

SPLITS/DEEDS PROCESSED

LORAIN COUNTY TAX MAP DEPARTMENT
226 MIDDLE AVE. ELYRIA, OHIO

SURVEYED BY: THOMAS A. SIMON
 CLOSURE: 0.00 : 10.000
 MAP PAGE(S): 02-01-003-N
 APPROVED BY: JAH DATE: 7-2-04
 SCALE: 1" = 100 PRIOR INSTRUMENT: 20020841415