




RASTER

PARENT PARCEL: 04-00-018-165-021, -049, -050
CHILD PARCEL: 04-00-018-165-053 THRU -056
STARTING POINT: INTERSECTION OF C/L OF HUNTER RD. AND C/L OF ARMOUR RD.

NO. 01698

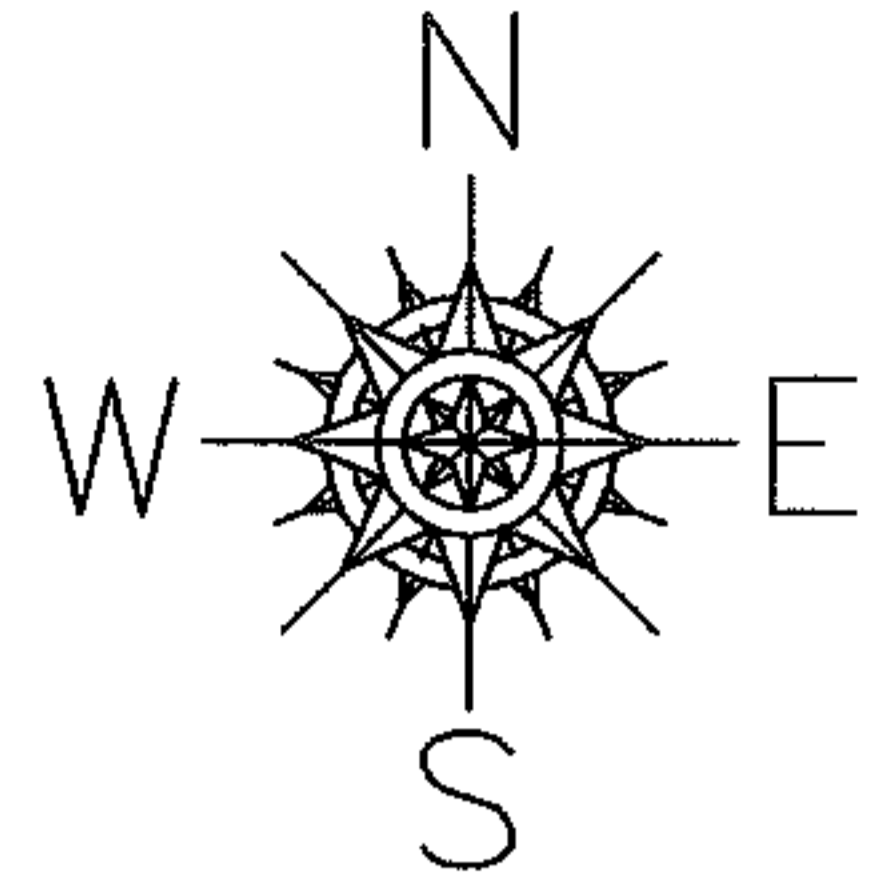

BELDEN PARK SUB.
VOL.12 PG.8-9

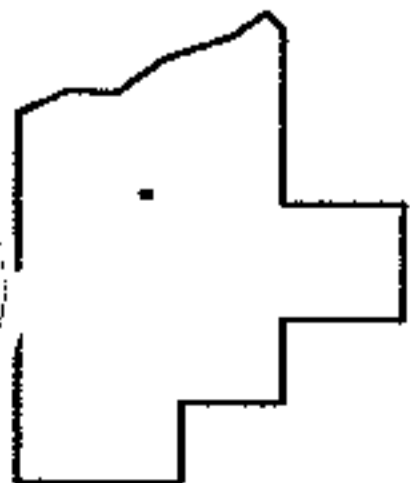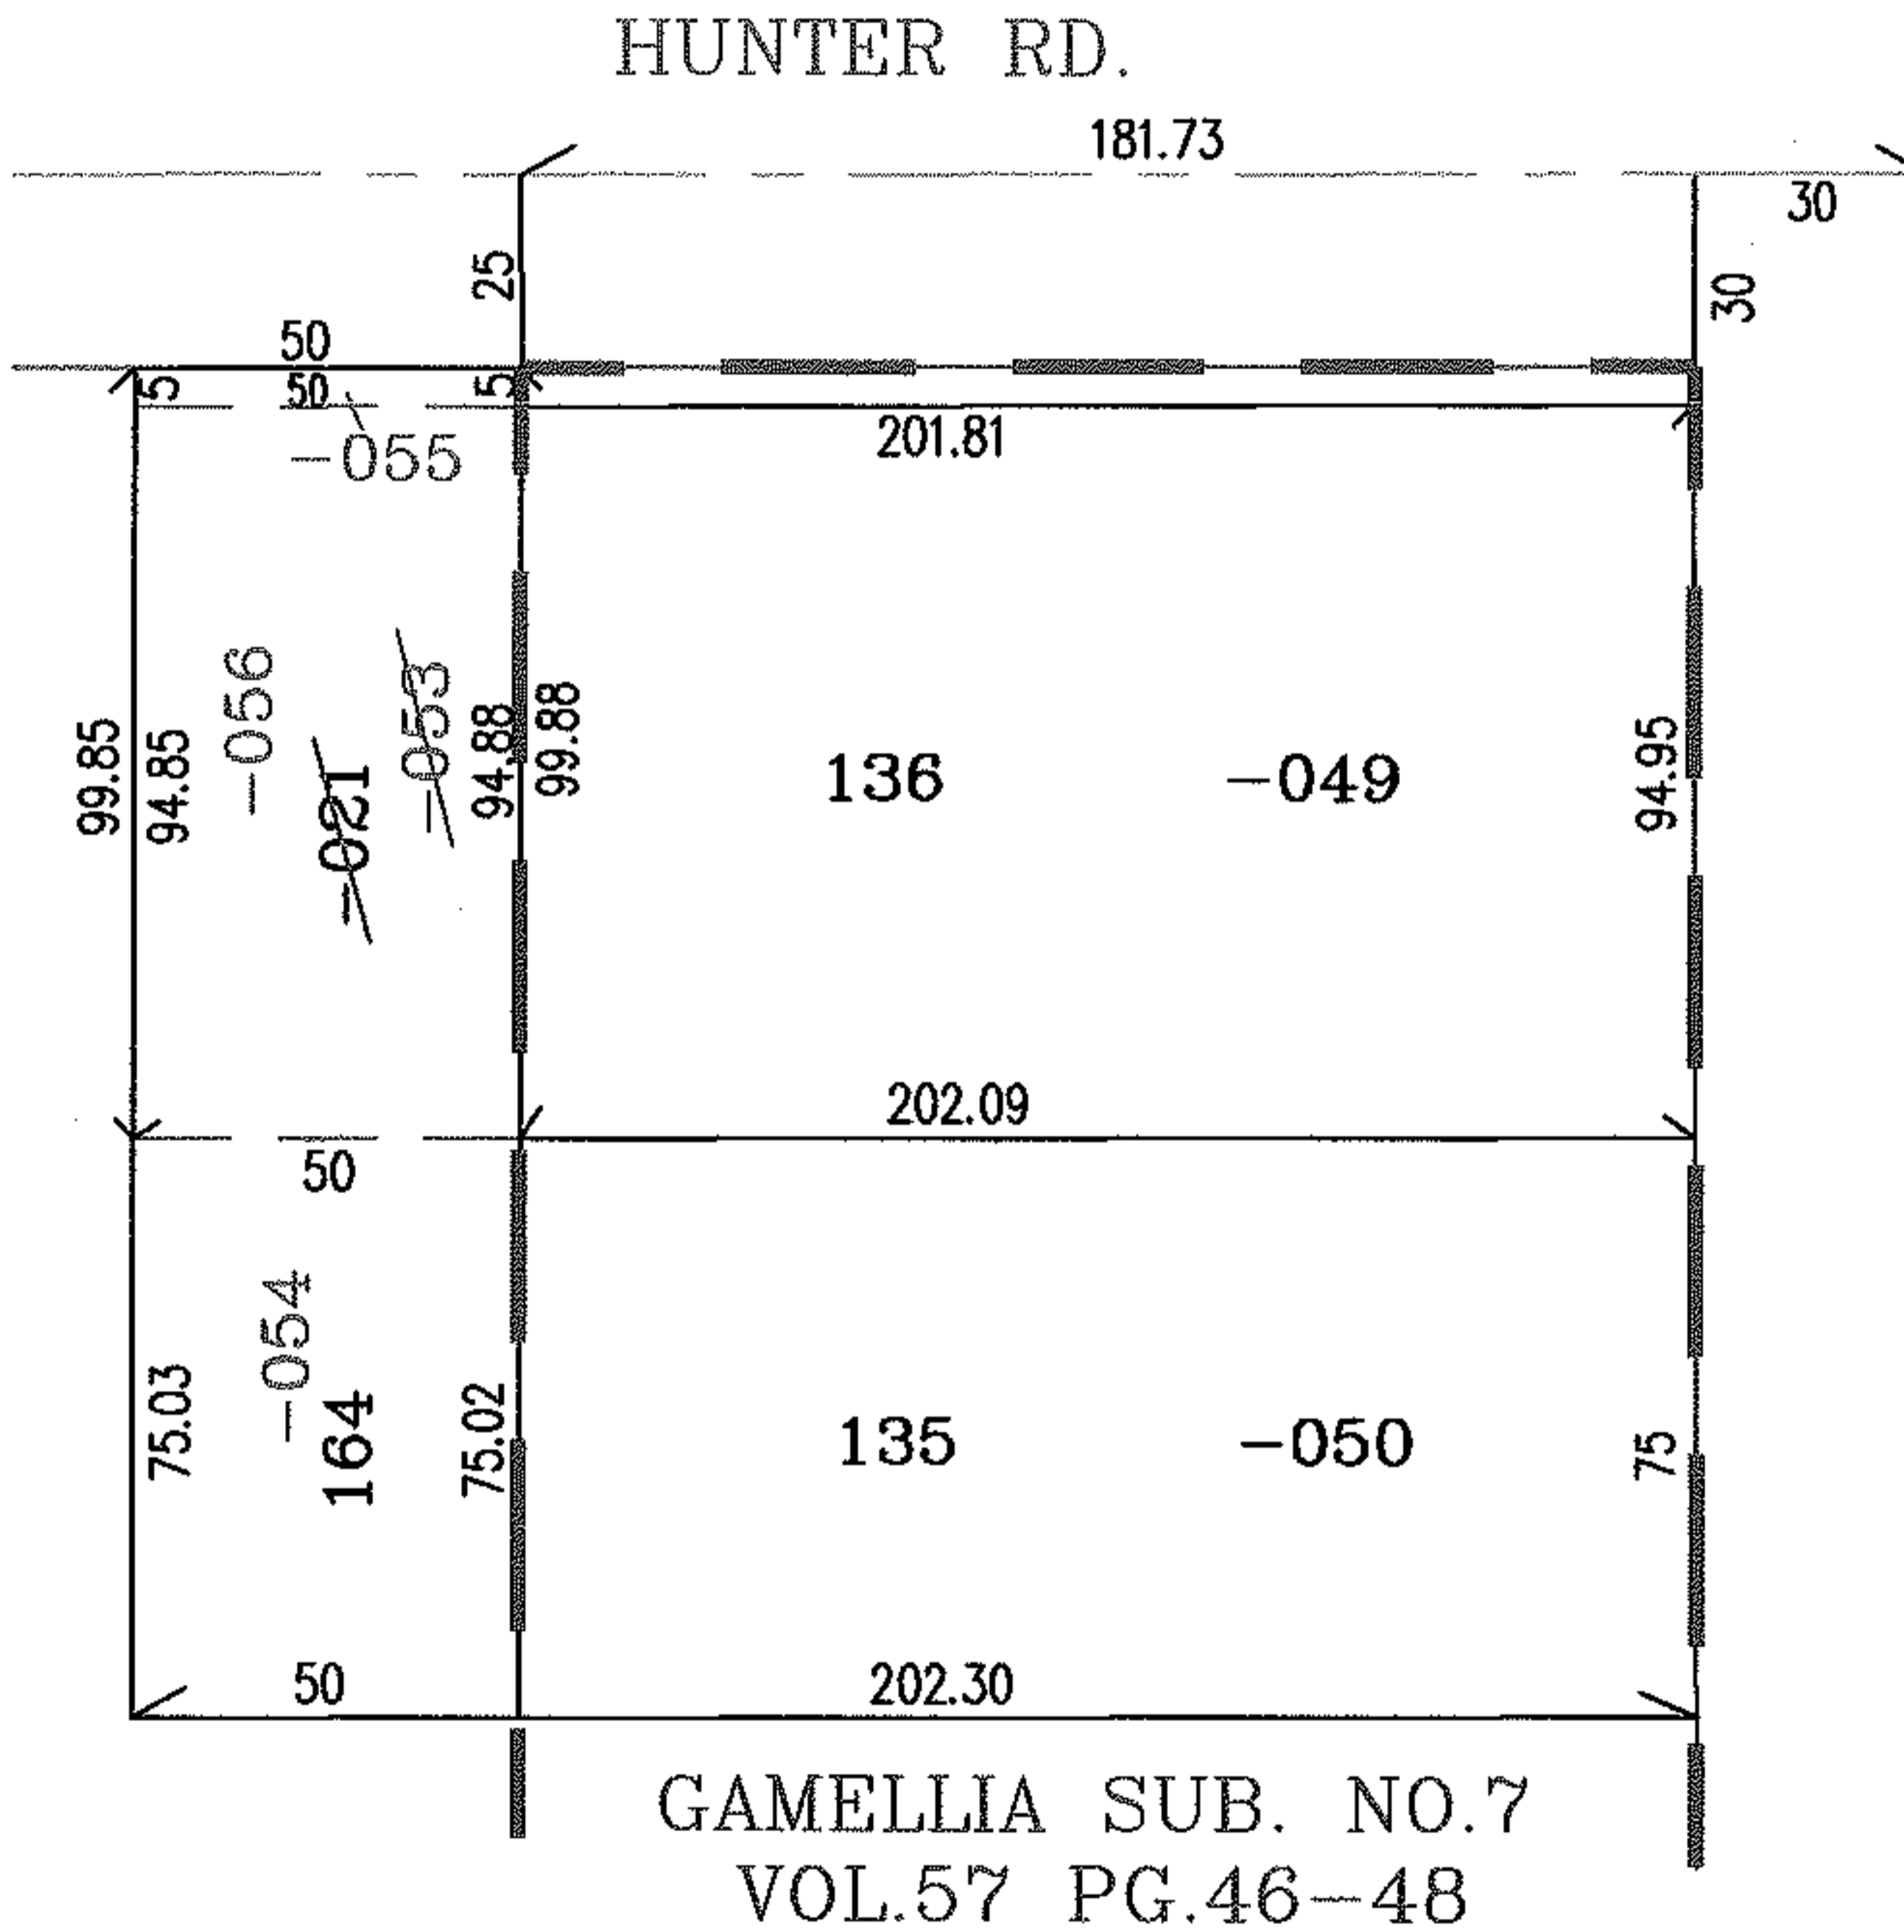

SPLITS/DEEDS PROCESSED

LORAIN COUNTY TAX MAP DEPARTMENT
226 MIDDLE AVE. ELYRIA, OHIO

SURVEYED BY: JAMES A. RESAR
CLOSURE: .00:10.000
MAP PAGE(S): 4-00-018-C
APPROVED BY: RRM DATE: 9-17-04
SCALE: 1" = 50' PRIOR INSTRUMENT: 20030880504