
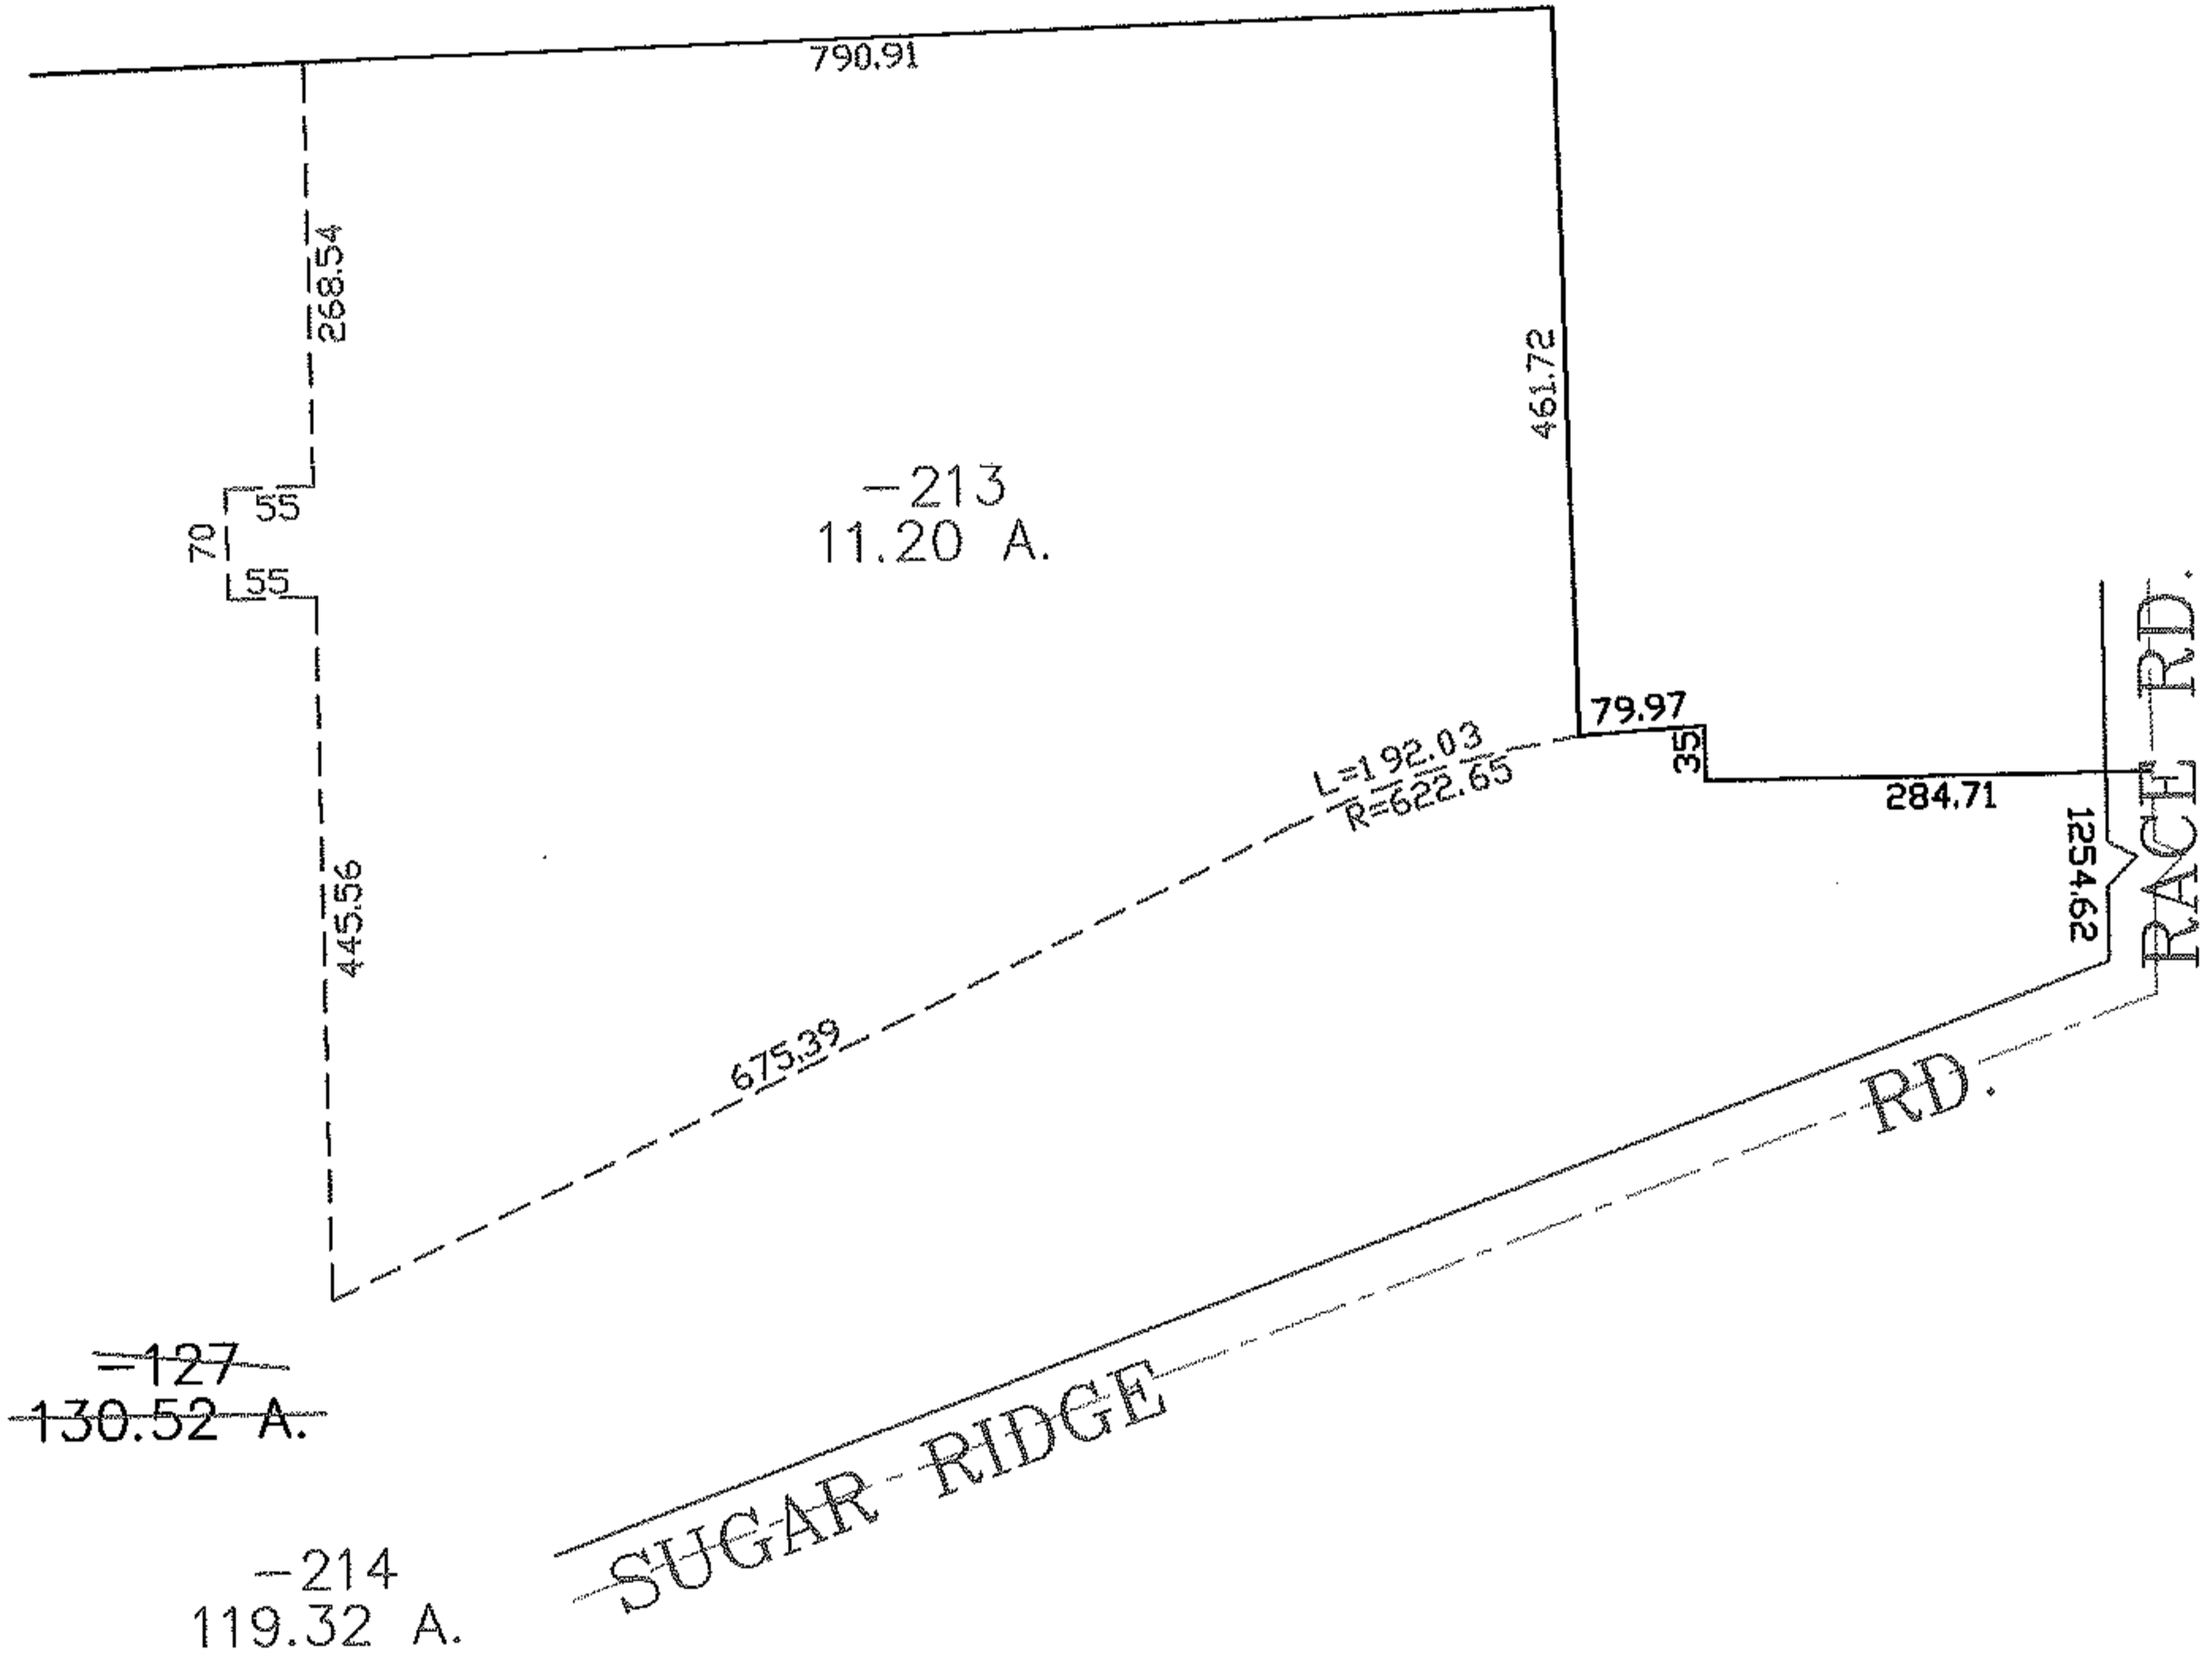


PARENT PARCEL: 07-00-038-000-127

CHILD PARCEL: 07-00-038-000-213, -214

STARTING POINT: CENTERLINE OF RACE RD. & SUGAR RIDGE RD.

NO. 01699

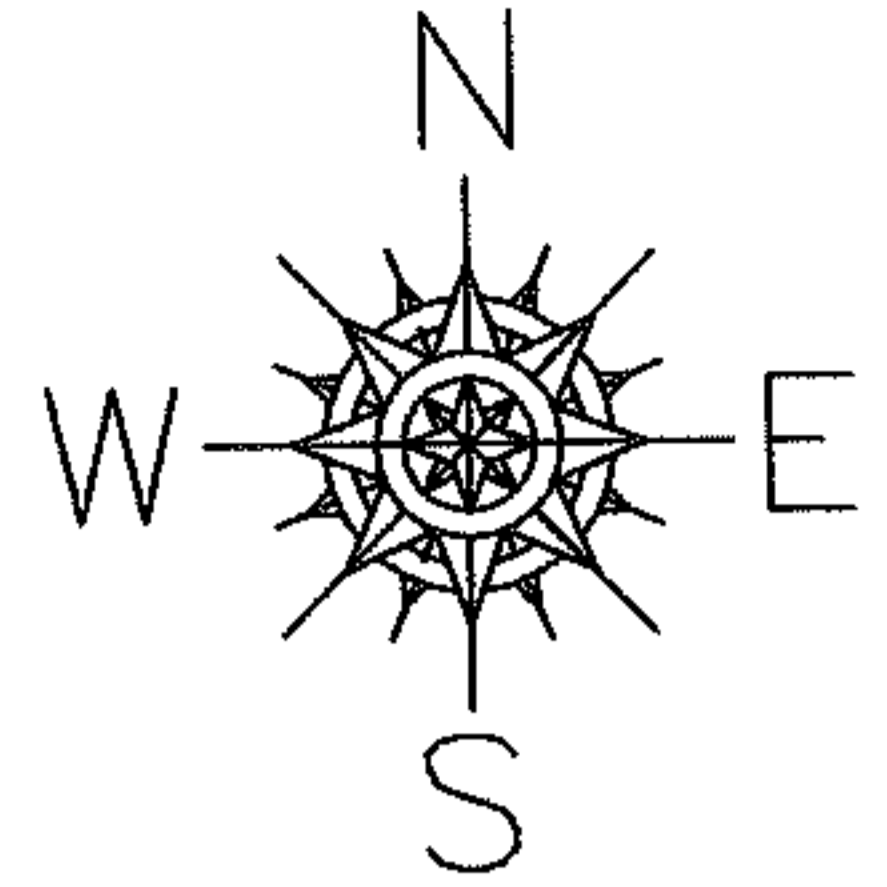

SURVEYED BY: MARK ALLEN YEAGER
 CLOSURE: 0.00 : 10.000
 MAP PAGE(S): 07-00-038-B
 APPROVED BY: JAH DATE: 7-13-04
 SCALE: 1" = 200 PRIOR INSTRUMENT: 980524293

SPLITS/DEEDS PROCESSED
 LORAIN COUNTY TAX MAP DEPARTMENT
 226 MIDDLE AVE. ELYRIA, OHIO

ORIGINAL