




MASTER

PARENT PARCEL: 03-00-033-115-008

CHILD PARCEL: 03-00-033-115-031,-032

STARTING POINT: INTERSECTION OF C/L OF ABBE RD. AND SOUTHERLY LINE OF O.L.33

NO. 01700

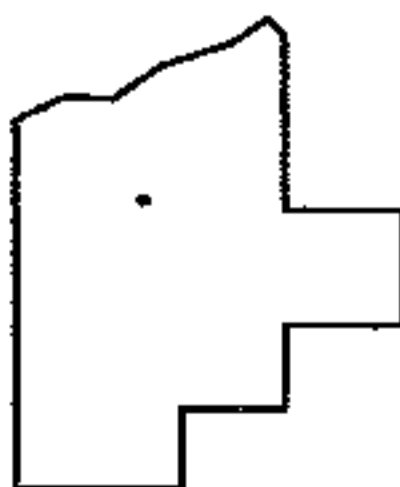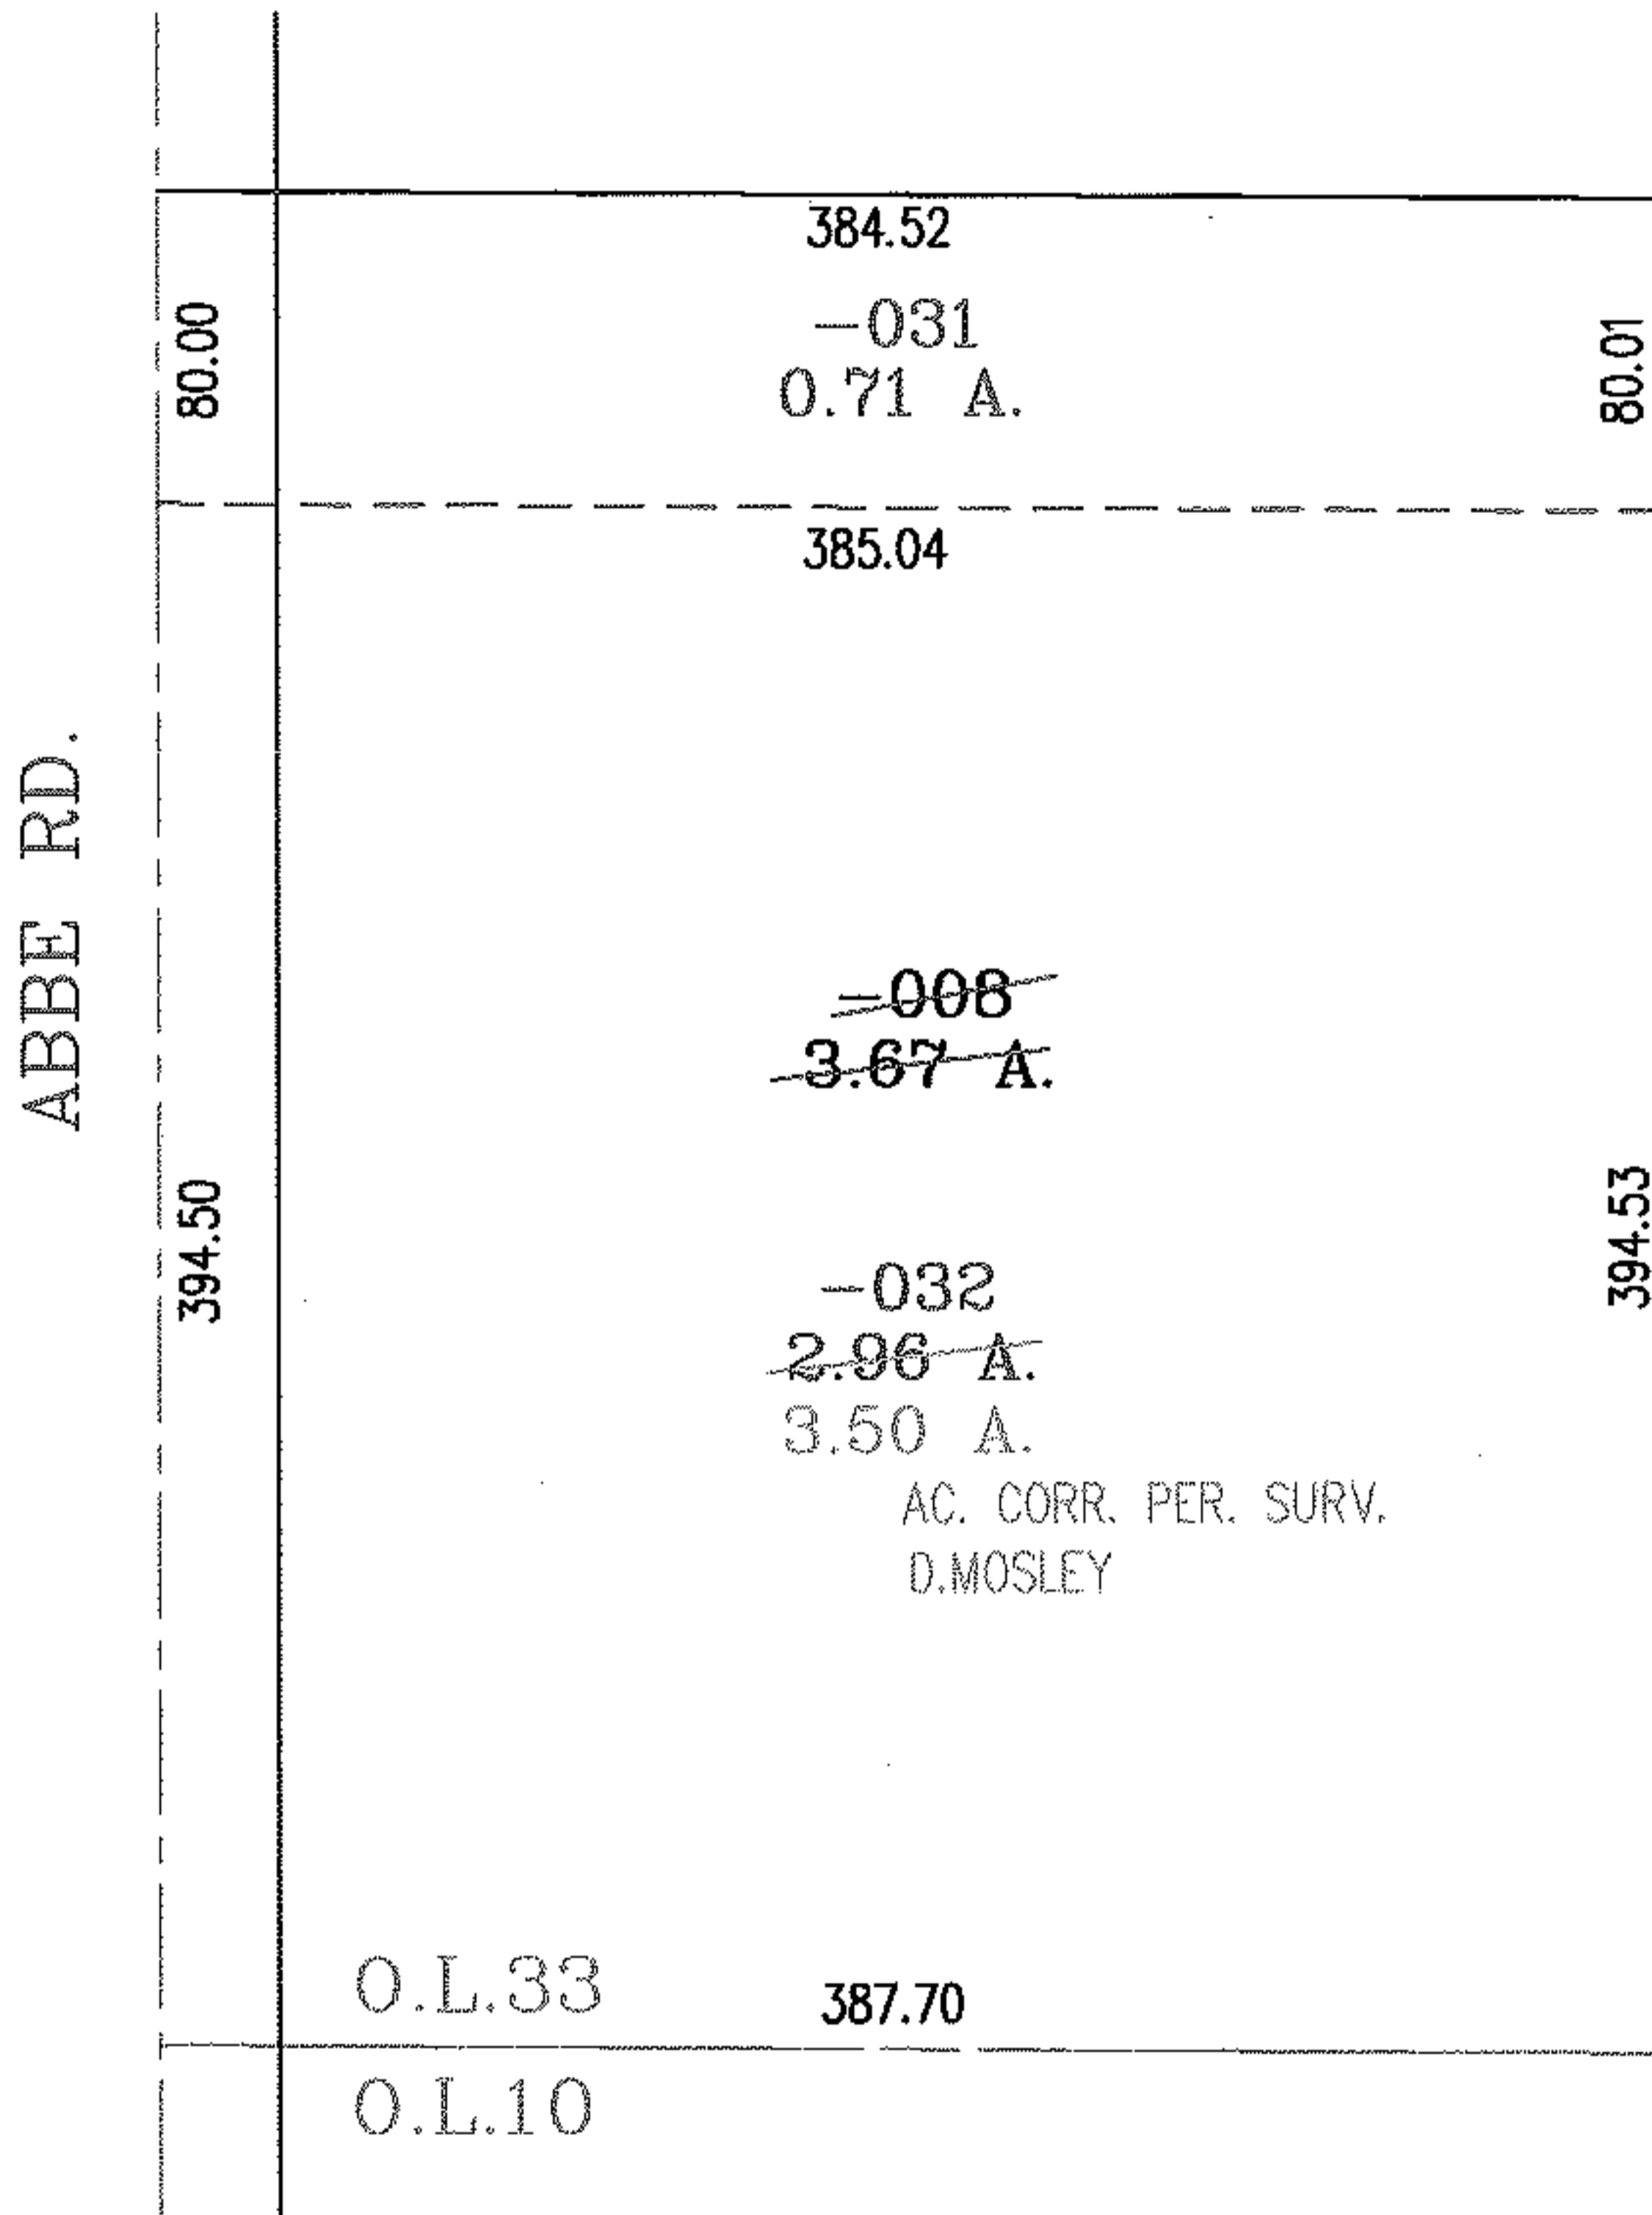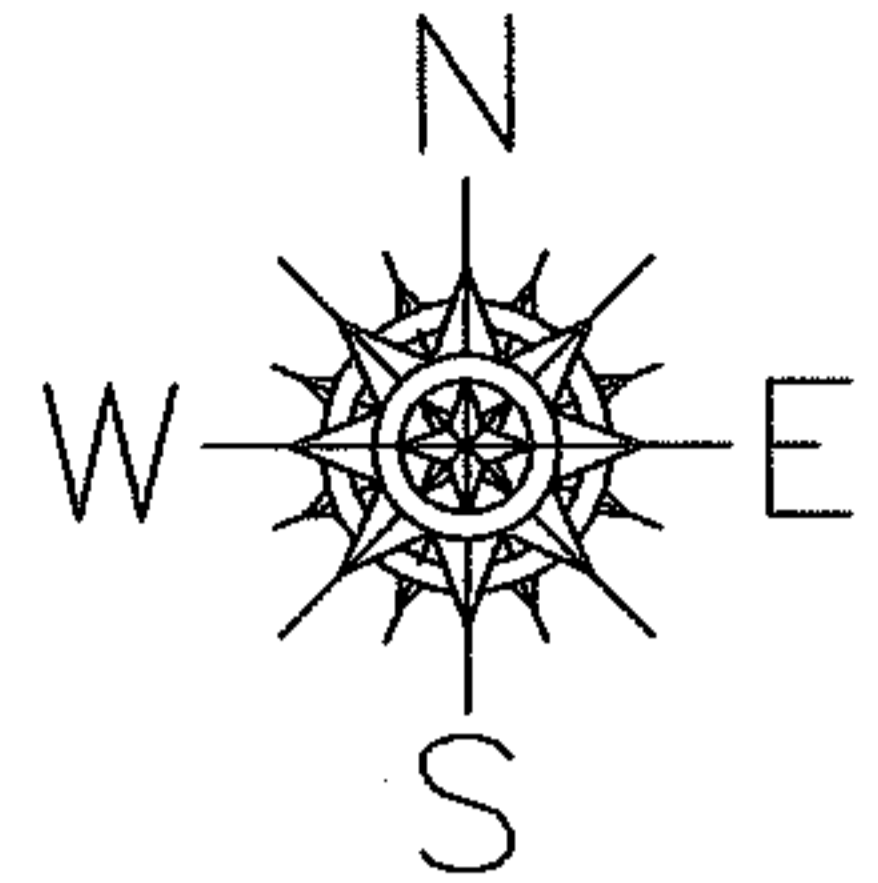

SPLITS/DEEDS PROCESSED

LORAIN COUNTY TAX MAP DEPARTMENT
226 MIDDLE AVE. ELYRIA, OHIO

SURVEYED BY: DOUGLAS H. MOSLEY
 CLOSURE: .01:10.000
 MAP PAGE(S): 3-00-033-B
 APPROVED BY: RRM DATE: 7-13-04
 SCALE: 1" = 100 PRIOR INSTRUMENT: 20000698535