




MASTER

PARENT PARCEL: 05-00-057-000-251

CHILD PARCEL: 05-00-057-000-361, -362

STARTING POINT: CENTERLINE OF MIDDLE RIDGE RD. & OBERLIN RD.

NO. 01705

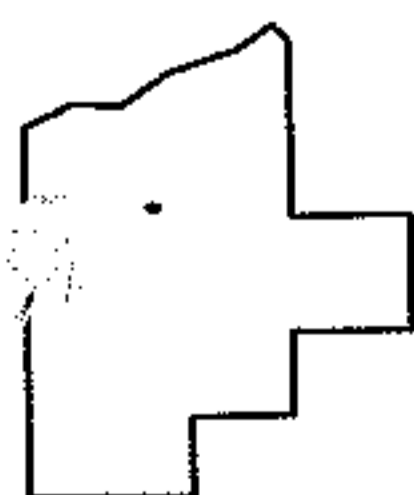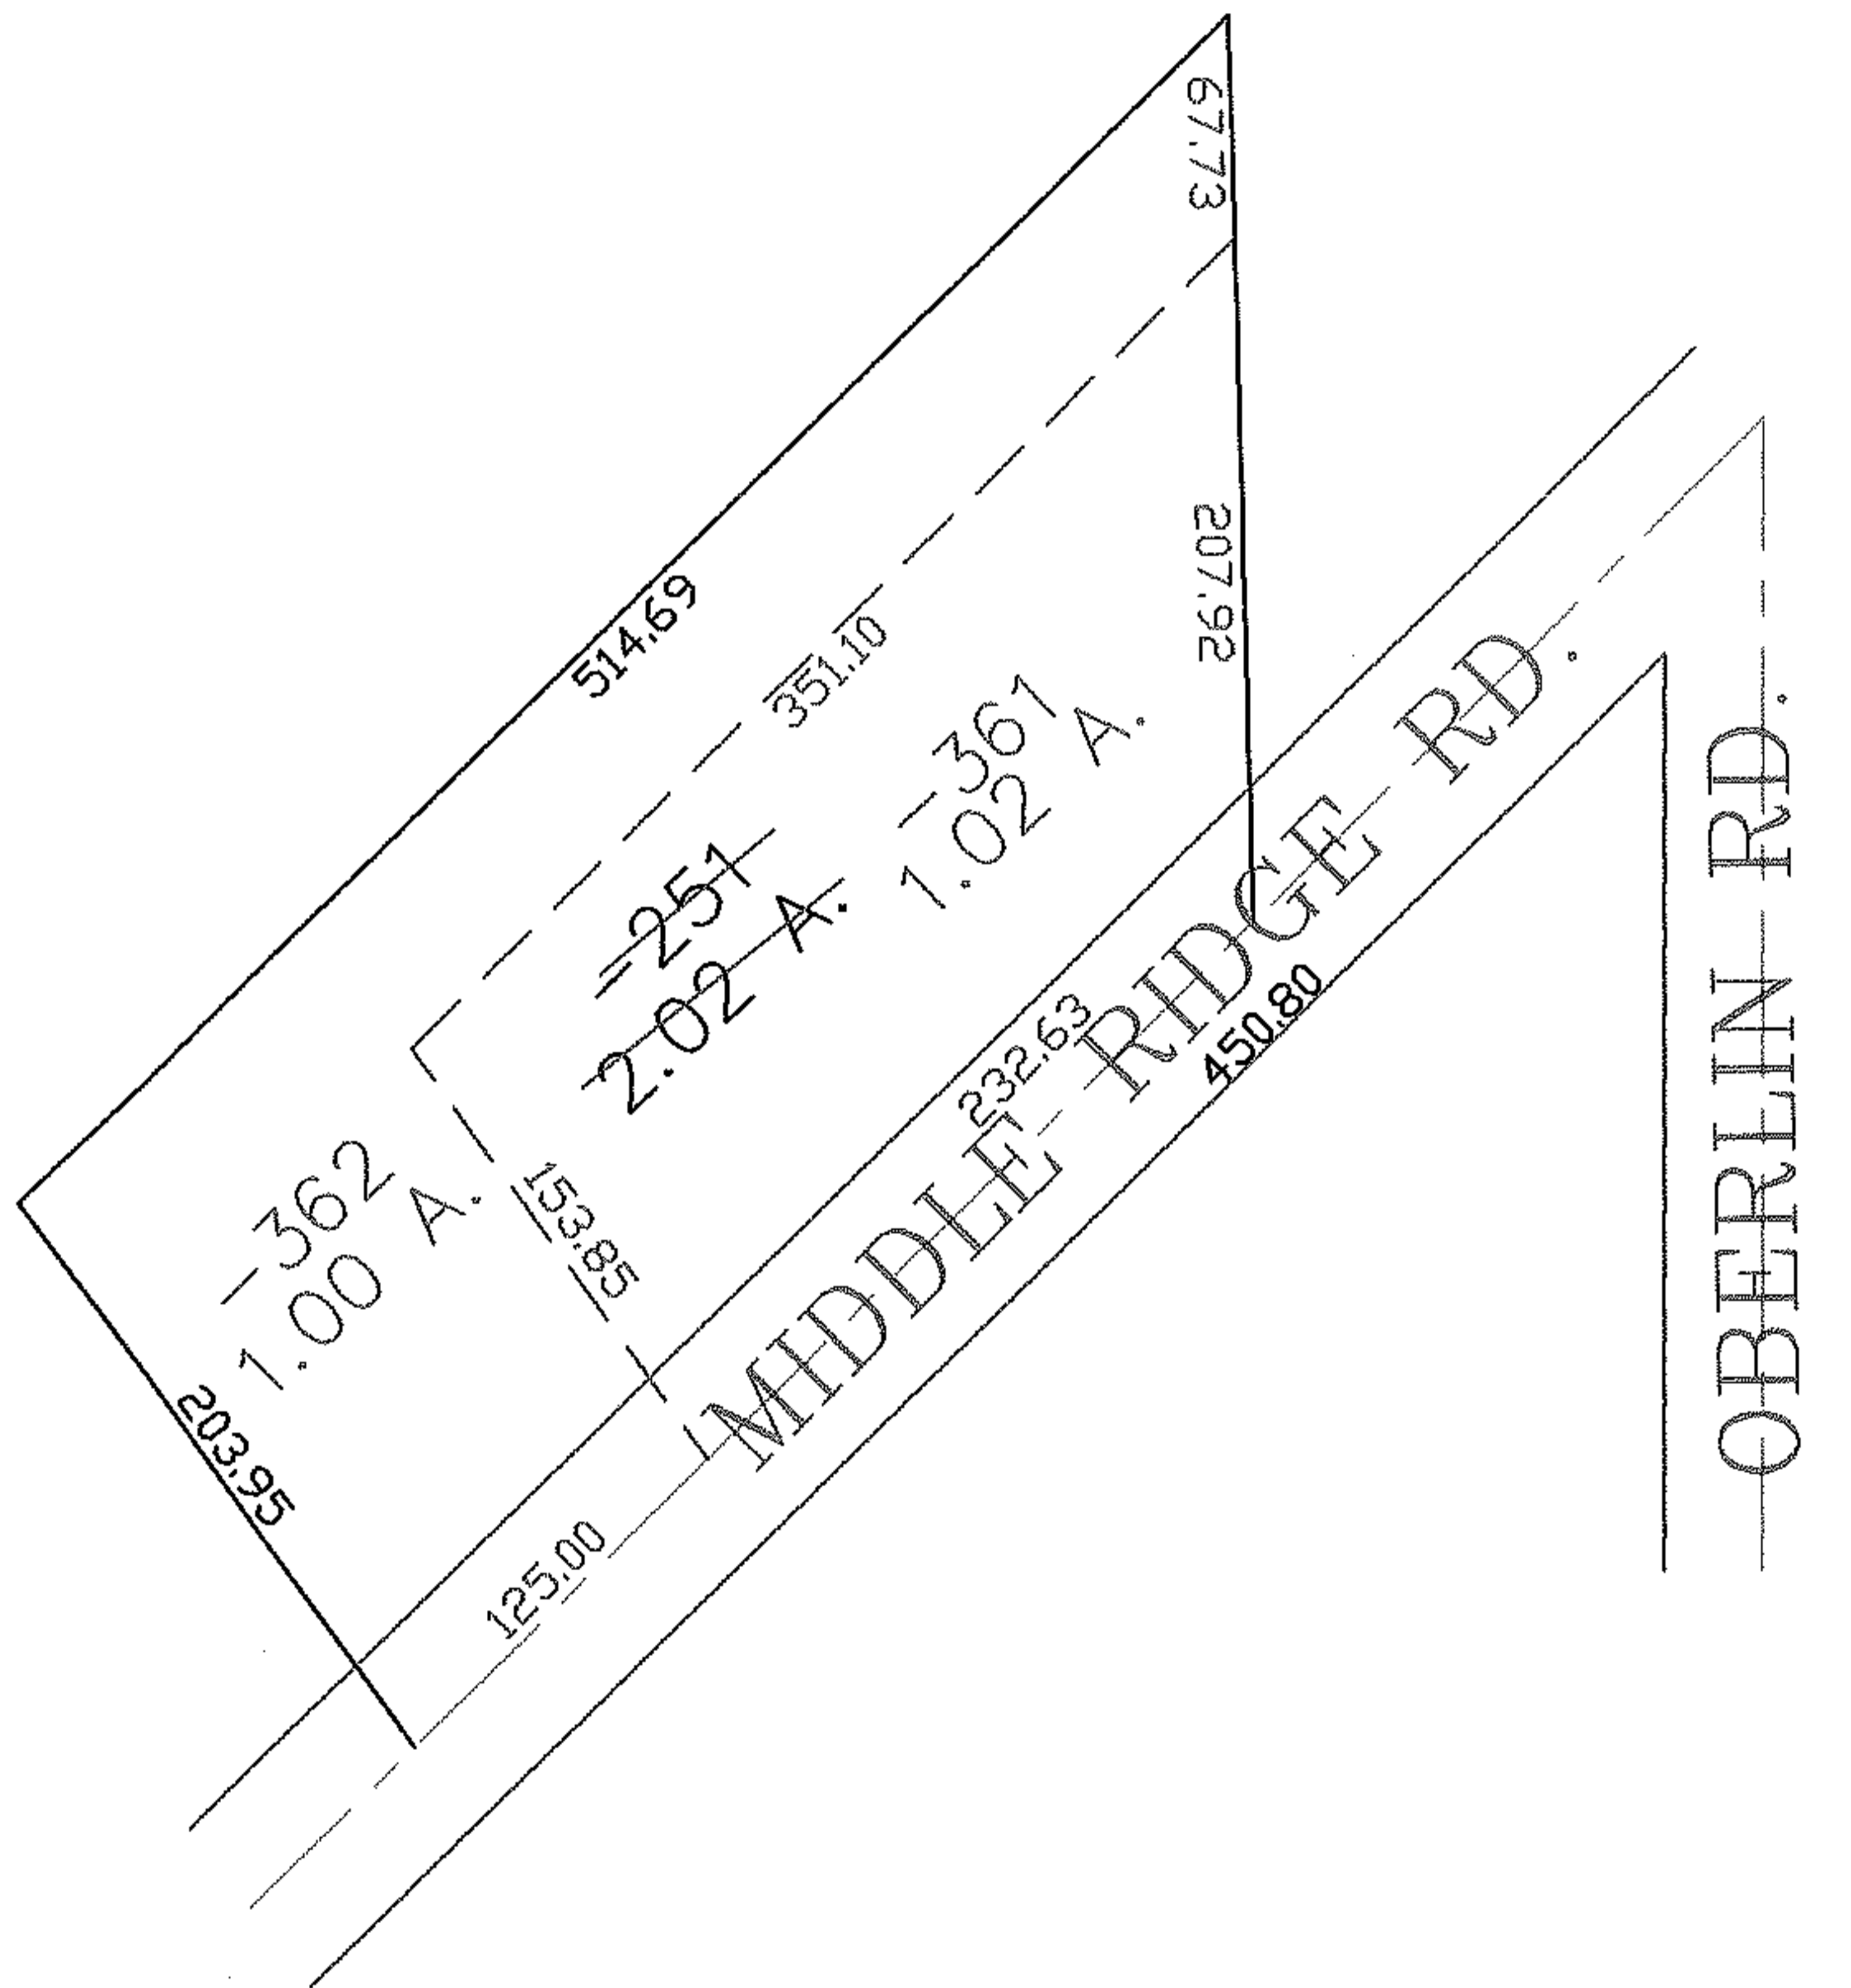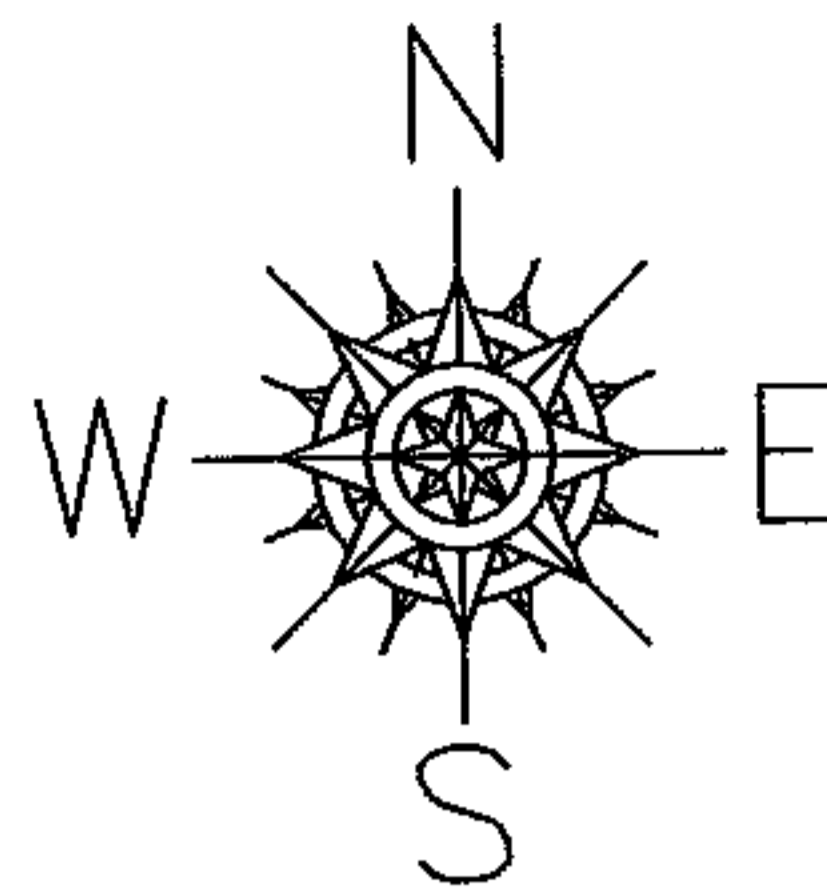

**SPLITS/DEEDS PROCESSED**

LORAIN COUNTY TAX MAP DEPARTMENT  
226 MIDDLE AVE. ELYRIA, OHIO

SURVEYED BY: ALEX KELSER  
 CLOSURE: 0.00 : 10.000  
 MAP PAGE(S): 05-00-057-B  
 APPROVED BY: JAH DATE: 7-15-04  
 SCALE: 1" = 100' PRIOR INSTRUMENT: 20020875889