




RASTER

PARENT PARCEL: 03-00-011-102-084

CHILD PARCEL: 03-00-011-102-122, -123

STARTING POINT: CENTERLINE OF ABBE RD. & O.L. 11

NO. 01722

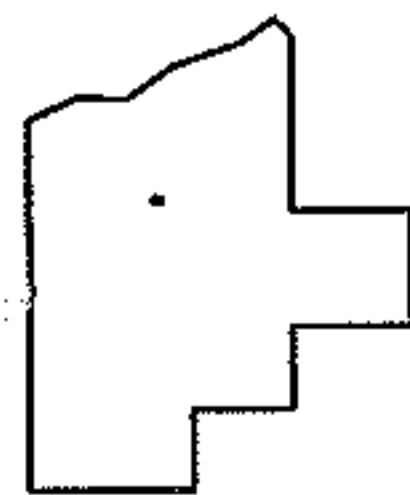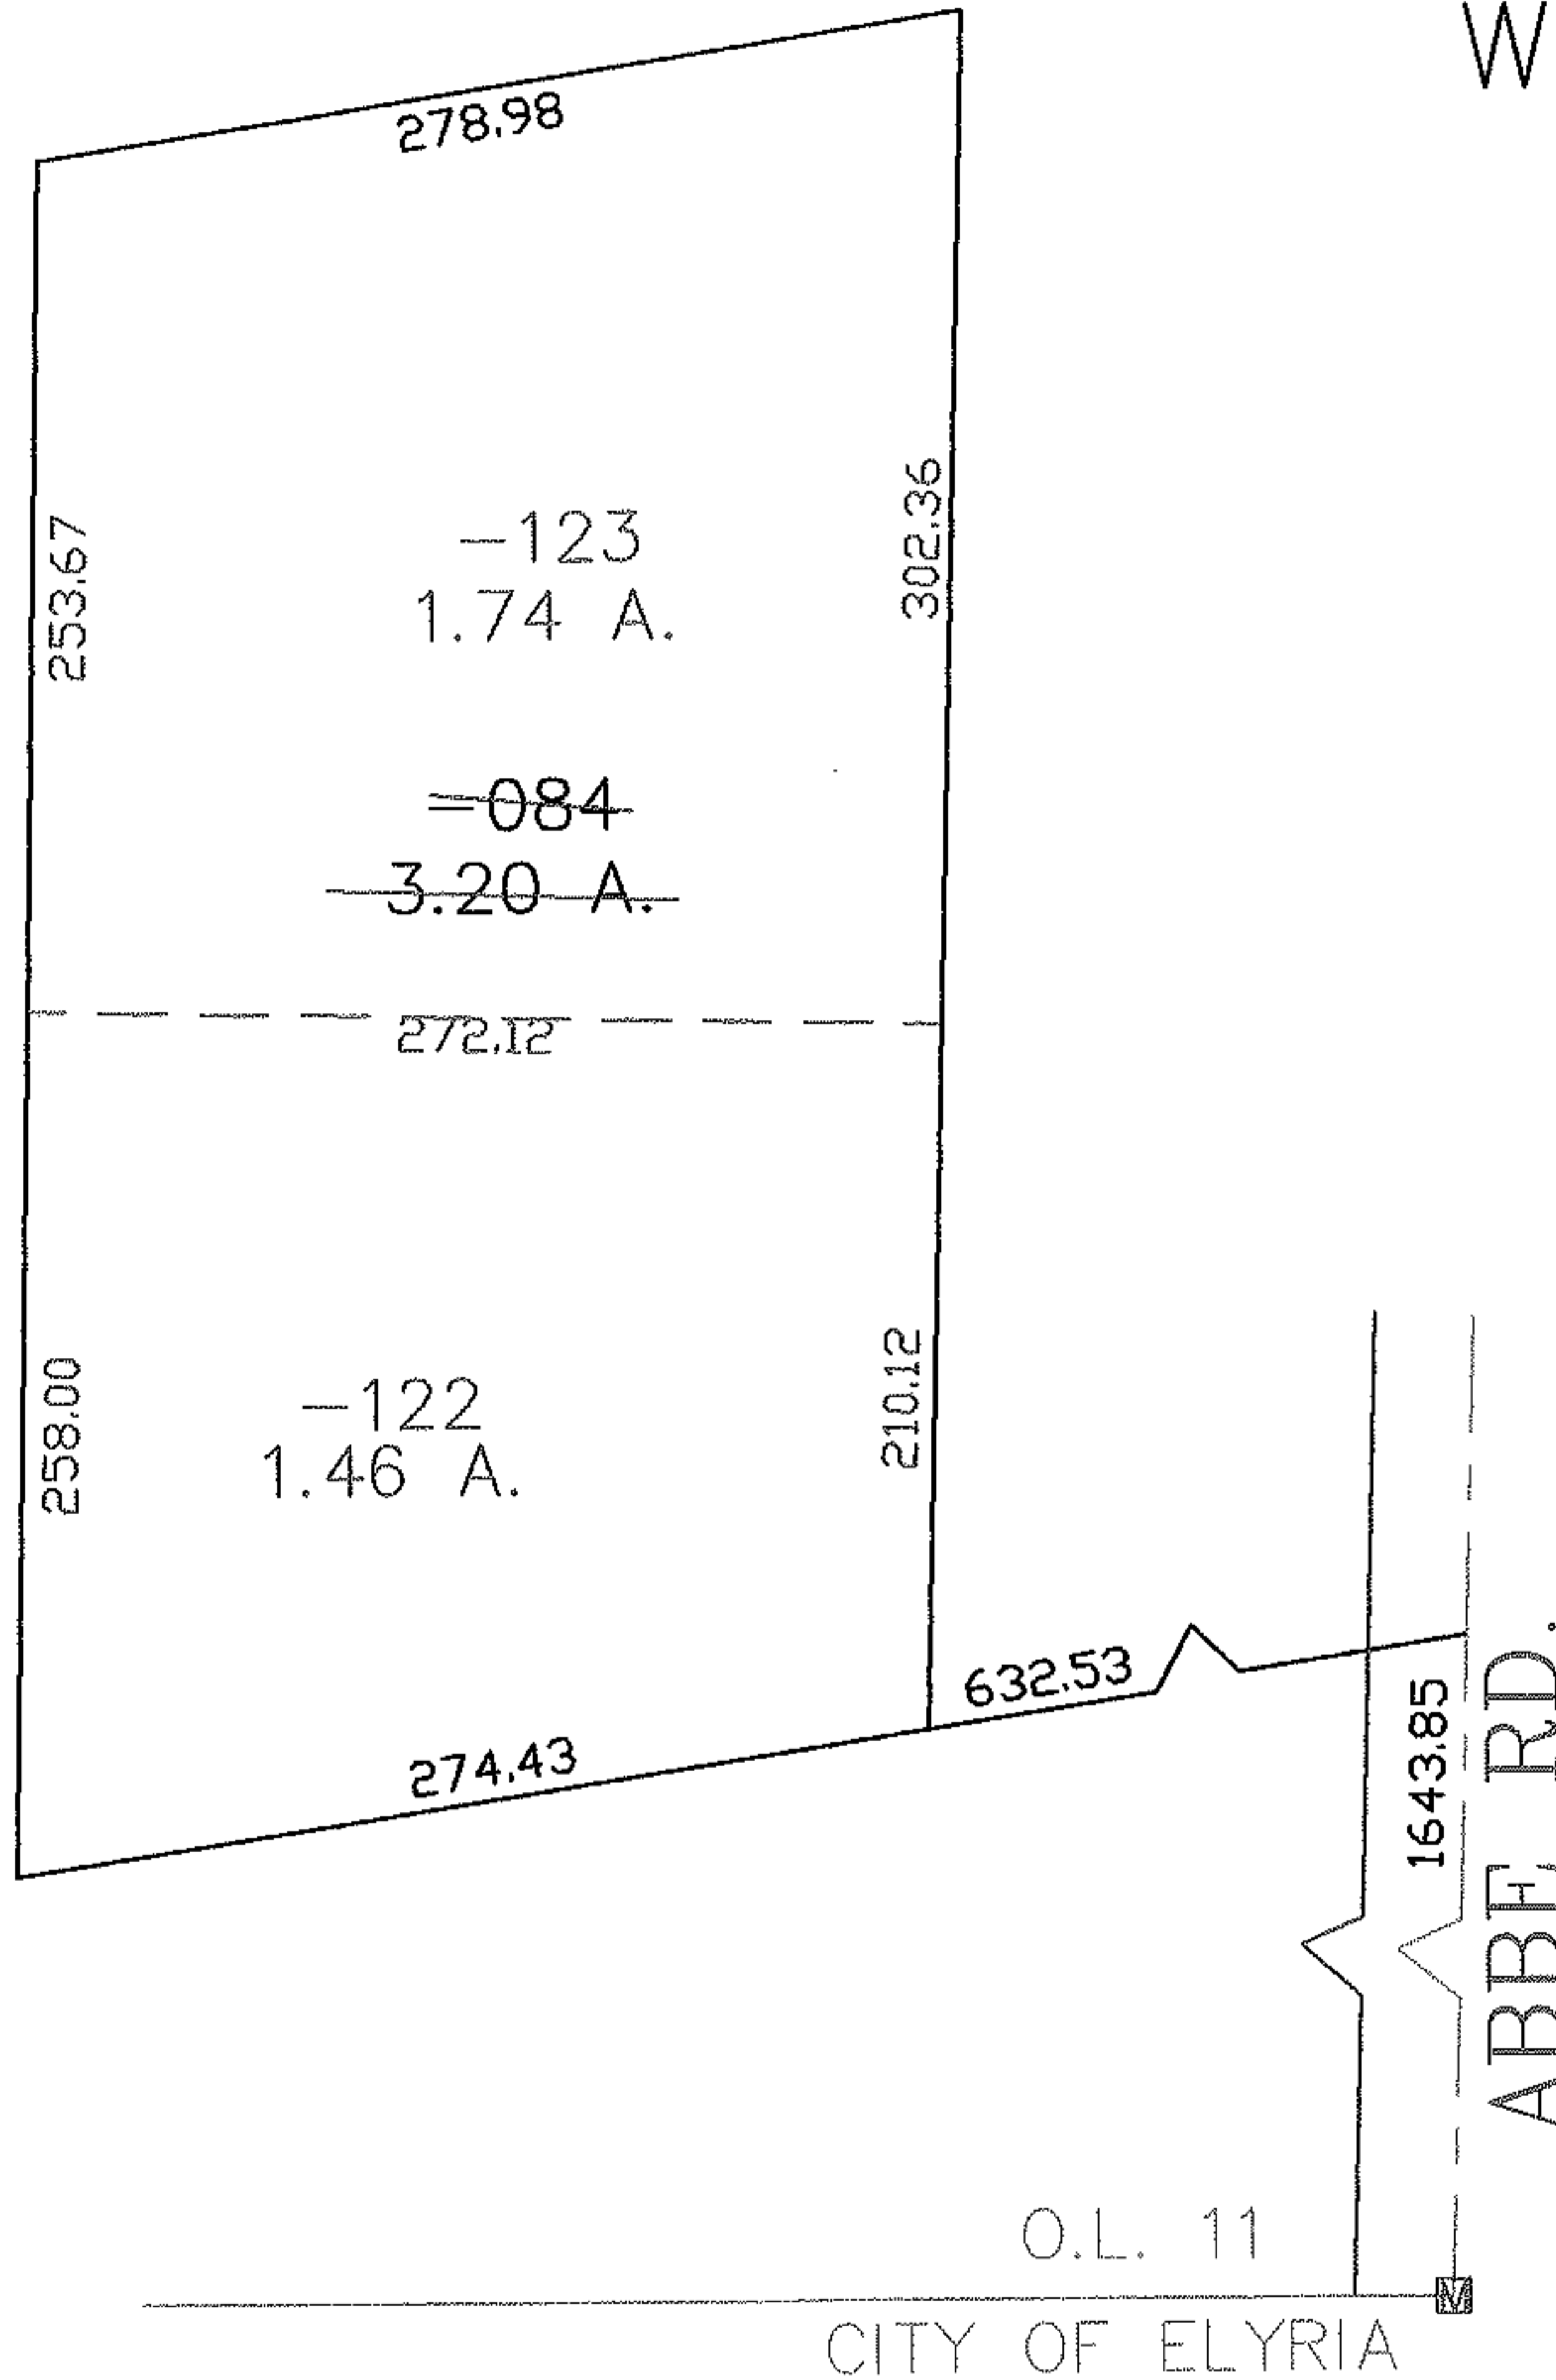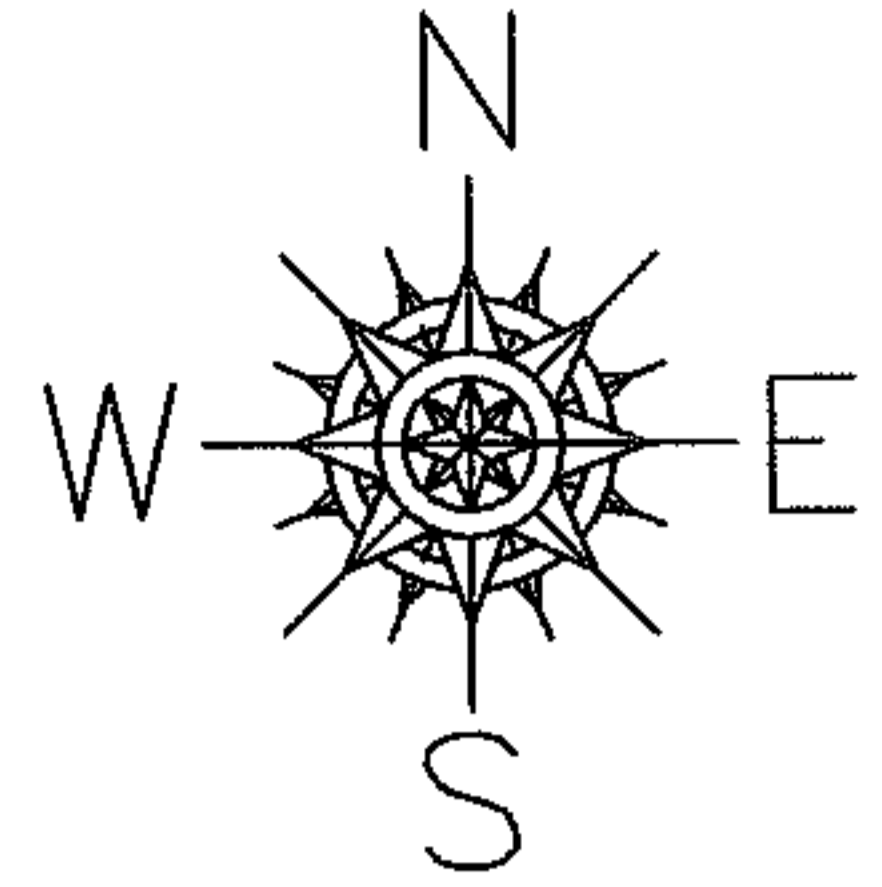

**SPLITS/DEEDS PROCESSED**

LORAIN COUNTY TAX MAP DEPARTMENT  
226 MIDDLE AVE. ELYRIA, OHIO

SURVEYED BY: JAMES A. RESAR

CLOSURE: 0.00 : 10.000

MAP PAGE(S): 3-00-011-B

APPROVED BY: JAH DATE: 8-4-04

SCALE: 1" = 100 PRIOR INSTRUMENT: 20020877582