

EASTER




PARENT PARCEL: \* SEE BELOW

CHILD PARCEL: 05-00-078-000-043

STARTING POINT: CENTERLINE OF STANG RD. & O.L. 78, 63, 64 77

NO. 01730

- \* 05-00-078-000-024, -033
- 05-00-063-104-047
- 05-00-064-000-008
- 05-00-077-000-001

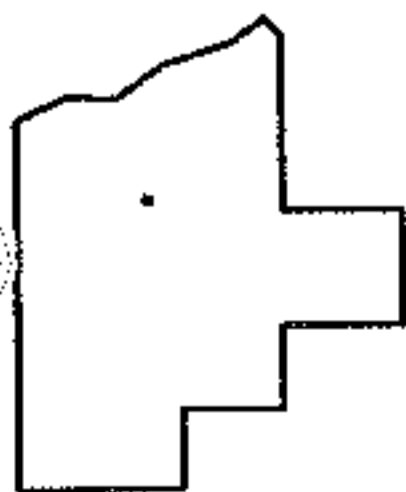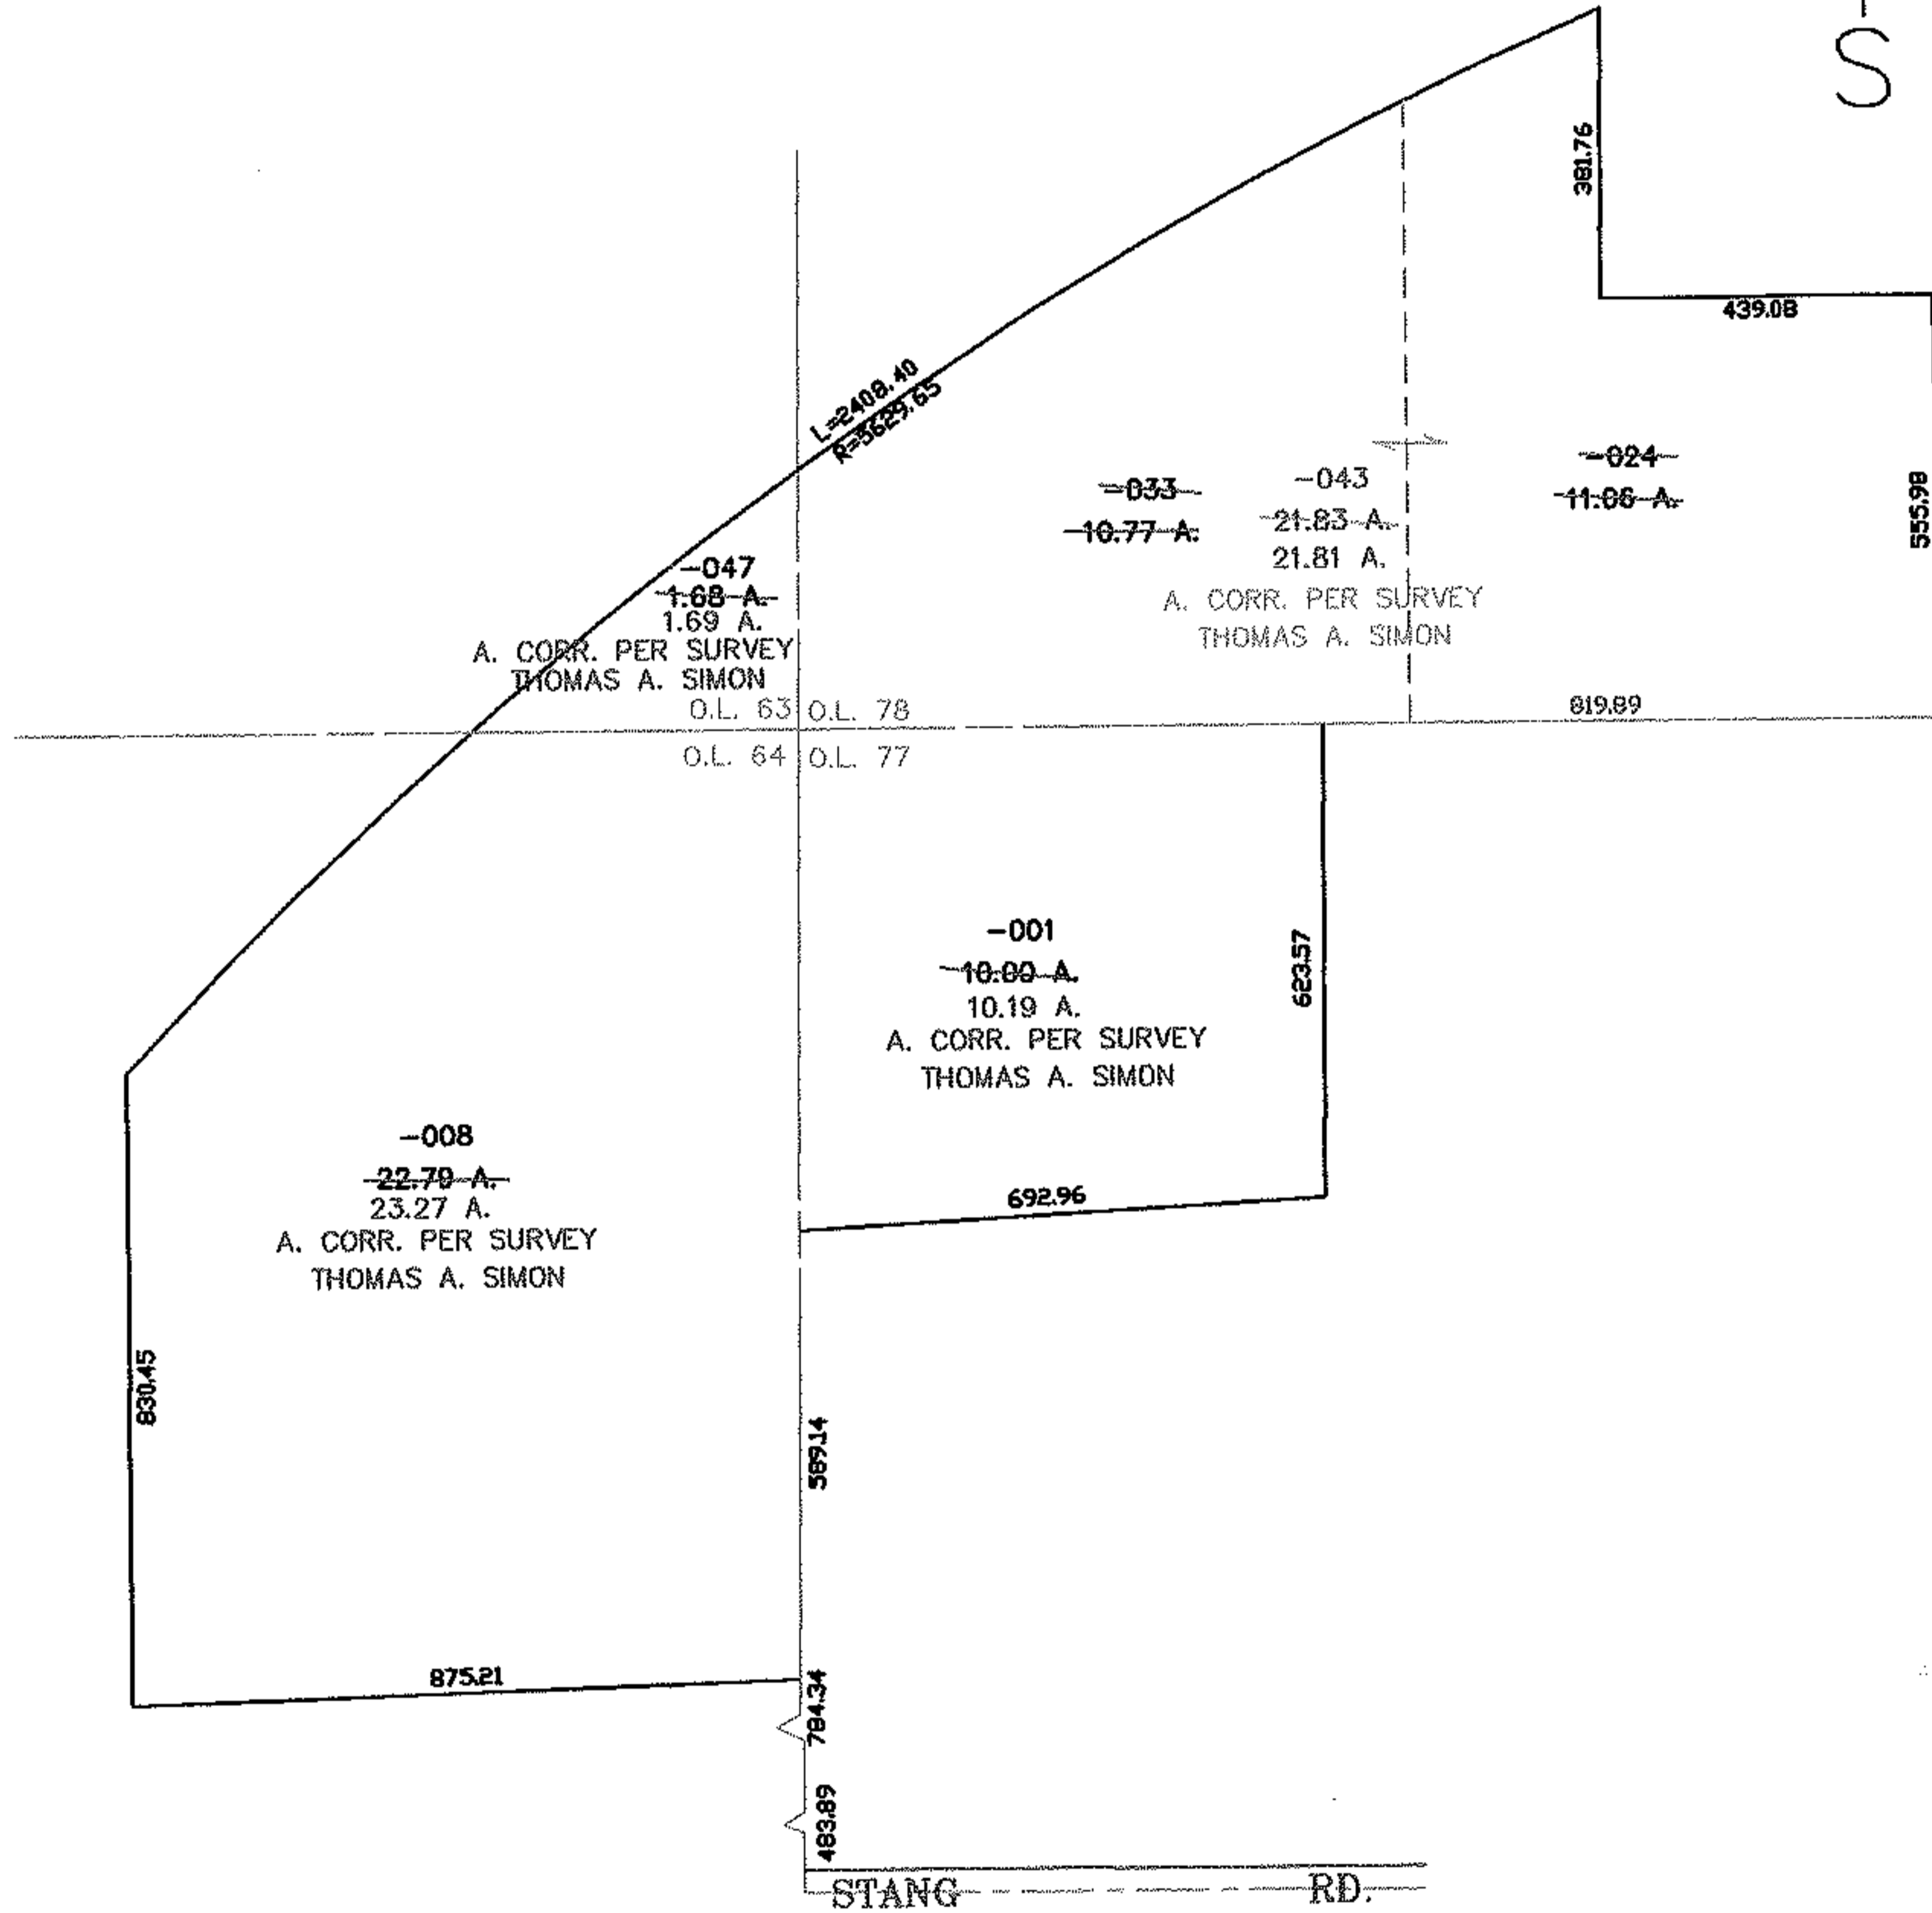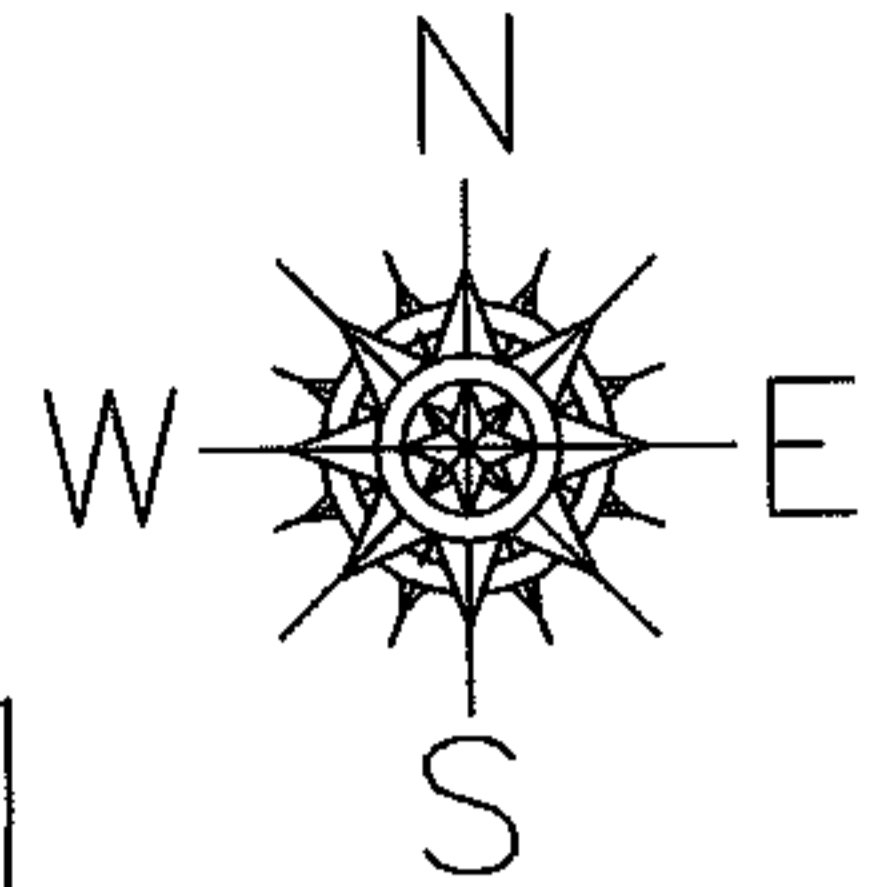

**SPLITS/DEEDS PROCESSED**  
**LORAIN COUNTY TAX MAP DEPARTMENT**  
 226 MIDDLE AVE. ELYRIA, OHIO

SURVEYED BY: THOMAS SIMON  
 CLOSURE: 0.13 : 10,000  
 MAP PAGE(S): 05-00-078-B  
 APPROVED BY: JAH DATE: 8-13-04  
 SCALE: 1" = 400 PRIOR INSTRUMENT: DV 1339/169