
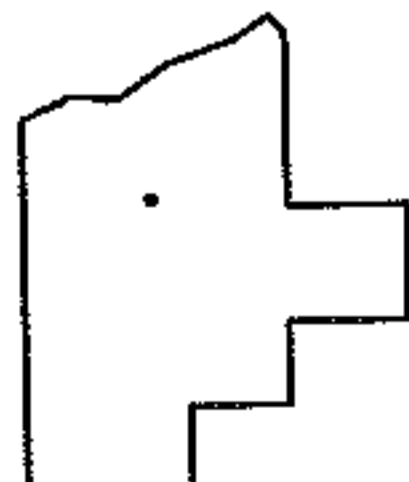
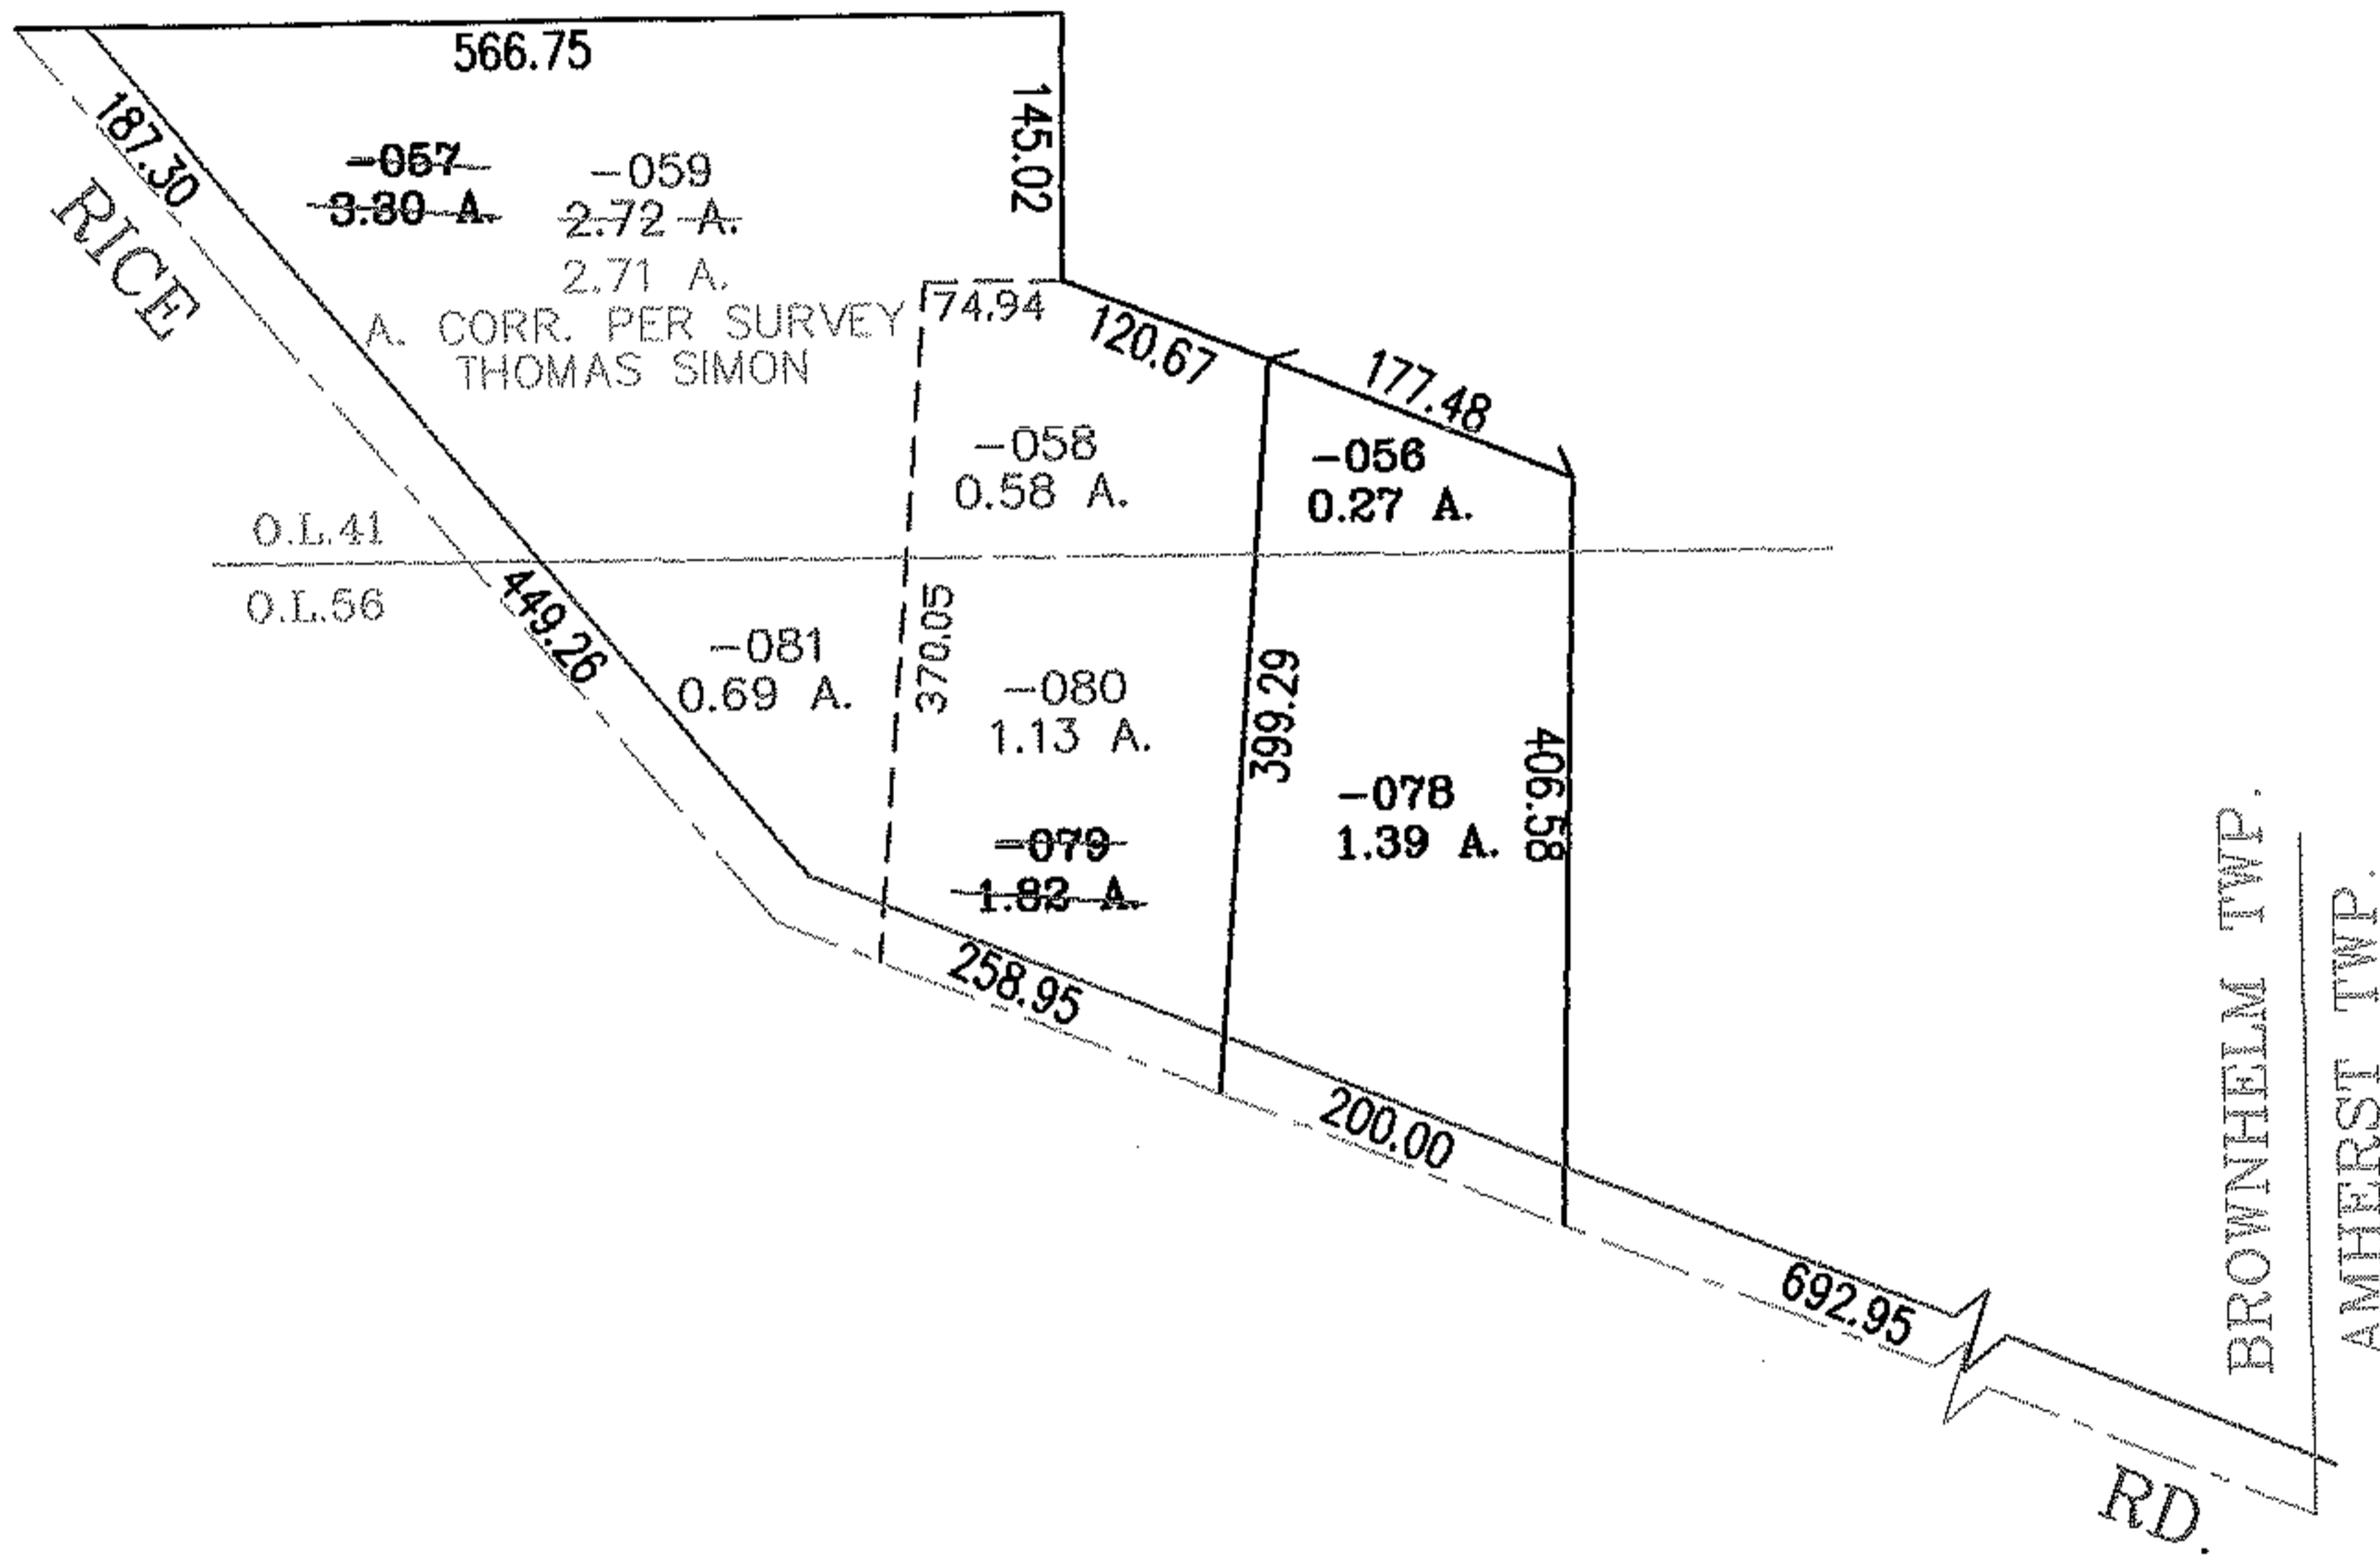


RASTER

PARENT PARCEL: 01-00-041-000-057, 01-00-056-000-079
CHILD PARCEL: 01-00-041-000-058, -059 01-00-056-000-080, -081
STARTING POINT: INTERSECTION OF EAST LINE OF BROWNHELM TWP. AND C/L OF RICE RD.

NO. 01732

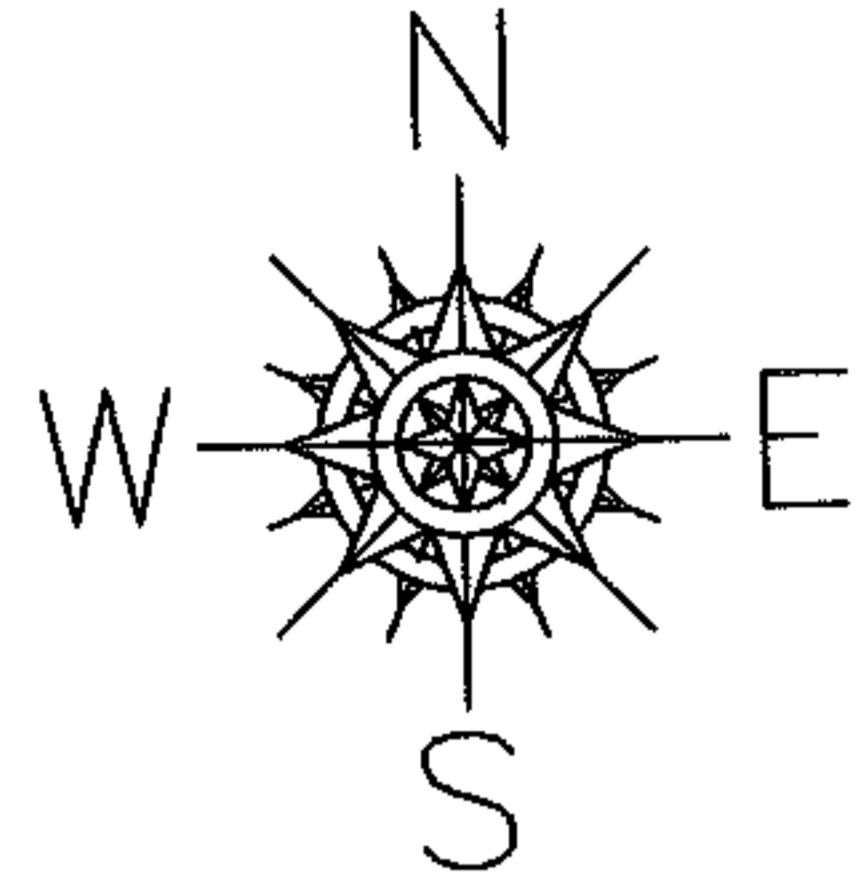

SPLITS/DEEDS PROCESSED
LORAIN COUNTY TAX MAP DEPARTMENT
226 MIDDLE AVE. ELYRIA, OHIO

SURVEYED BY: THOMAS A. SIMON
CLOSURE: .01:10.000
MAP PAGE(S): 1-H,1-L
APPROVED BY: RRM DATE: 8-16-04
SCALE: 1" = 200 PRIOR INSTRUMENT: 20010799697