


RASTER

PARENT PARCEL: 10-00-003-121-033


CHILD PARCEL: 10-00-003-121-040, -041

STARTING POINT: CENTERLINE OF WEST RIVER RD. & FRANK POLEN SUBD.


NO. 01733

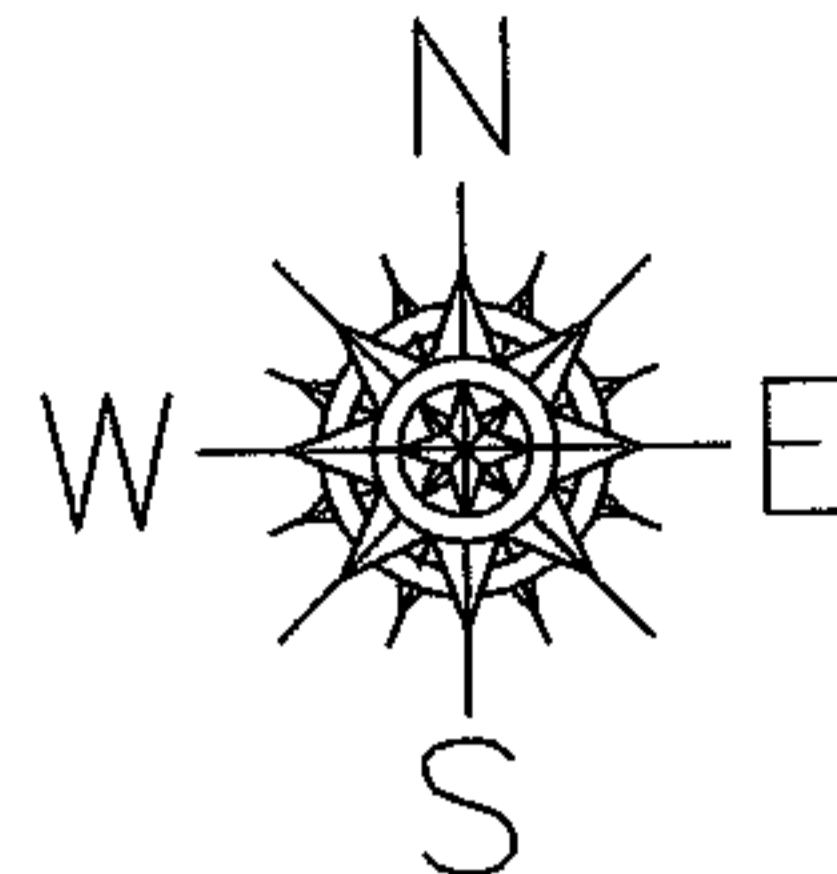

FRANK POLEN SUBD.
VOL. 17 PG. 5

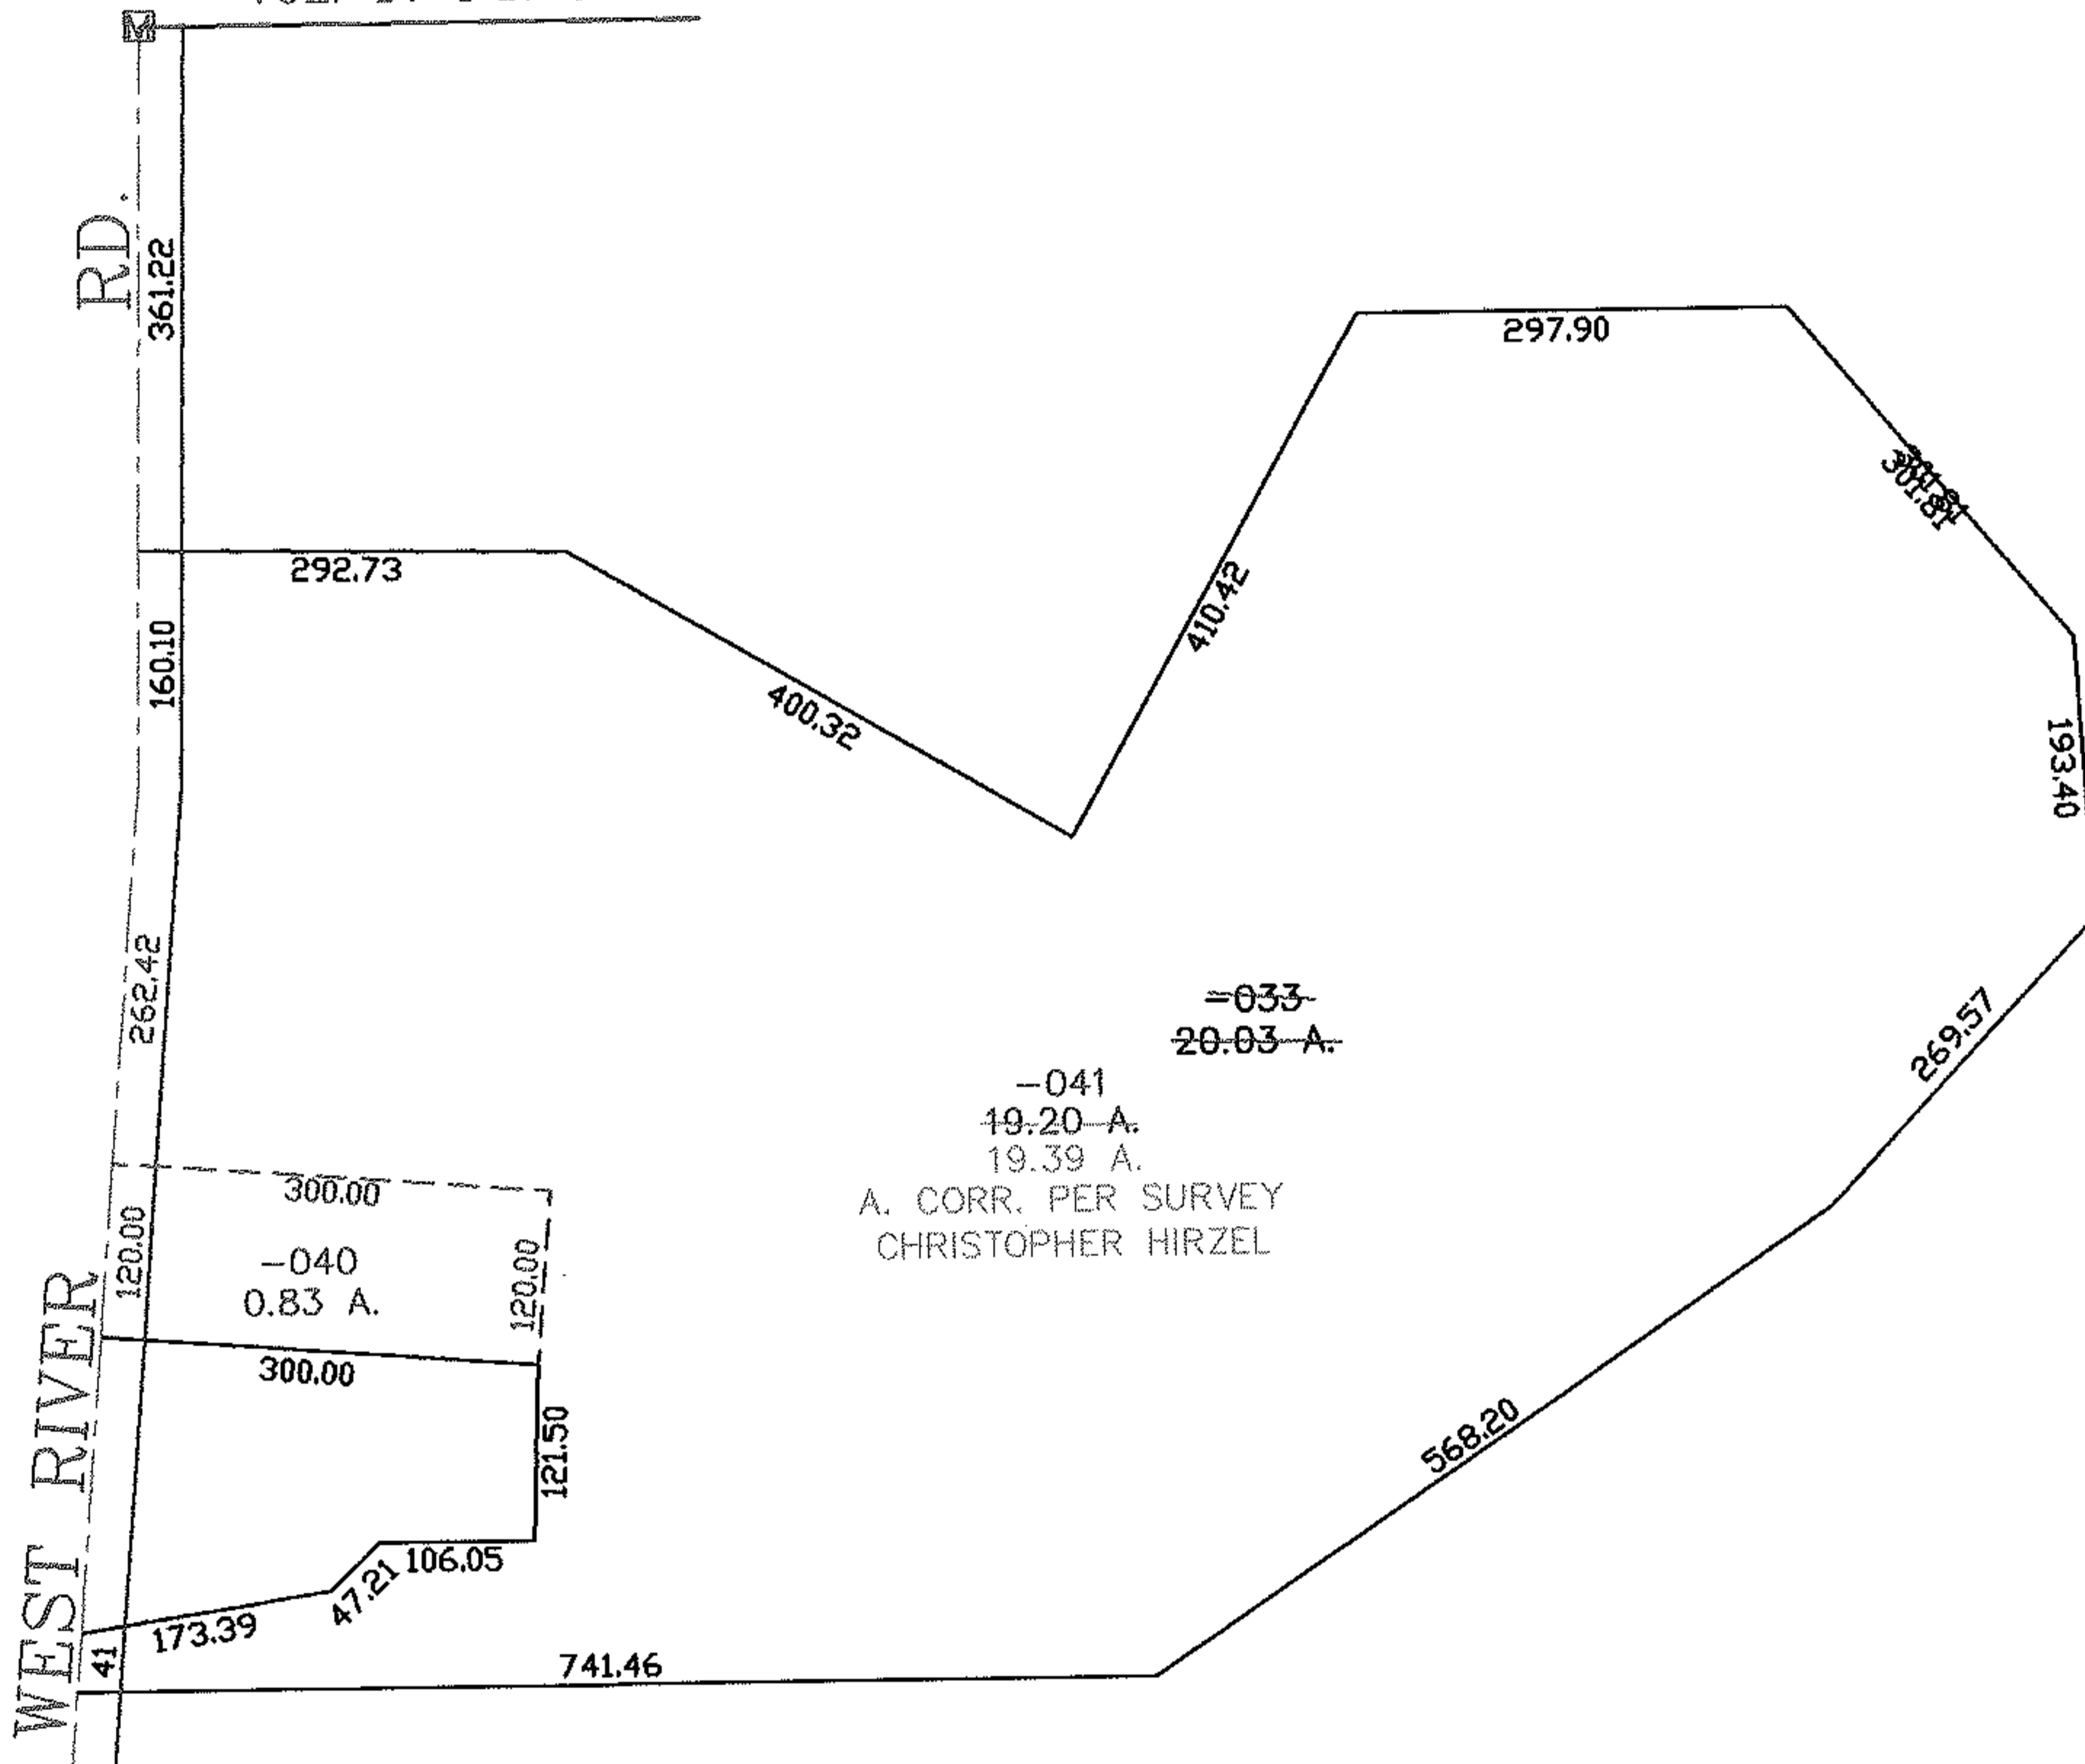

~~-033-20-03-A.~~
-041
19.20 A.
19.39 A.
A. CORR. PER SURVEY
CHRISTOPHER HIRZEL

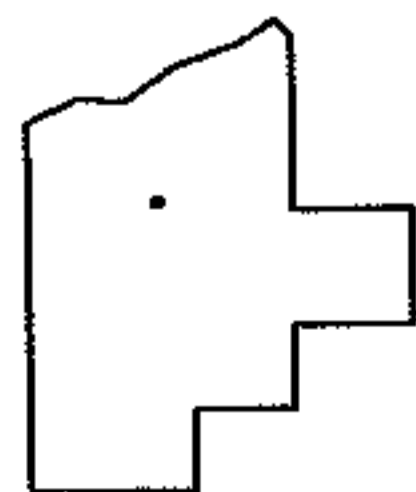

SPLITS/DEEDS PROCESSED
LORAIN COUNTY TAX MAP DEPARTMENT
226 MIDDLE AVE. ELYRIA, OHIO

SURVEYED BY: CHRISTOPHER HIRZEL
CLOSURE: 0.17 : 10.000
MAP PAGE(S): 10-00-003-F
APPROVED BY: JAH DATE: 8-16-04
SCALE: 1" = 200 PRIOR INSTRUMENT: DV 1378/441