
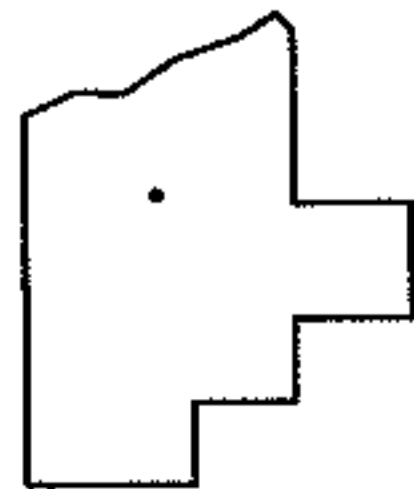
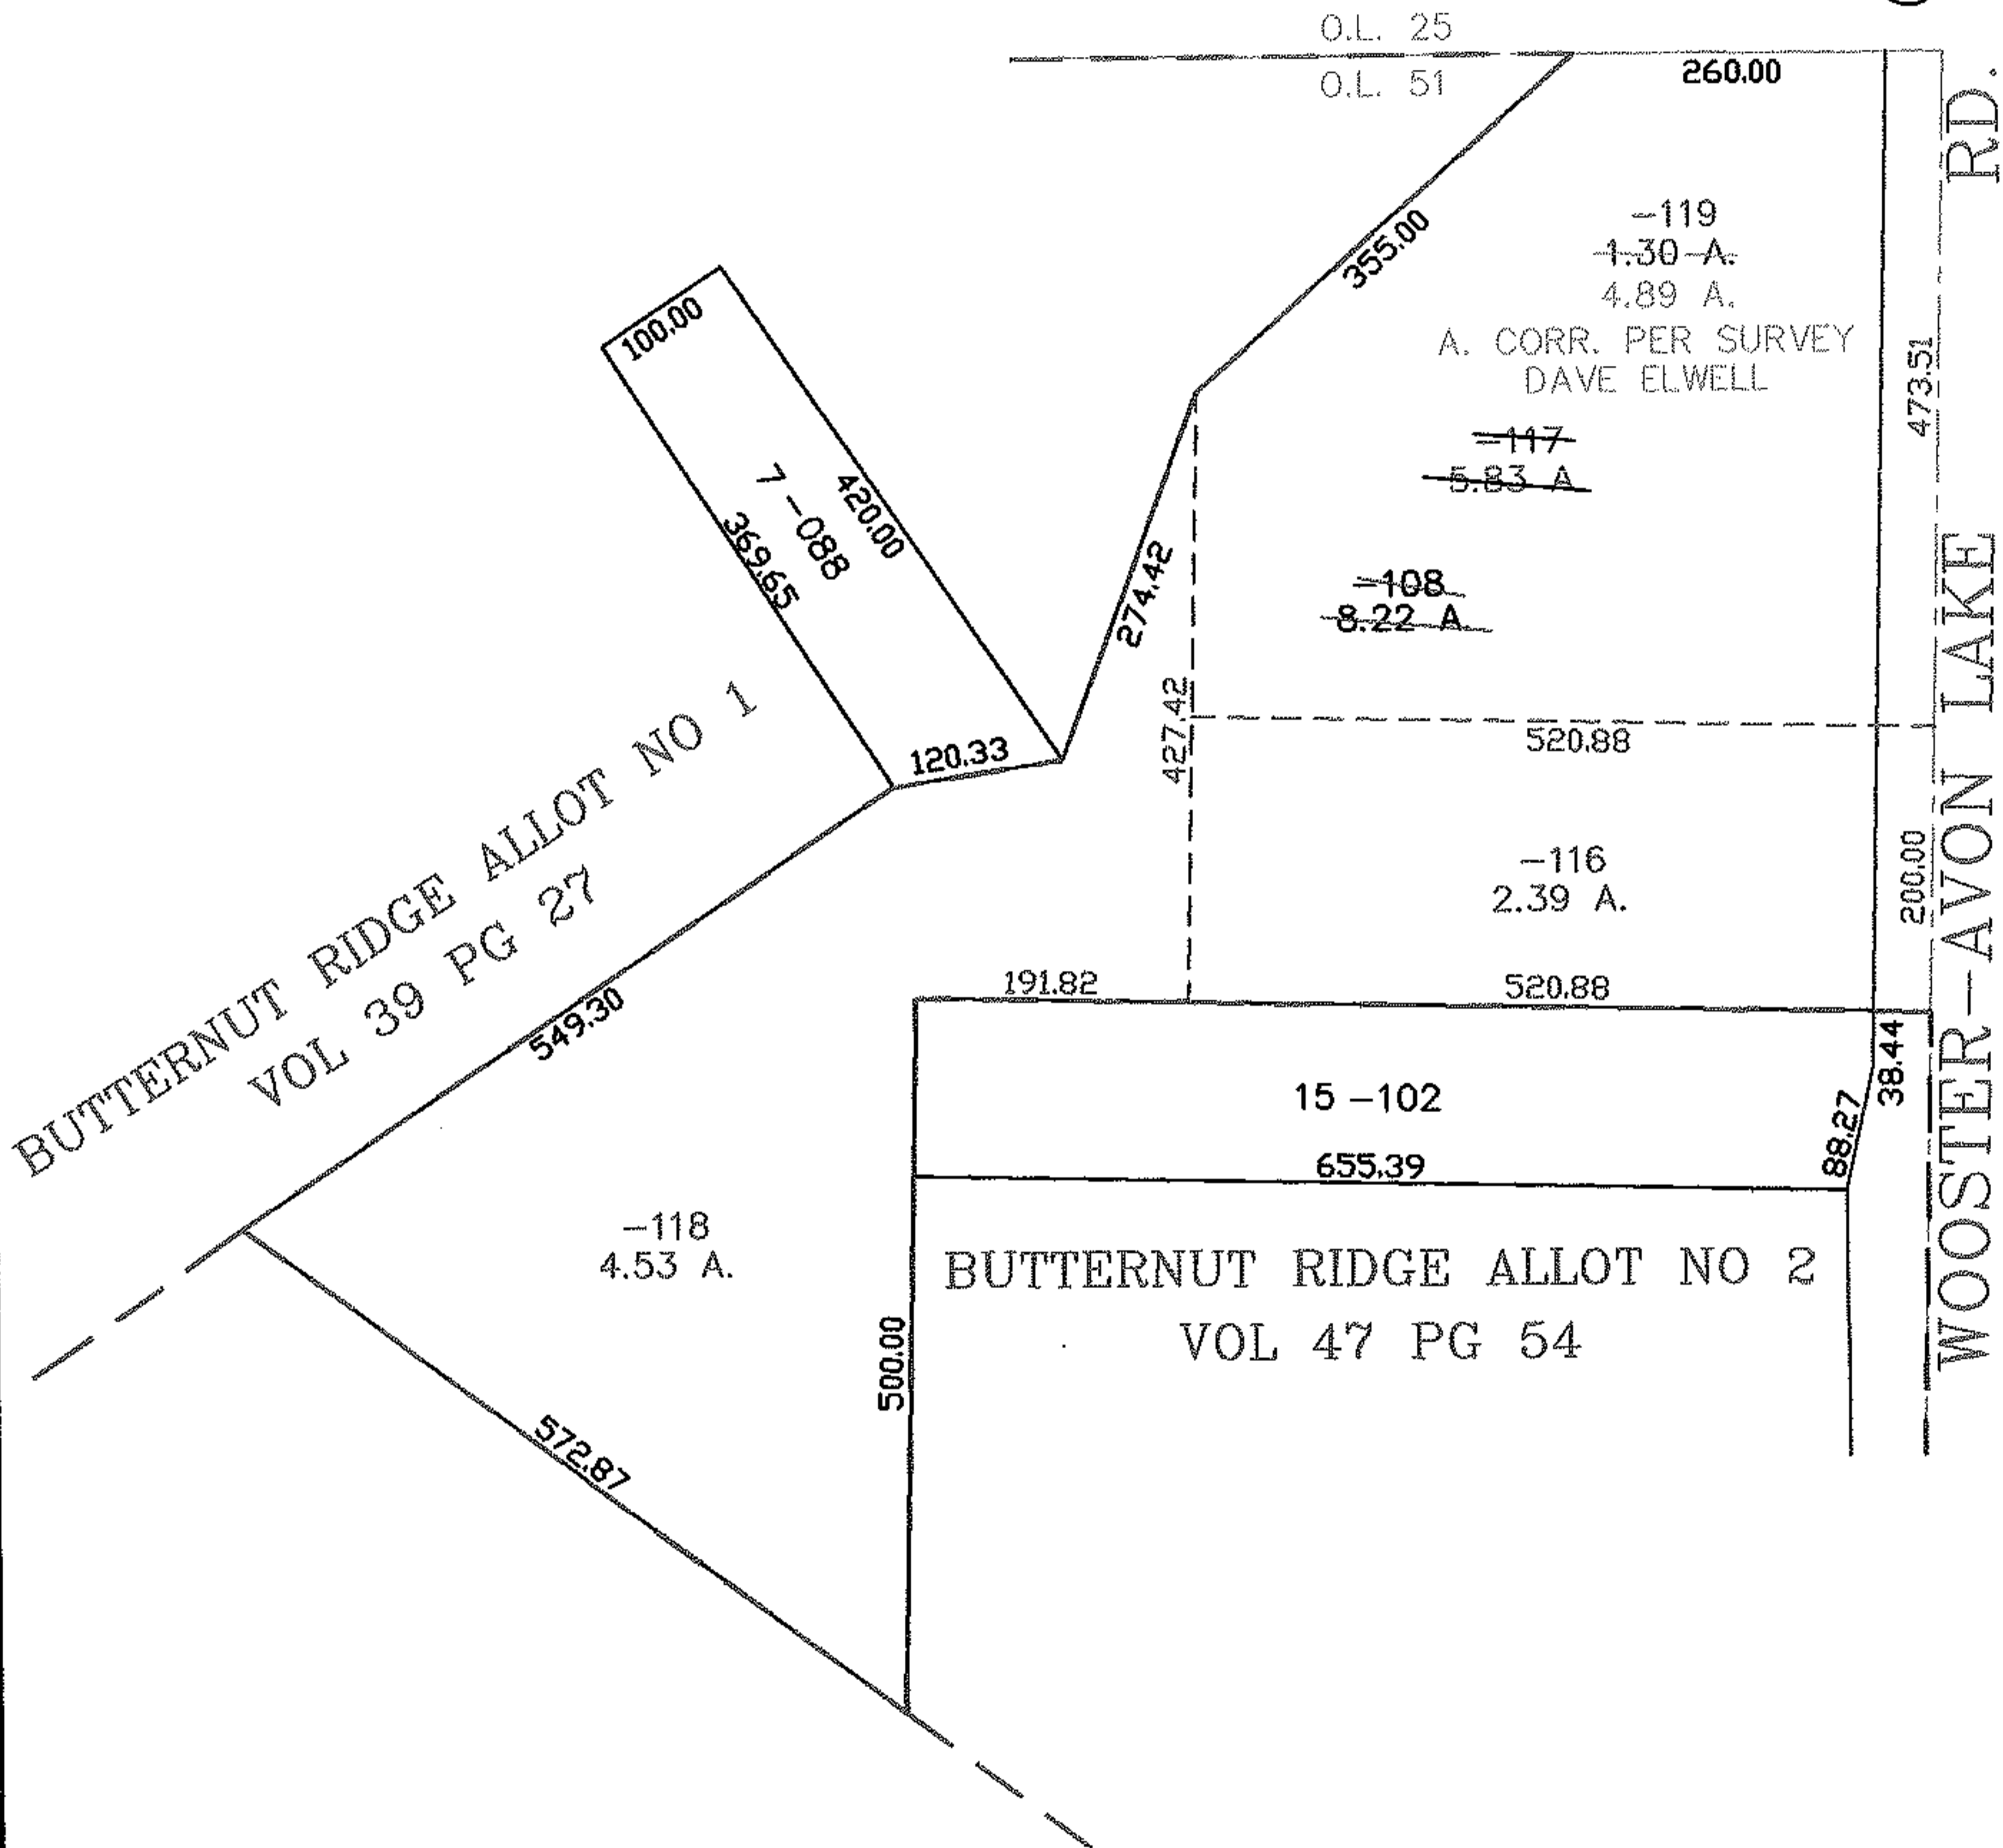


PARENT PARCEL: 11-00-051-000-108

CHILD PARCEL: 11-00-051-000-116 THRU -119

STARTING POINT: CENTERLINE OF WOOSTER-AVON LAKE RD. & O.L. 51

NO. 01740

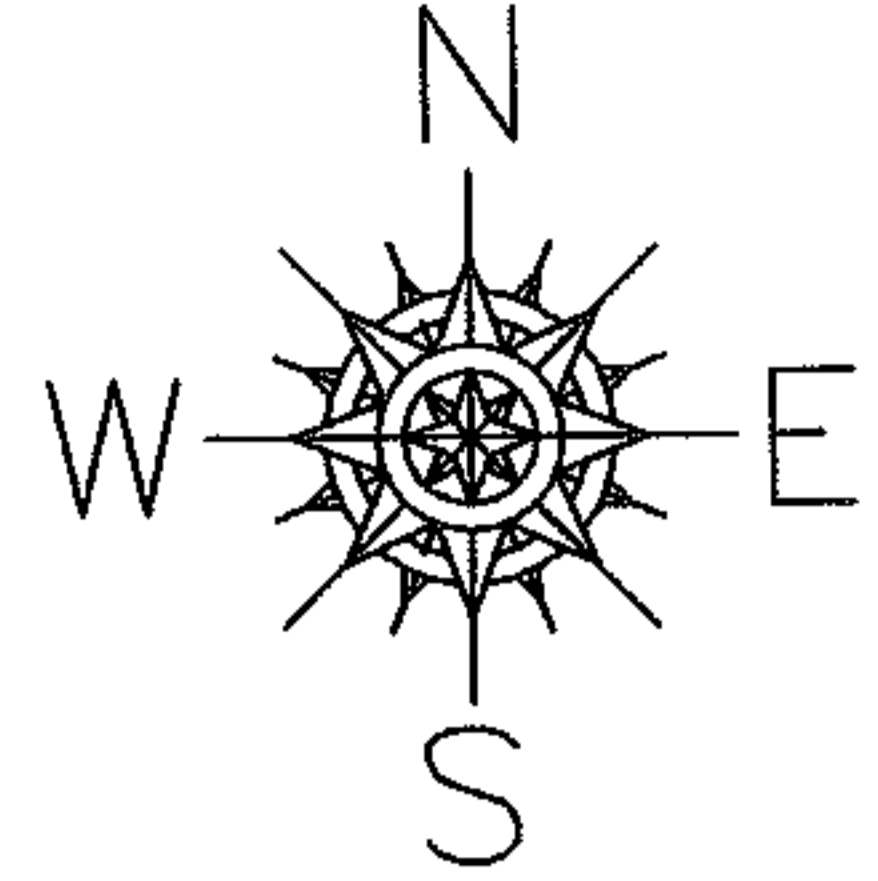

SPLITS/DEEDS PROCESSED
LORAIN COUNTY TAX MAP DEPARTMENT
 226 MIDDLE AVE. ELYRIA, OHIO

SURVEYED BY: DAVE ELWELL
 CLOSURE: 0.00 : 10.000
 MAP PAGE(S): 11-00-051-B
 APPROVED BY: JAH DATE: 8-19-04
 SCALE: 1" = 200 PRIOR INSTRUMENT: DV 1323/715