
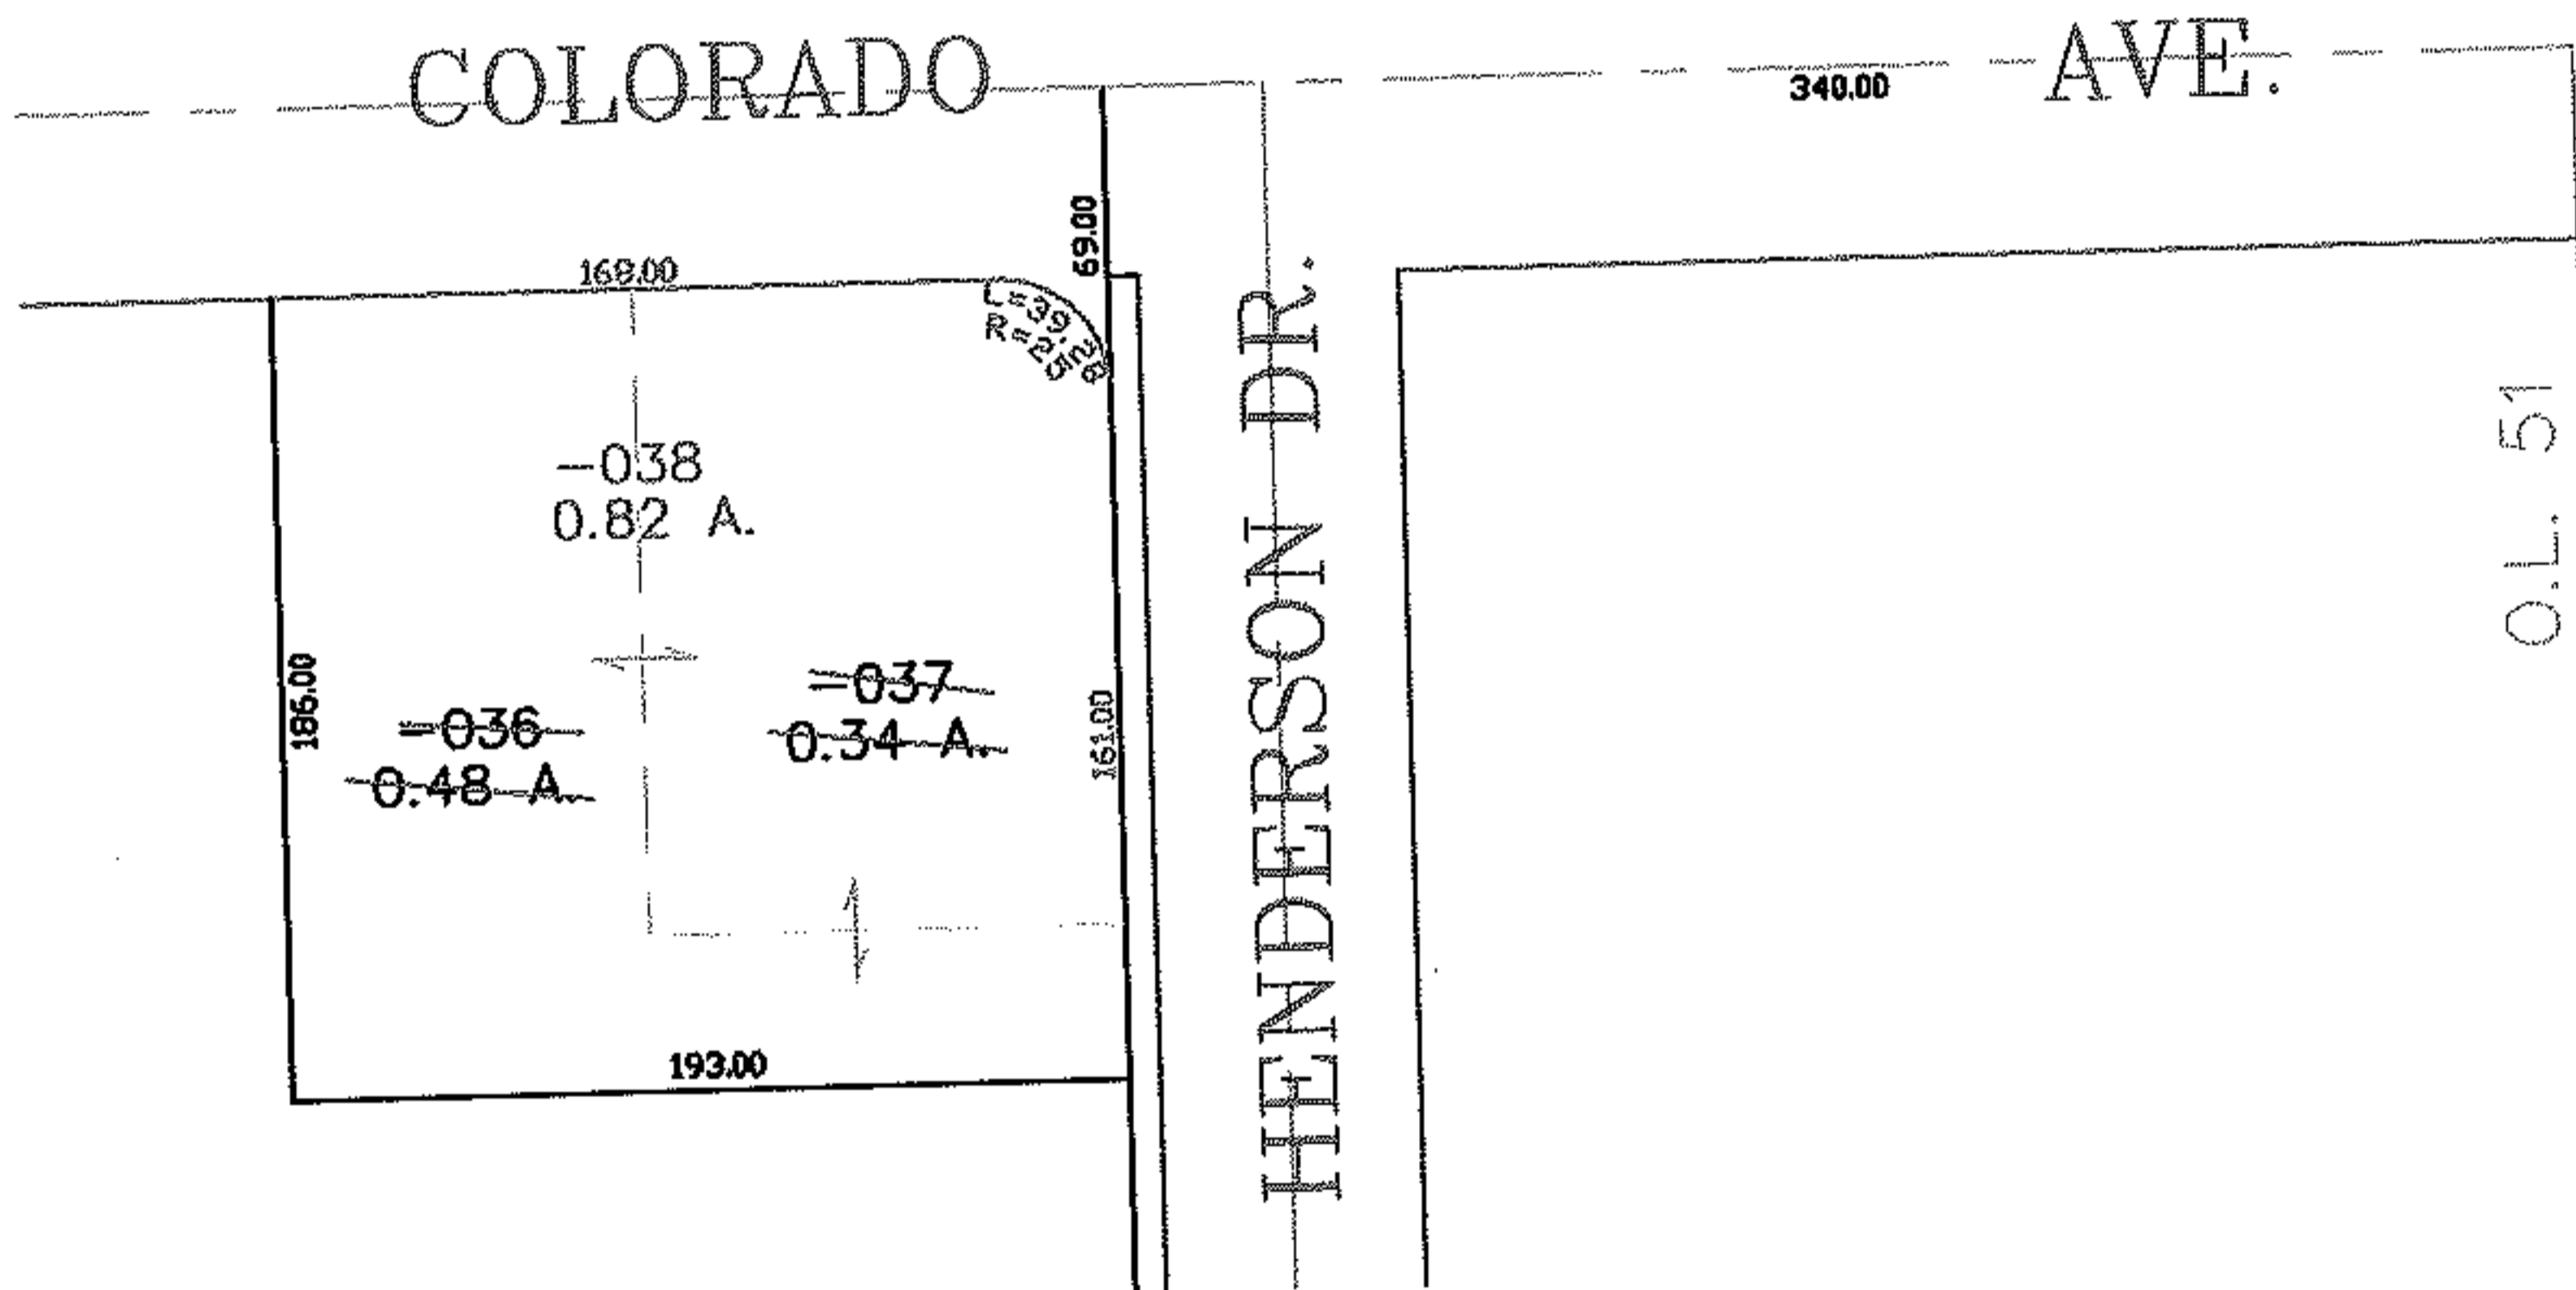


RASTER

PARENT PARCEL: 02-00-051-142-028, -029  
CHILD PARCEL: 02-00-051-142-038  
STARTING POINT: CENTERLINE OF COLORADO AVE. & O.L. 51

NO. 01752

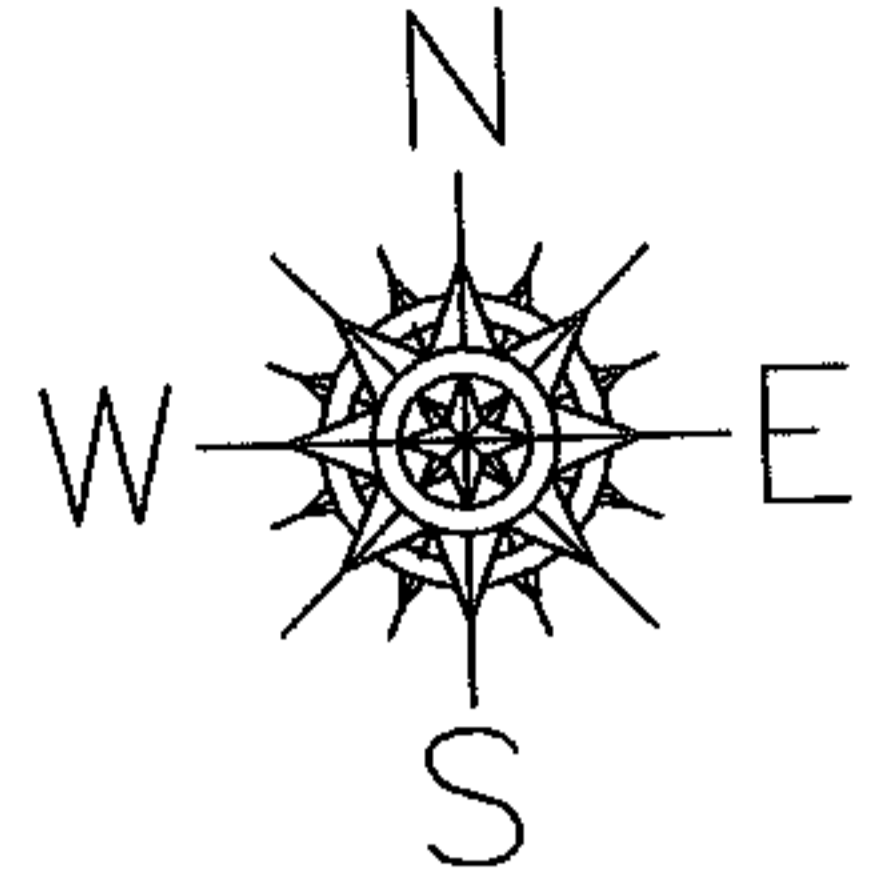

**SPLITS/DEEDS PROCESSED**

LORAIN COUNTY TAX MAP DEPARTMENT  
226 MIDDLE AVE. ELYRIA, OHIO

SURVEYED BY: PATRICK A. MCGANNON  
CLOSURE: 0.00 : 10.000  
MAP PAGE(S): 02-00-051-B  
APPROVED BY: JAH DATE: 9-2-04  
SCALE: 1" = 100 PRIOR INSTRUMENT: 20010763601