
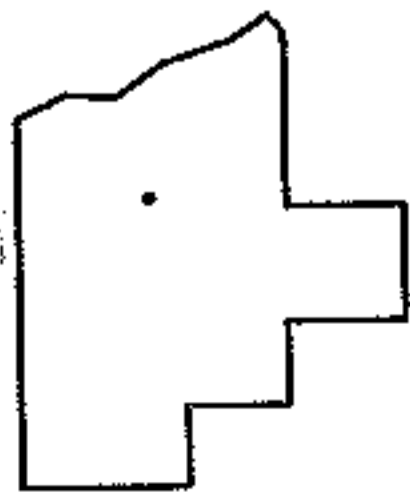
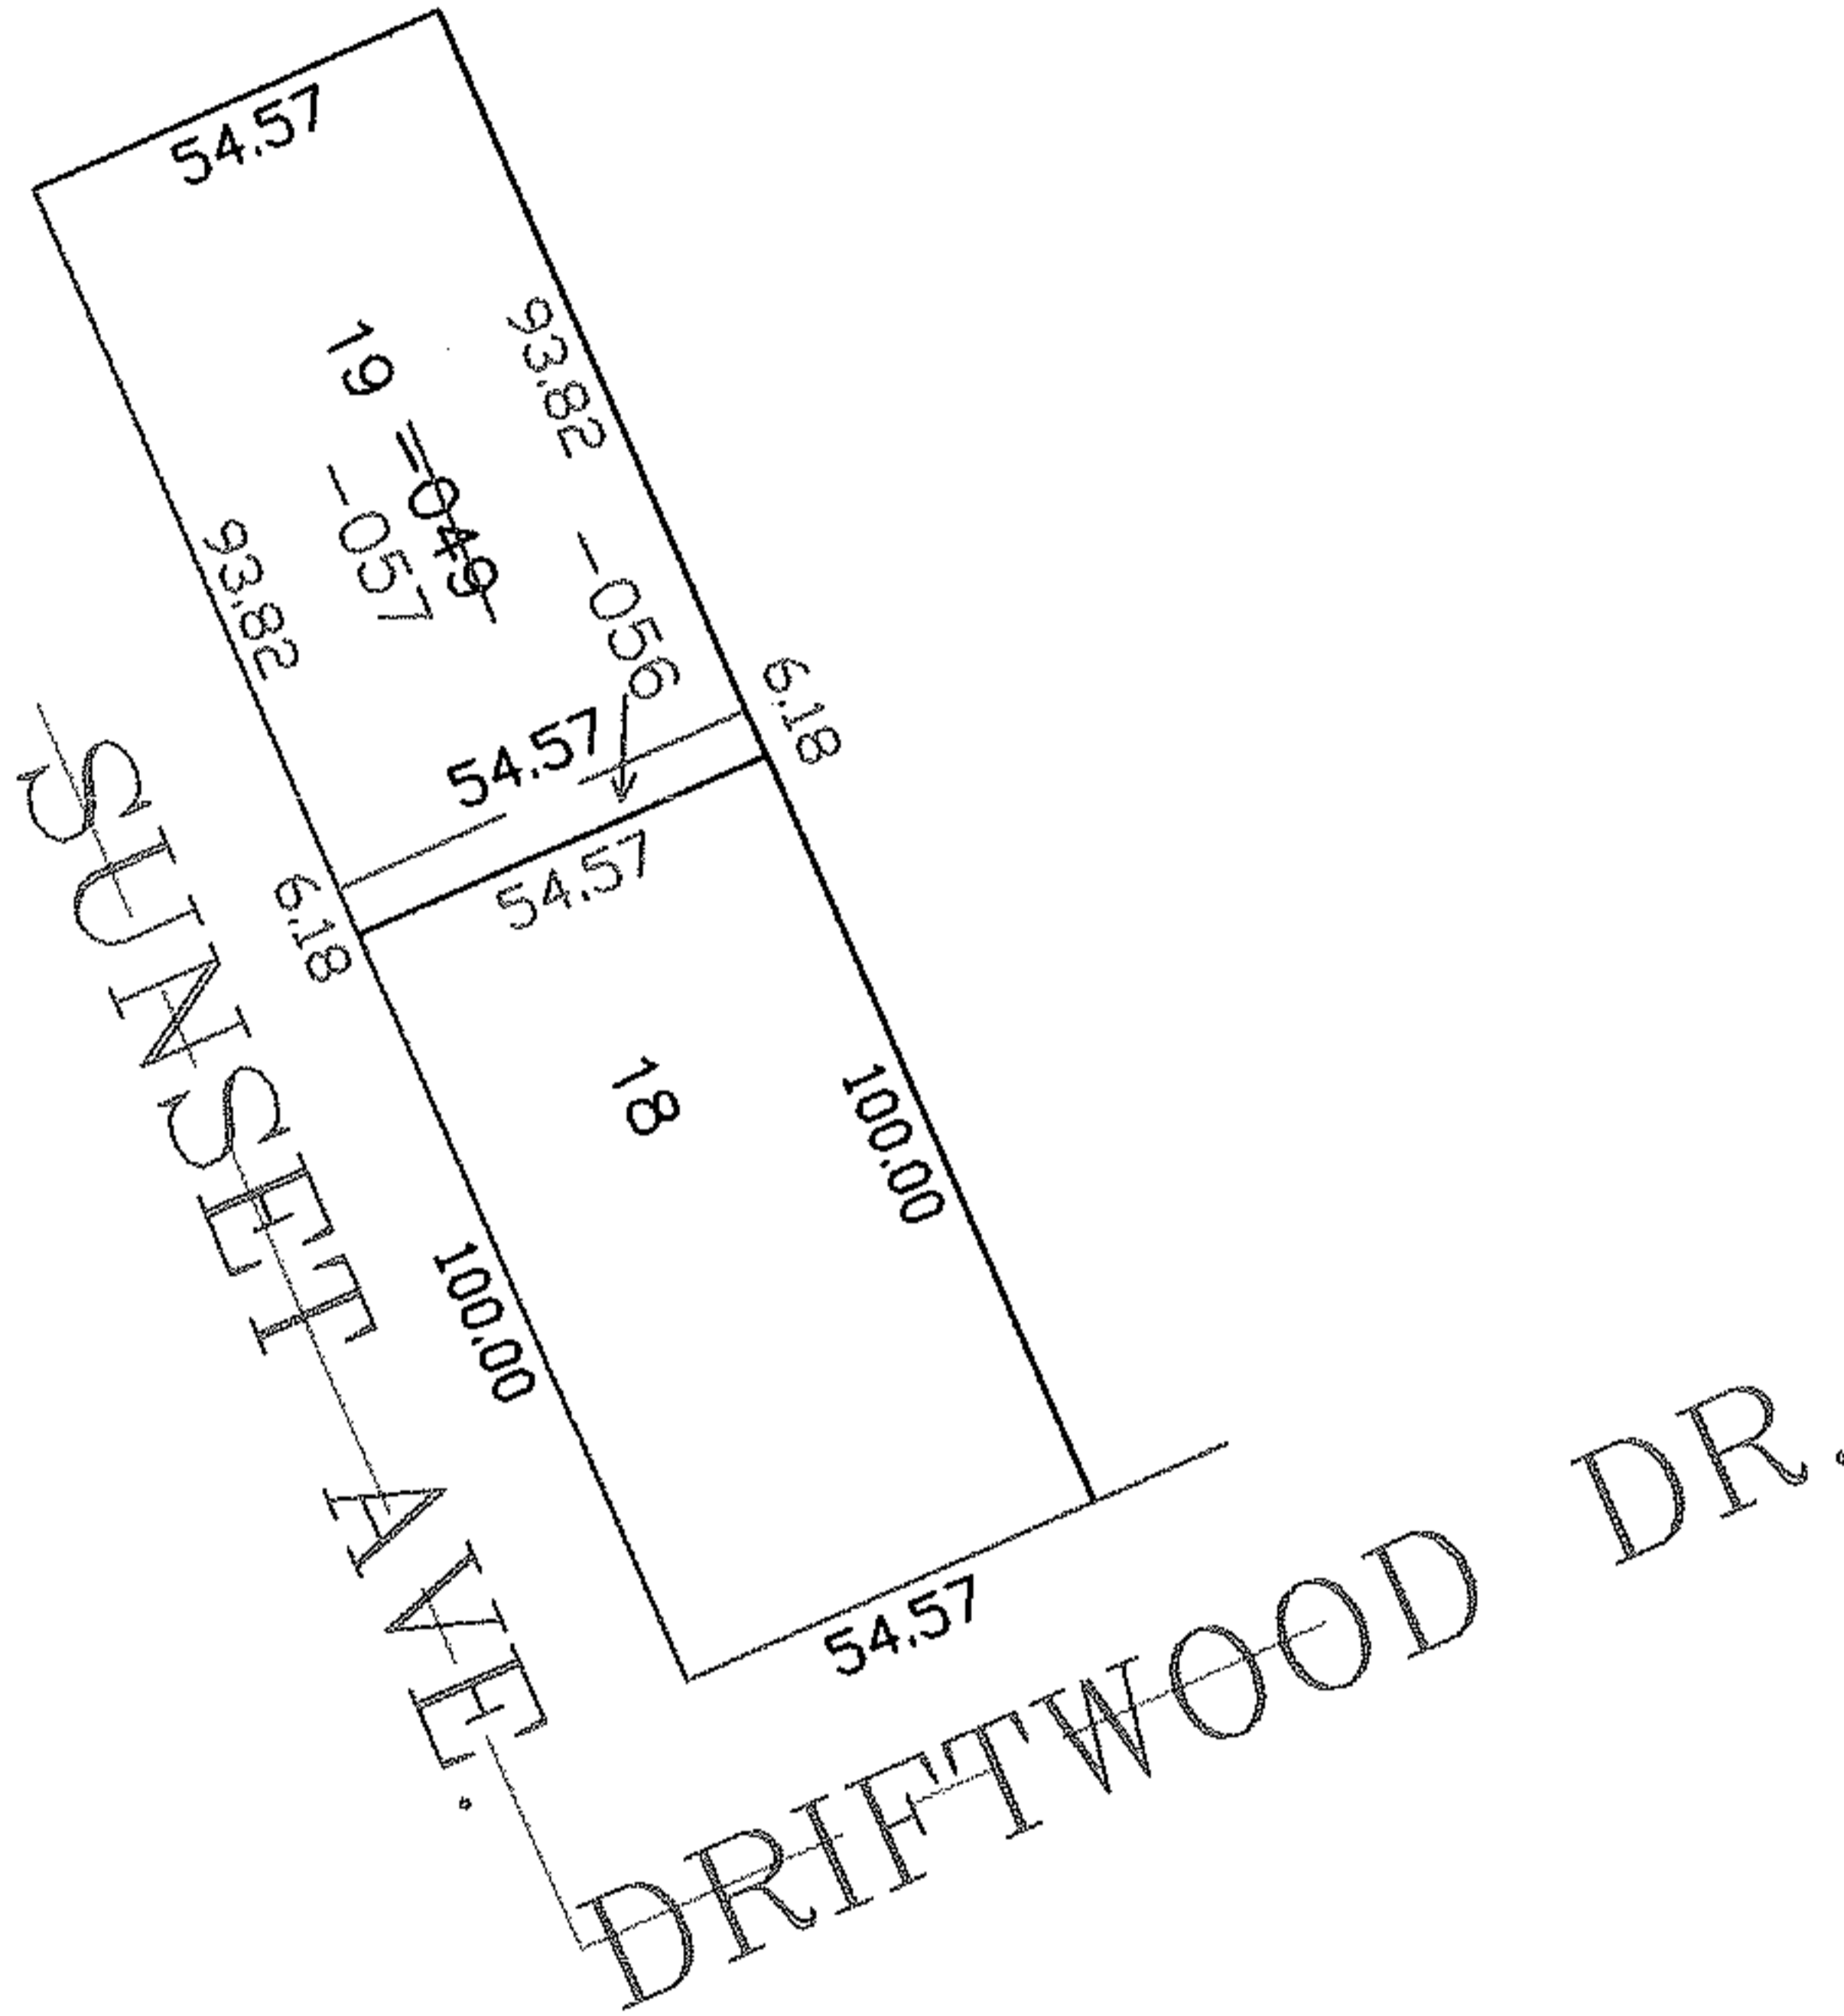


PARENT PARCEL: 02-01-002-105-049

CHILD PARCEL: 02-01-002-105-056, -057

STARTING POINT: SIDELINE OF SUNSET AVE. & DRIFTWOOD DR.

NO. 01756

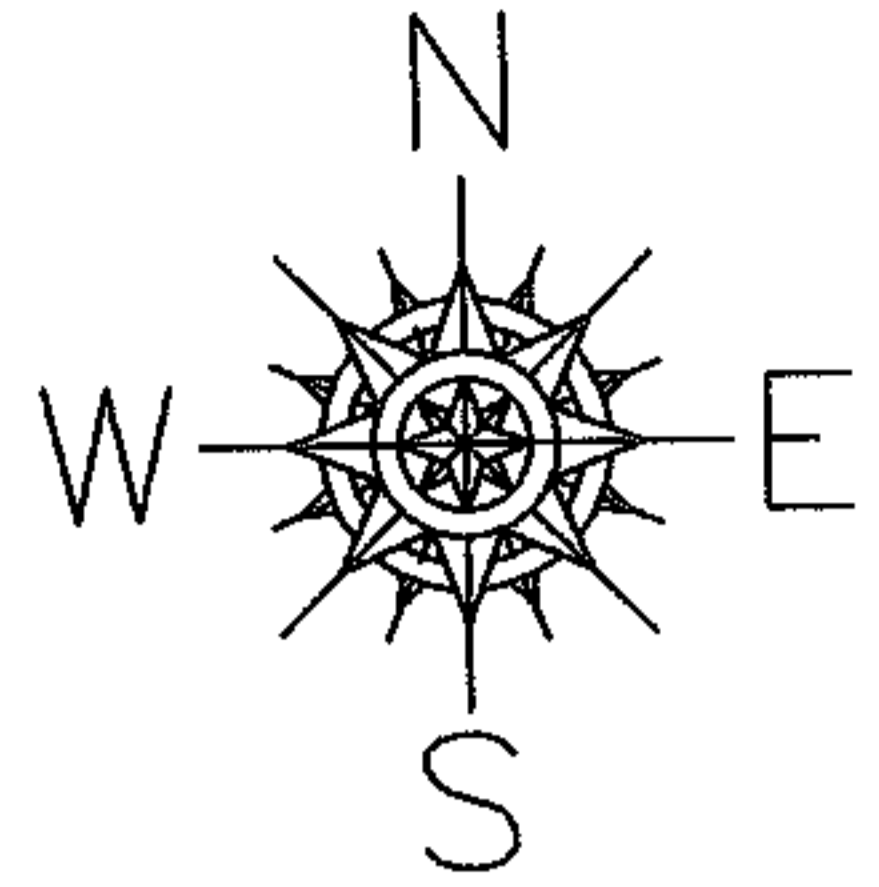

SPLITS/DEEDS PROCESSED

LORAIN COUNTY TAX MAP DEPARTMENT
226 MIDDLE AVE. ELYRIA, OHIO

SURVEYED BY: CHRISTOPHER HIRZEL

CLOSURE: 0.00 : 10.000

MAP PAGE(S): 02-01-003-A

APPROVED BY: JAH DATE: 9-7-04

SCALE: 1" = 100 PRIOR INSTRUMENT: PL 76/74