



RASTER

PARENT PARCEL: 11-00-092-000-068, -067

CHILD PARCEL: 11-00-092-000-084 THRU -086

STARTING POINT: CENTERLINE OF DEWHURST RD. & CHESTNUT RIDGE RD.

NO. 01759

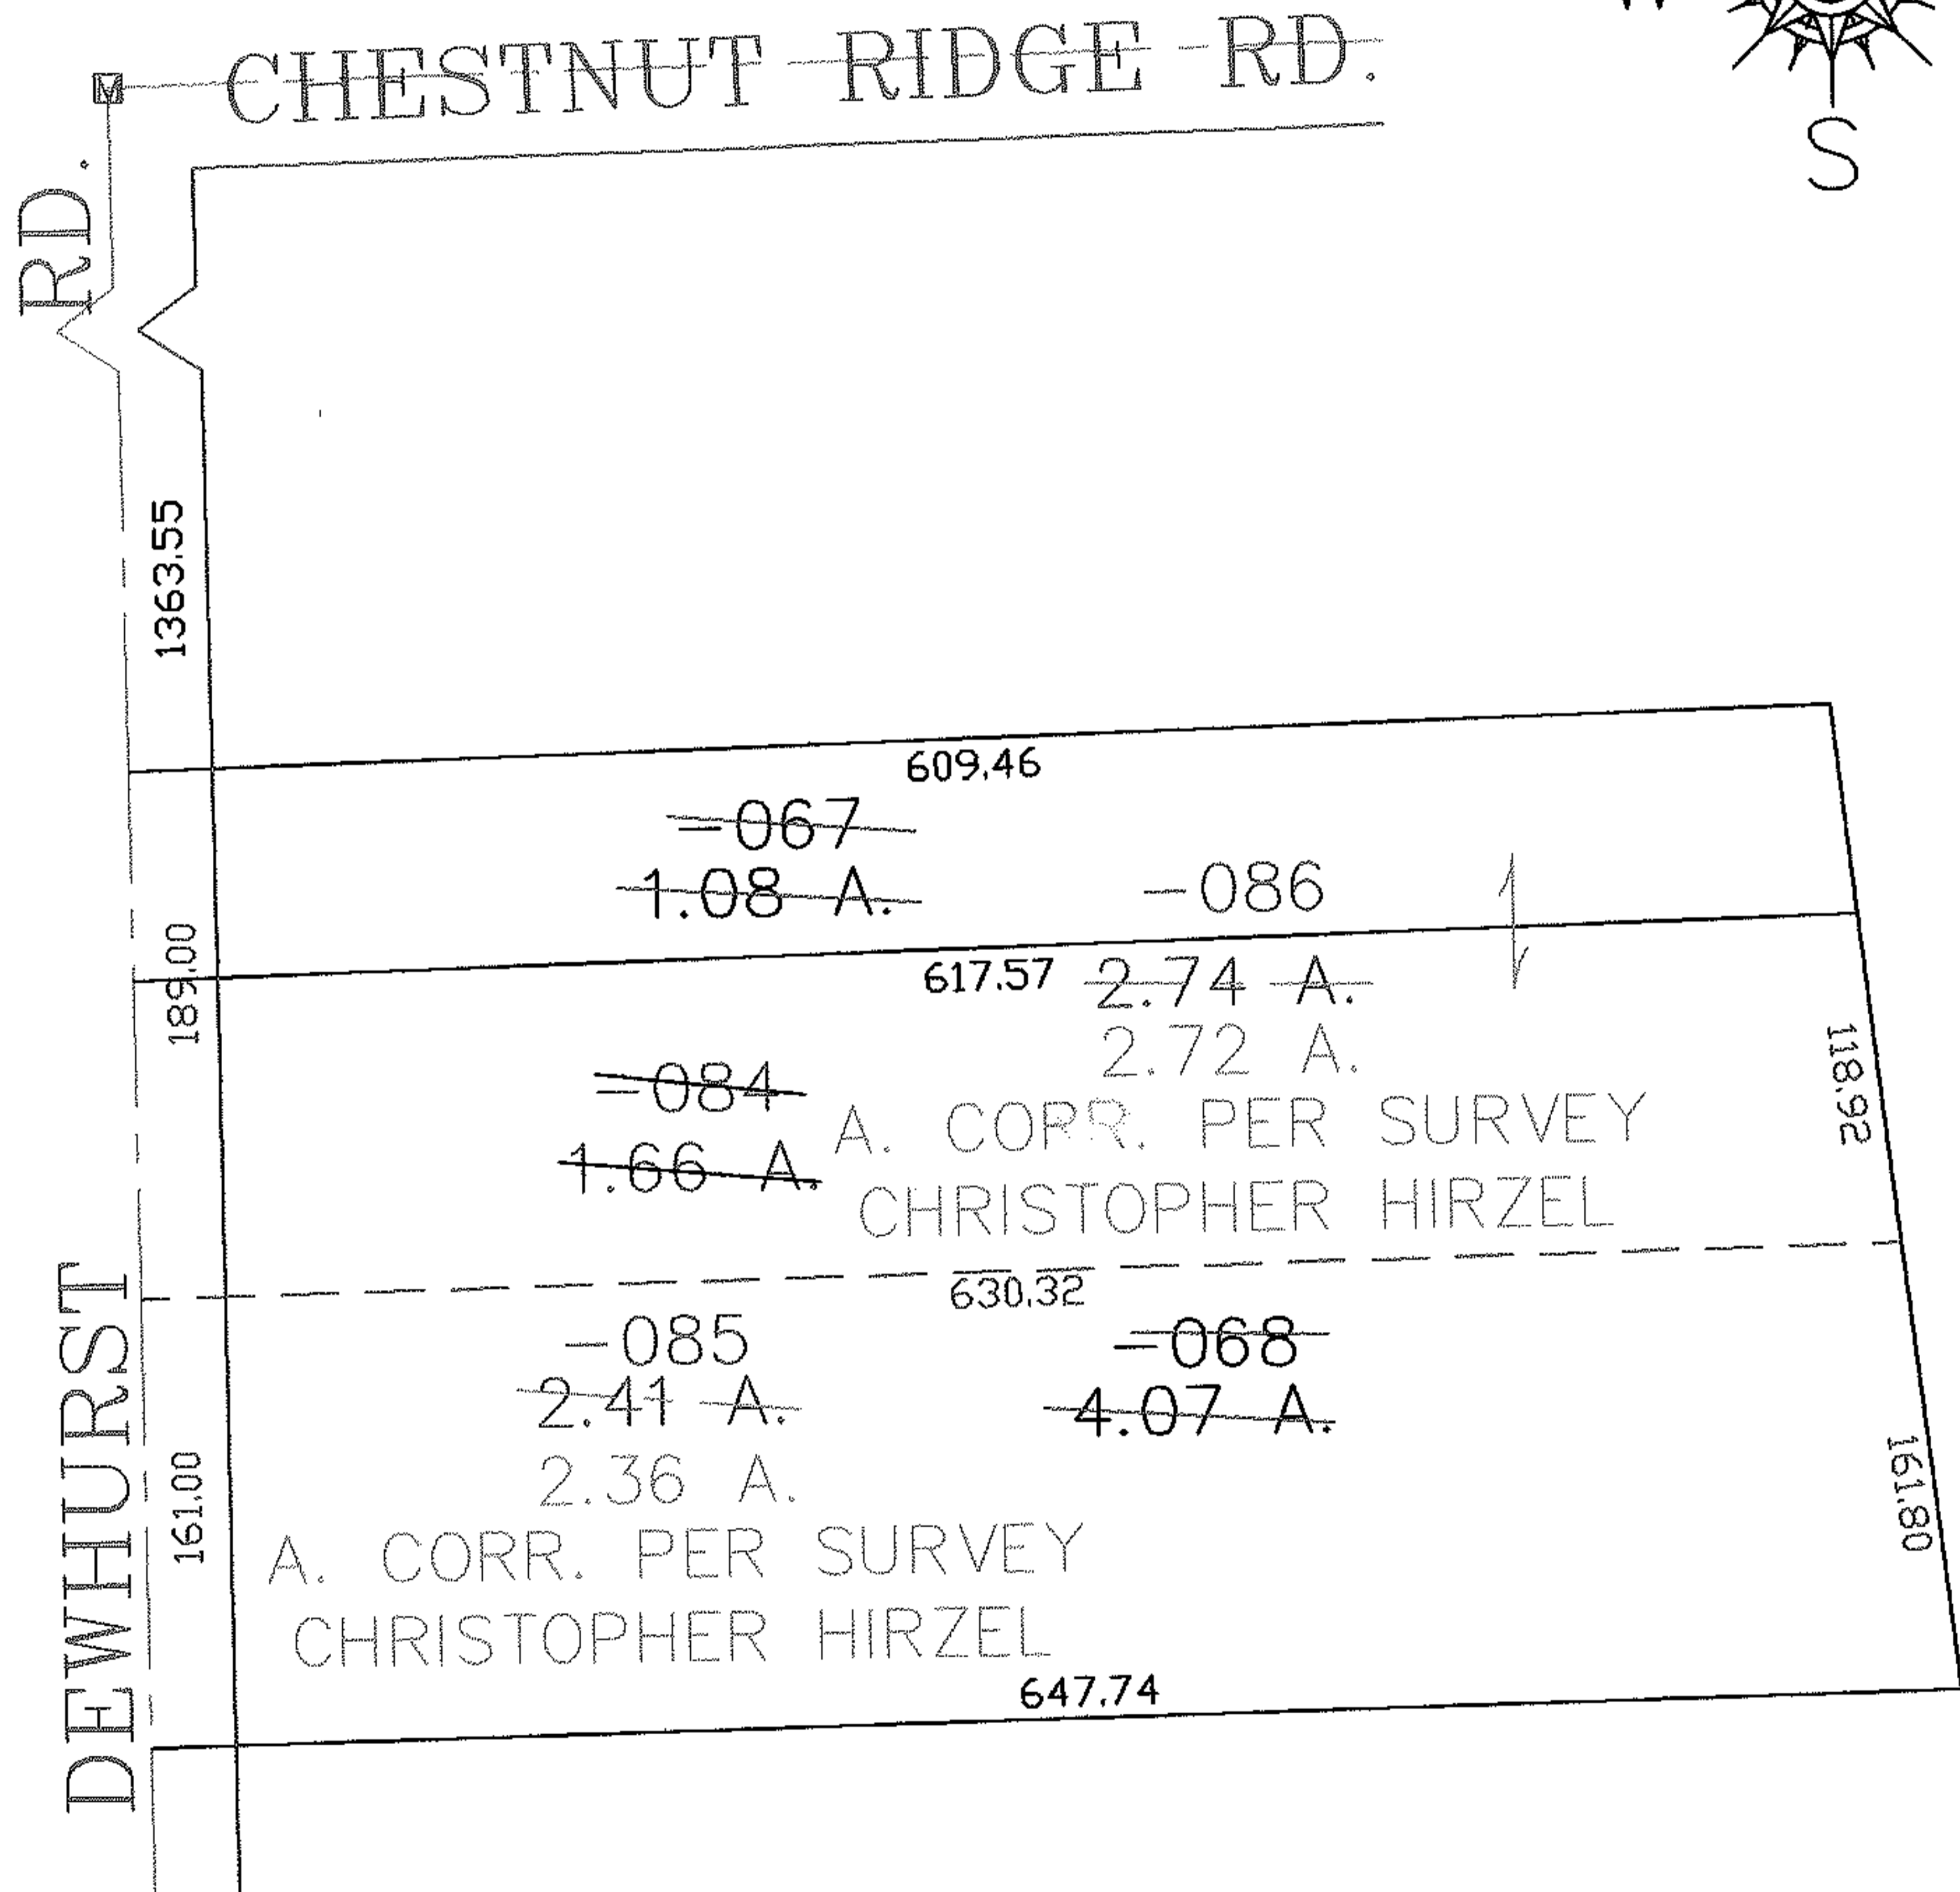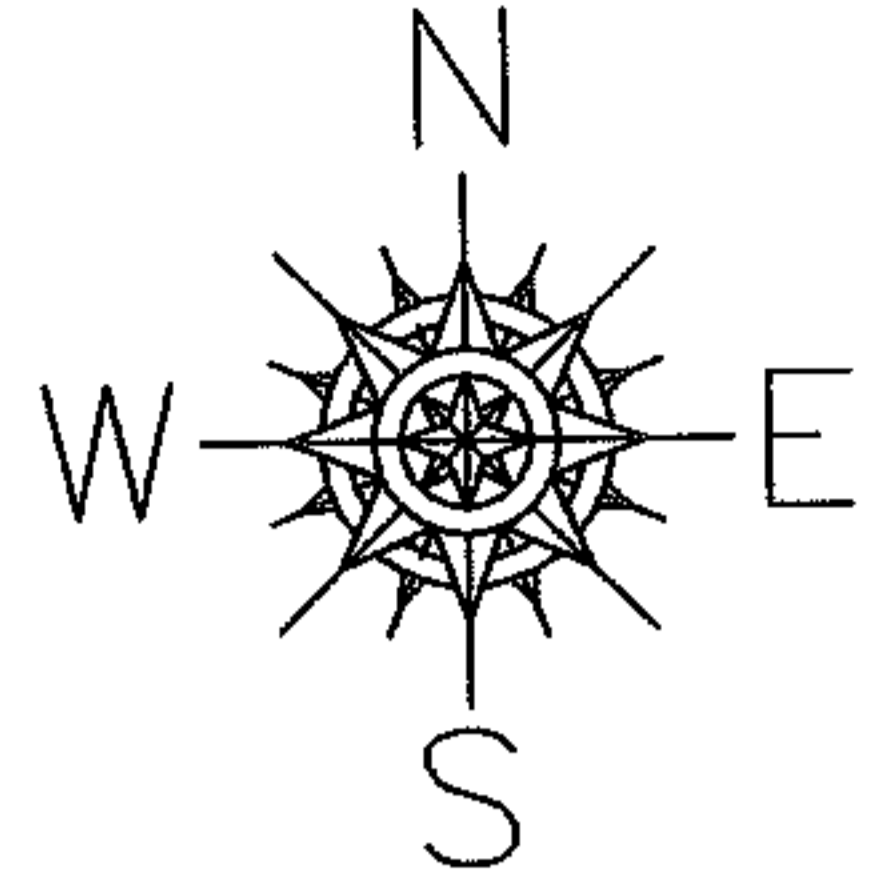

SPLITS/DEEDS PROCESSED

LORAIN COUNTY TAX MAP DEPARTMENT
226 MIDDLE AVE. ELYRIA, OHIO

SURVEYED BY: CHRISTOPHER HIRZEL

CLOSURE: 0.00 : 10.000

MAP PAGE(S): 11-00-092-A

APPROVED BY: JAH DATE: 9-14-04

SCALE: 1" = 100 PRIOR INSTRUMENT: 20030966490