
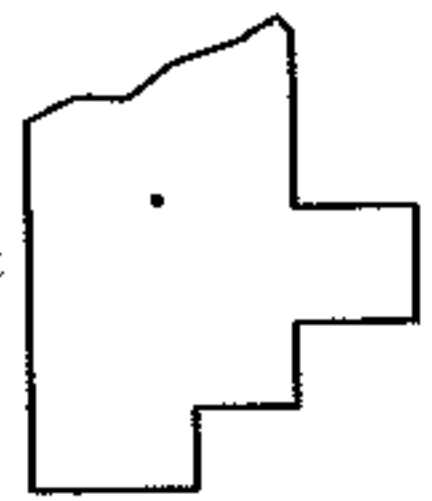
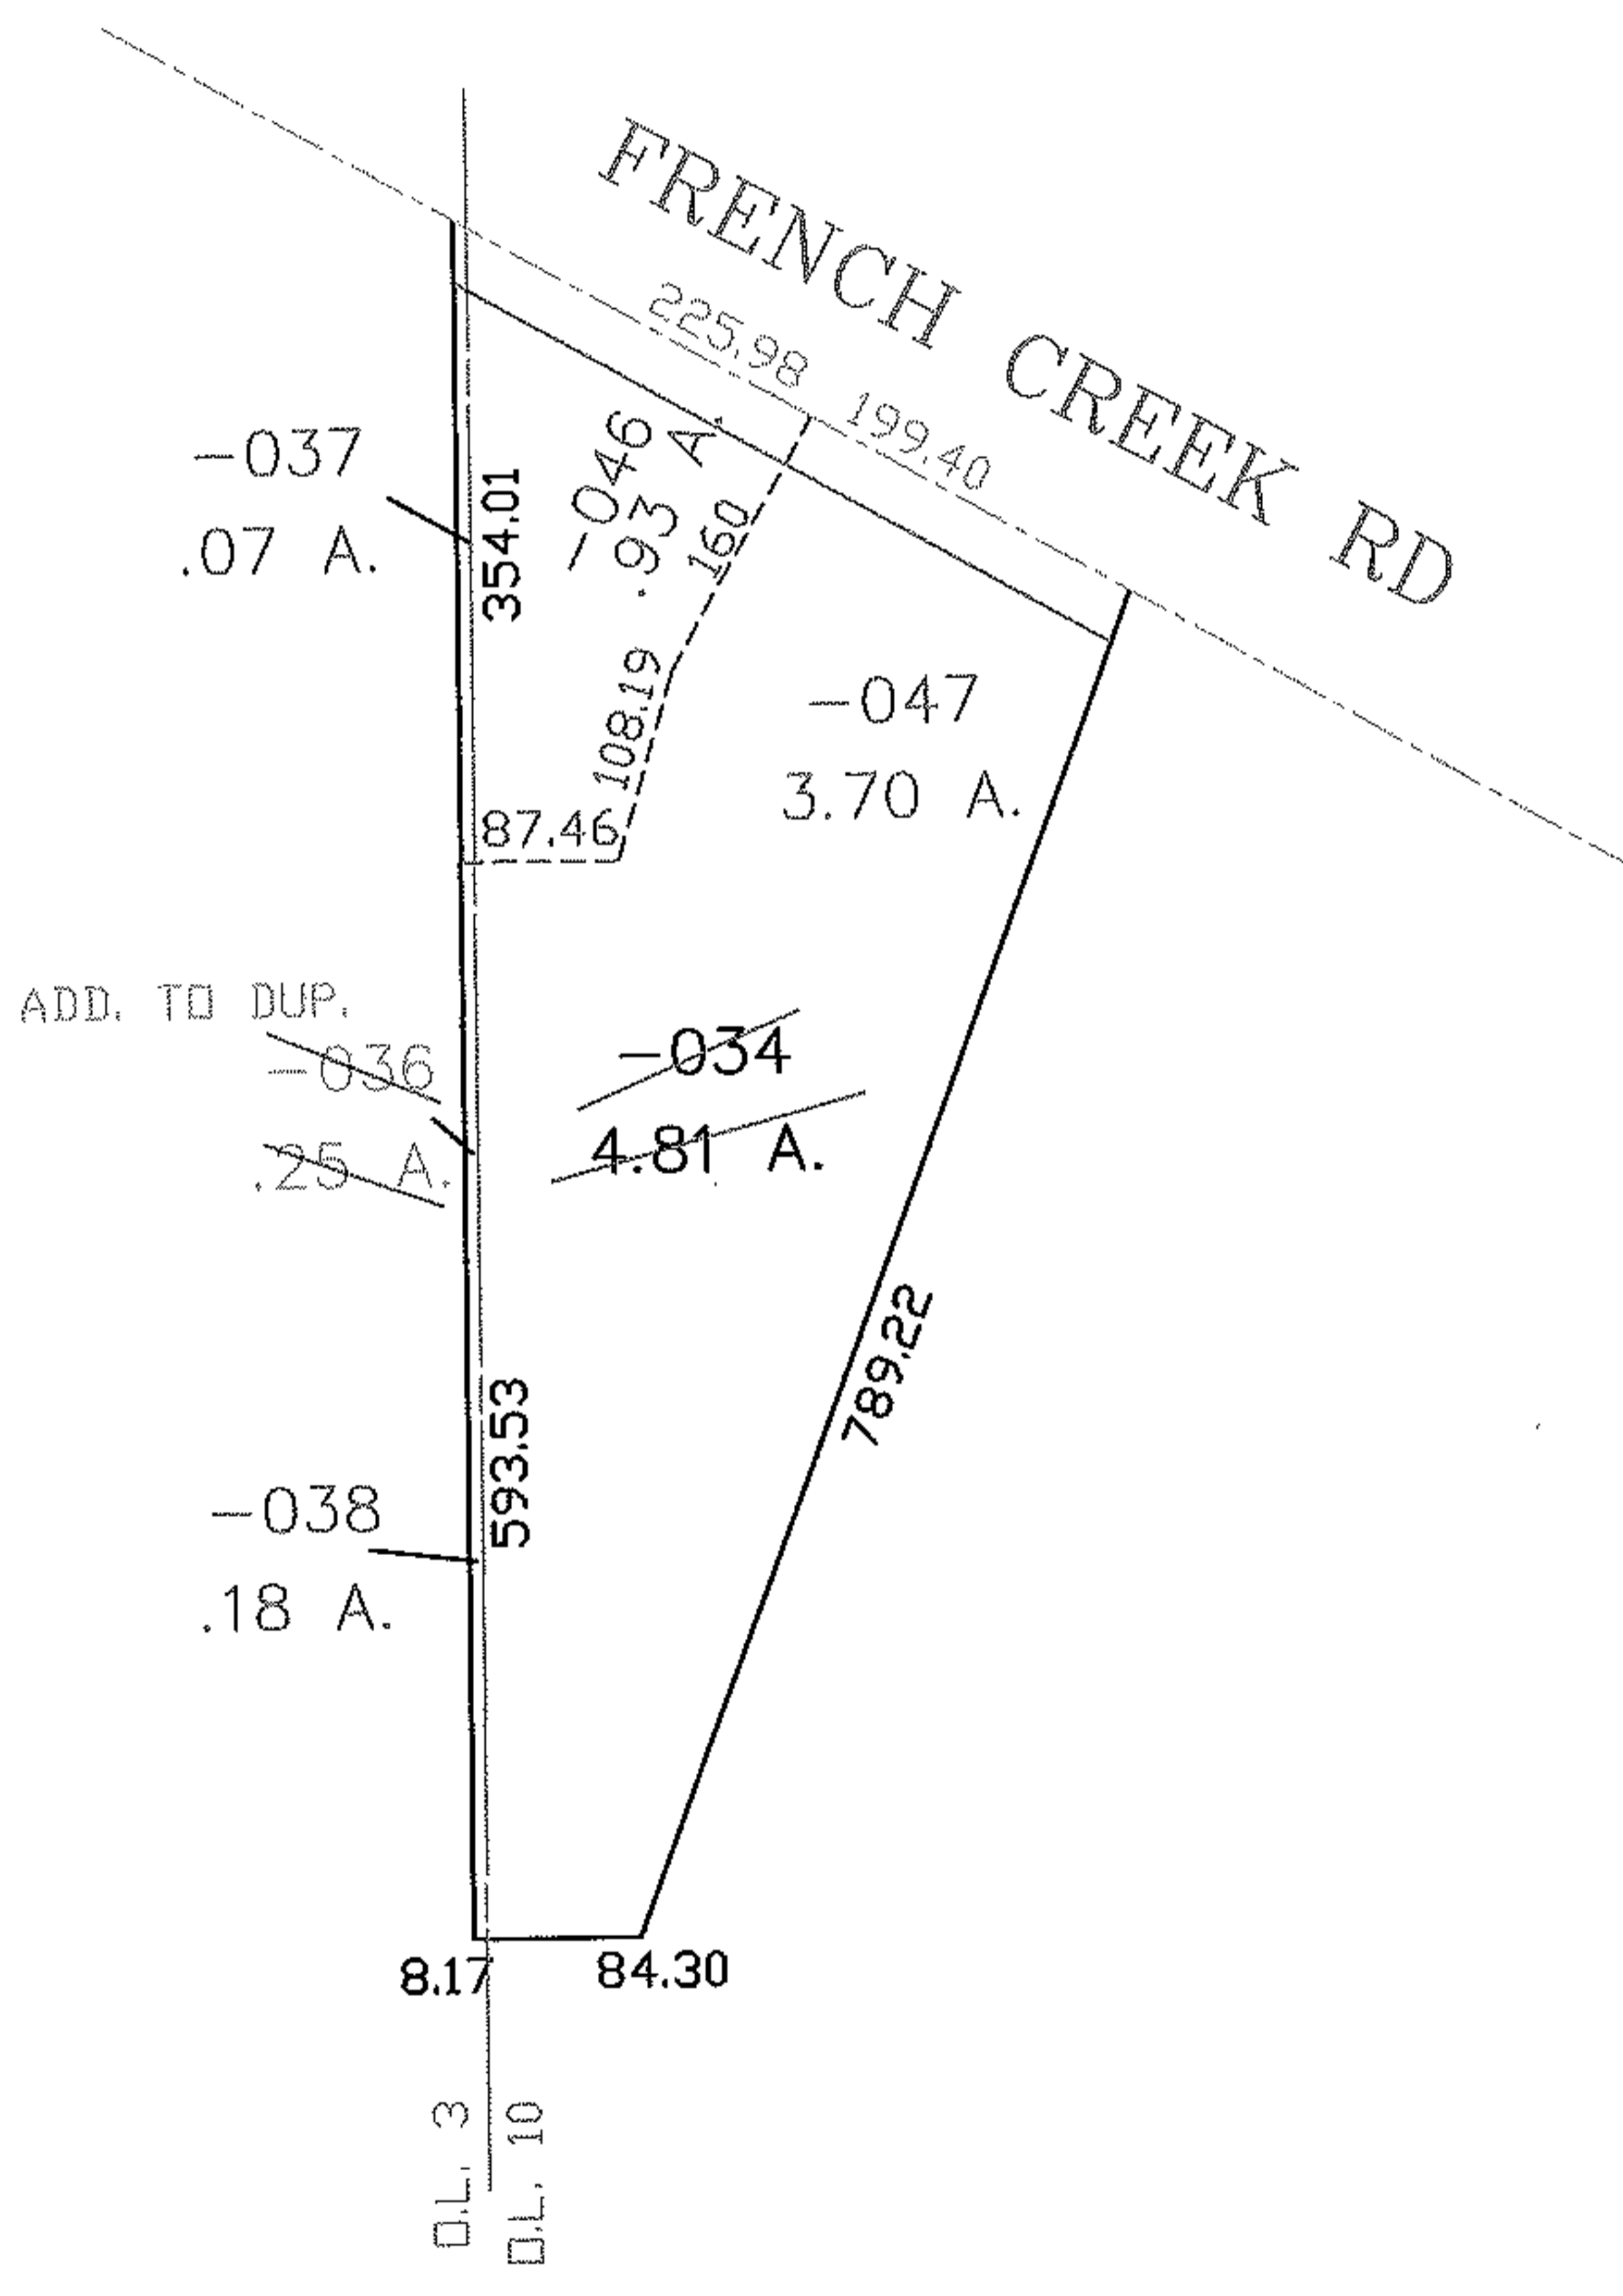


RASIER

NO. 01763

PARENT PARCEL: 04-00-010-114-034
CHILD PARCEL: 04-00-003-103-036, -037, -038, 04-00-010-114-046, -047
STARTING POINT: INT CL FRENCH CREEK AND 9.37 FT WEST OF O.L. 3 EAST LINE

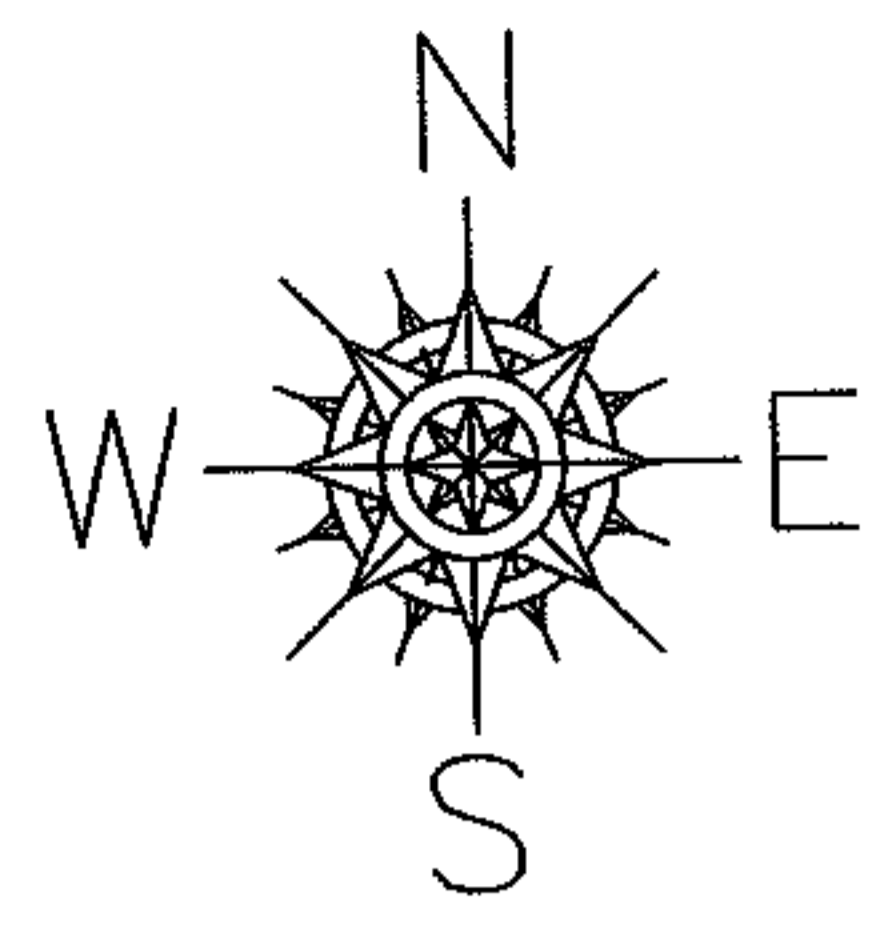

SPLITS/DEEDS PROCESSED
LORAIN COUNTY TAX MAP DEPARTMENT
226 MIDDLE AVE. ELYRIA, OHIO

SURVEYED BY: DOUGLAS H. MOSLEY
CLOSURE: 1:10:000
MAP PAGE(S): 04-00-010-E
APPROVED BY: DRH DATE: 10/14/2004
SCALE: 1" = 200 PRIOR INSTRUMENT: 03-0895545