

RASTER

PARENT PARCEL: 04-00-002-101-087


CHILD PARCEL: 04-00-002-101-171, -172

STARTING POINT: CENTERLINE OF FRENCH CREEK RD. & MOON RD.



NO. 01780

FRENCH CREEK

RD.

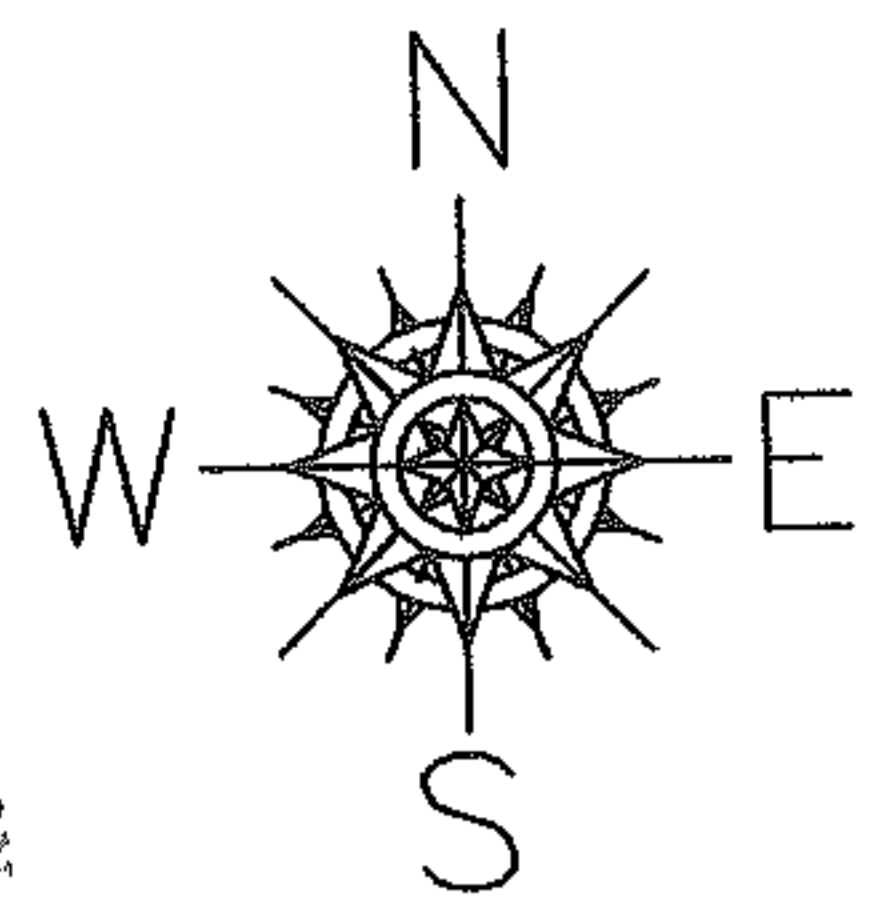

MOON

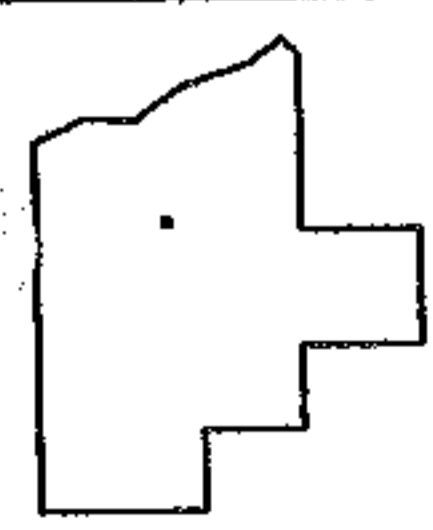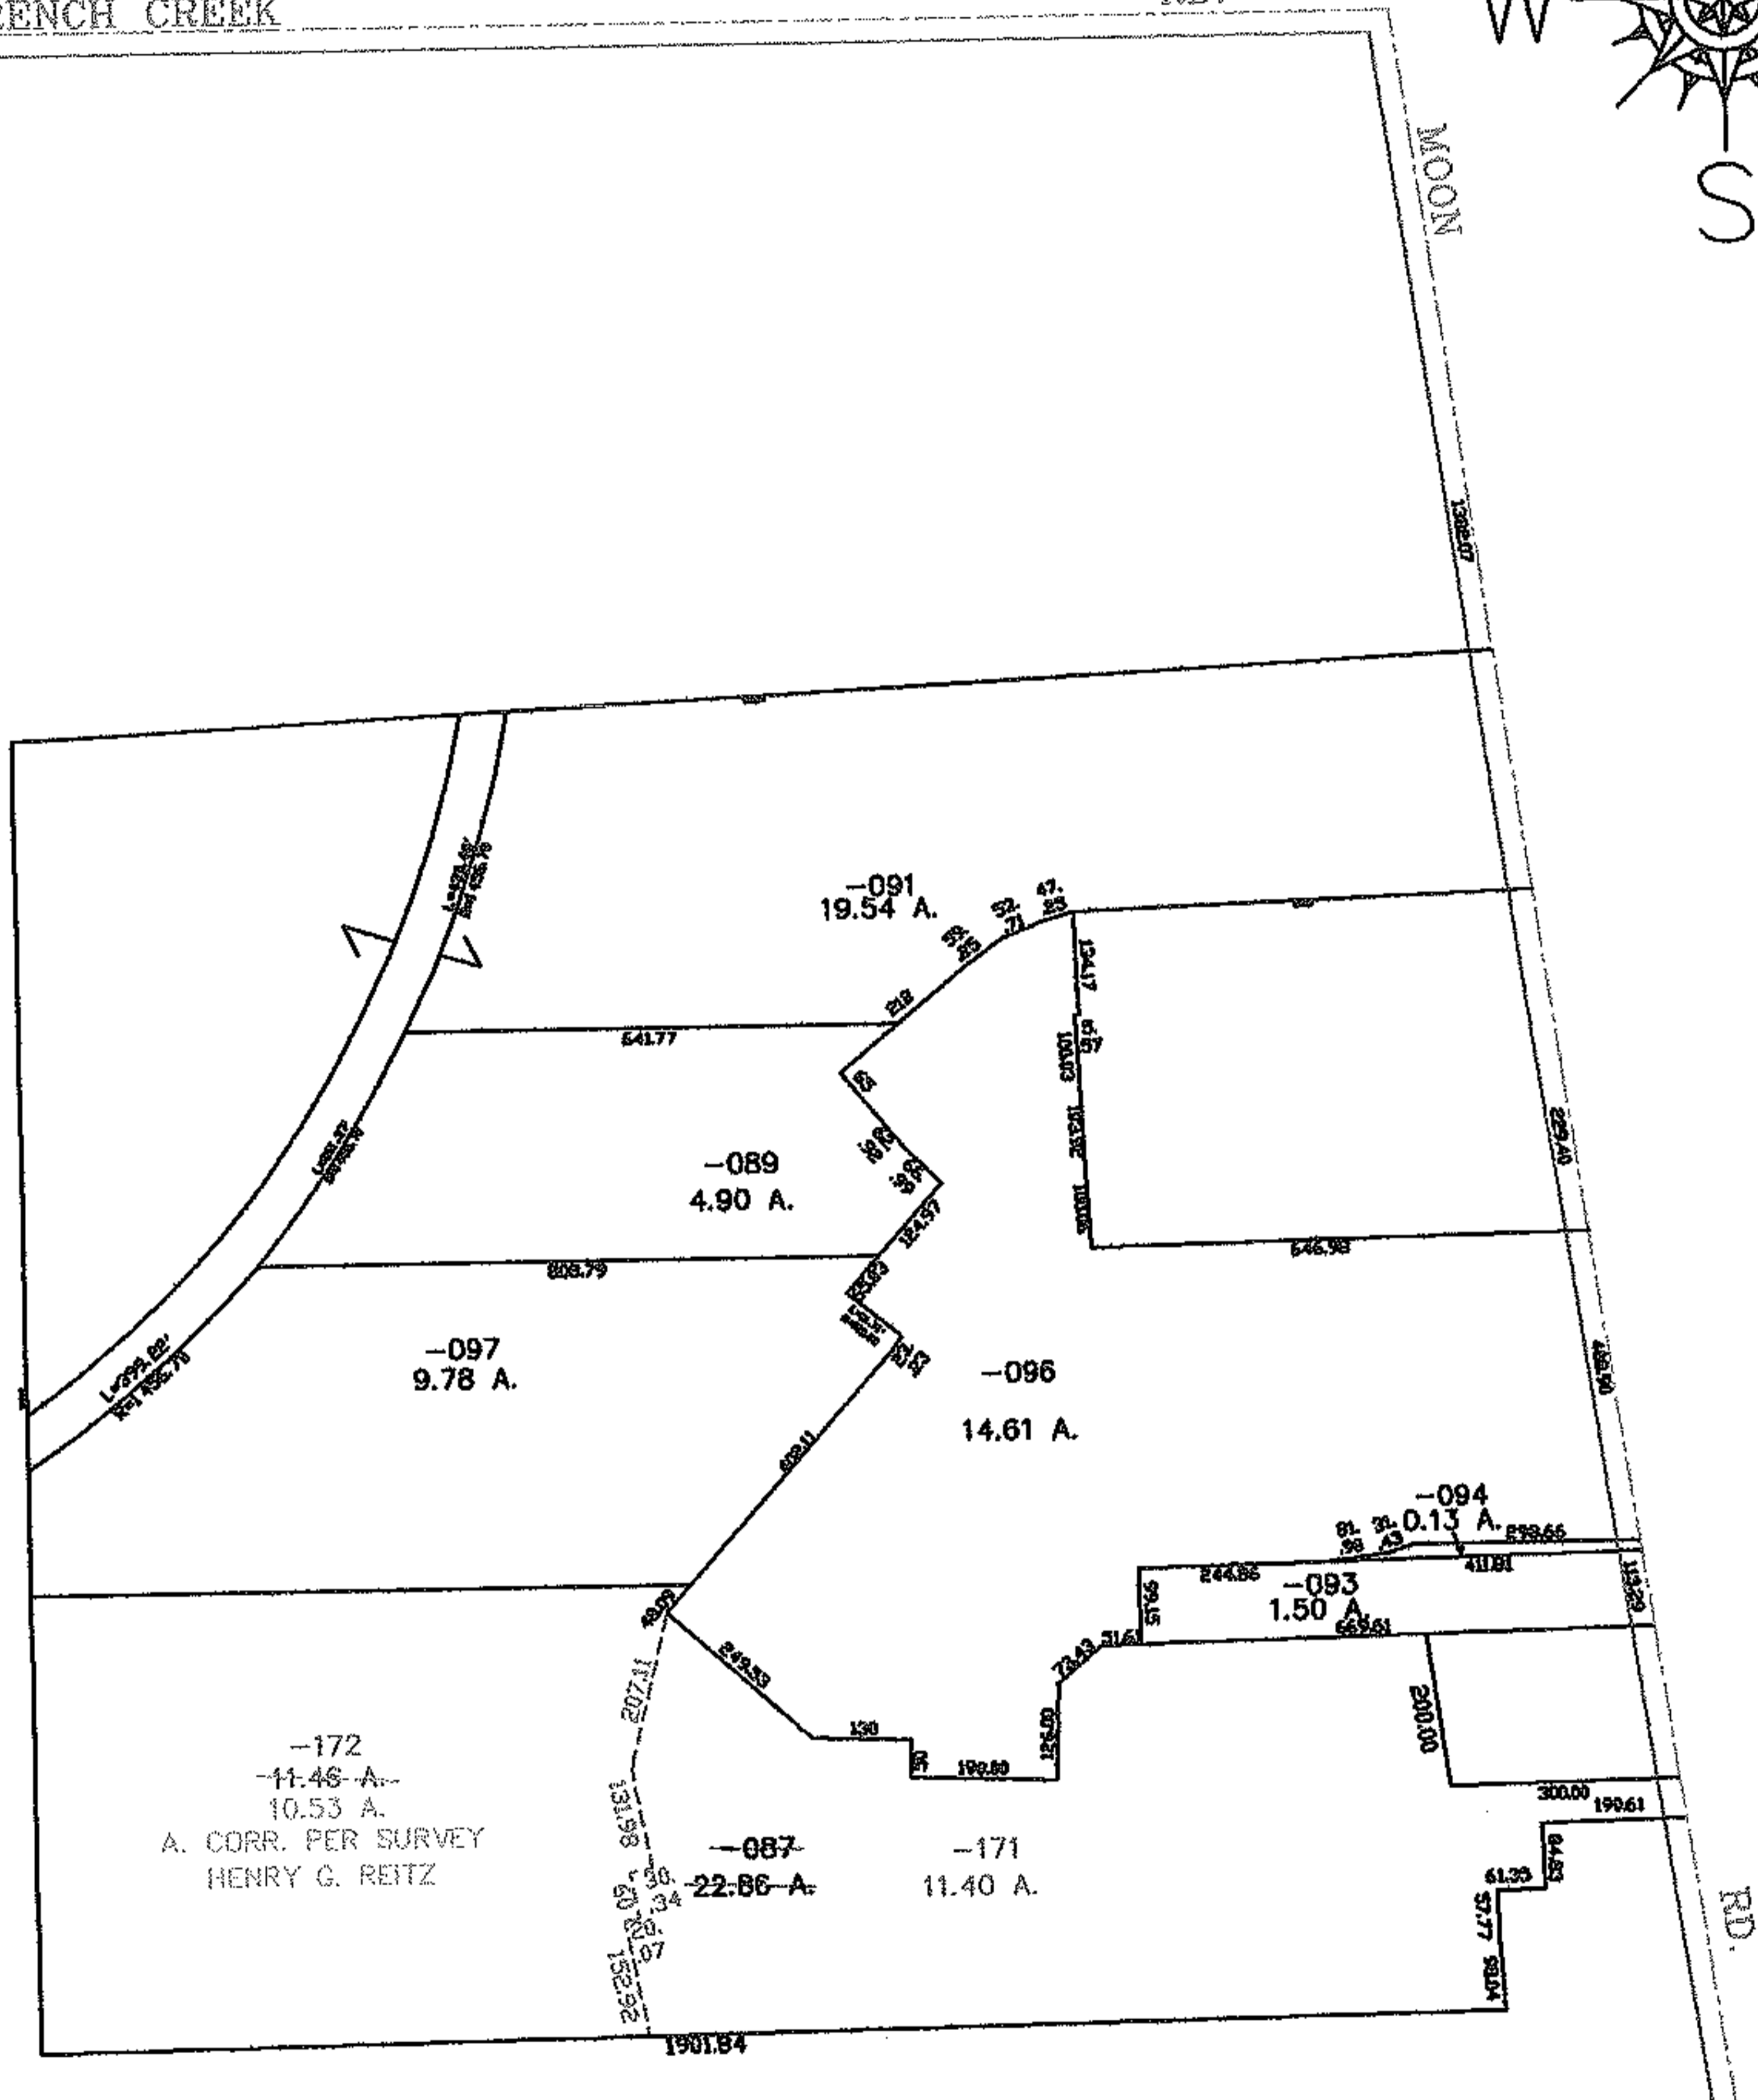

SPLITS/DEEDS PROCESSED
LORAIN COUNTY TAX MAP DEPARTMENT
226 MIDDLE AVE. ELYRIA, OHIO

SURVEYED BY: HENRY G. REITZ
CLOSURE: 0.01 : 10.000
MAP PAGE(S): 04-00-002-A, B
APPROVED BY: JAH DATE: 10-28-04
SCALE: 1" = 400 PRIOR INSTRUMENT: 19970865507