


# 07 01785

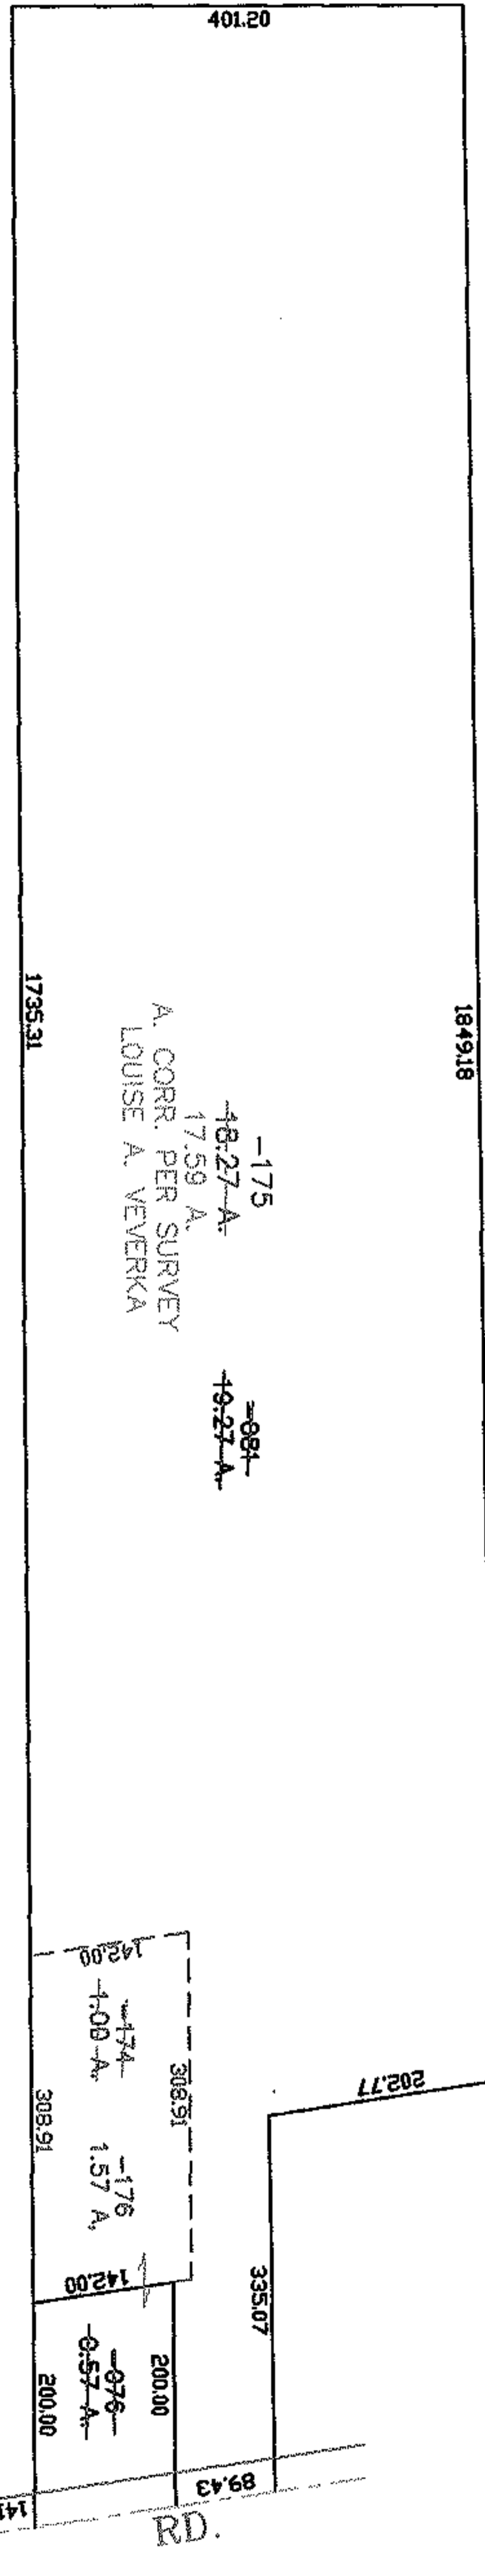

DETROIT RD.