


RASTER

PARENT PARCEL: 05-00-037-113-037, -039, -040

CHILD PARCEL: 05-00-037-113-041 THRU -053



STARTING POINT: SIDELINE OF FRANKLIN AVE. & HAZEL ST.

NO. 01785

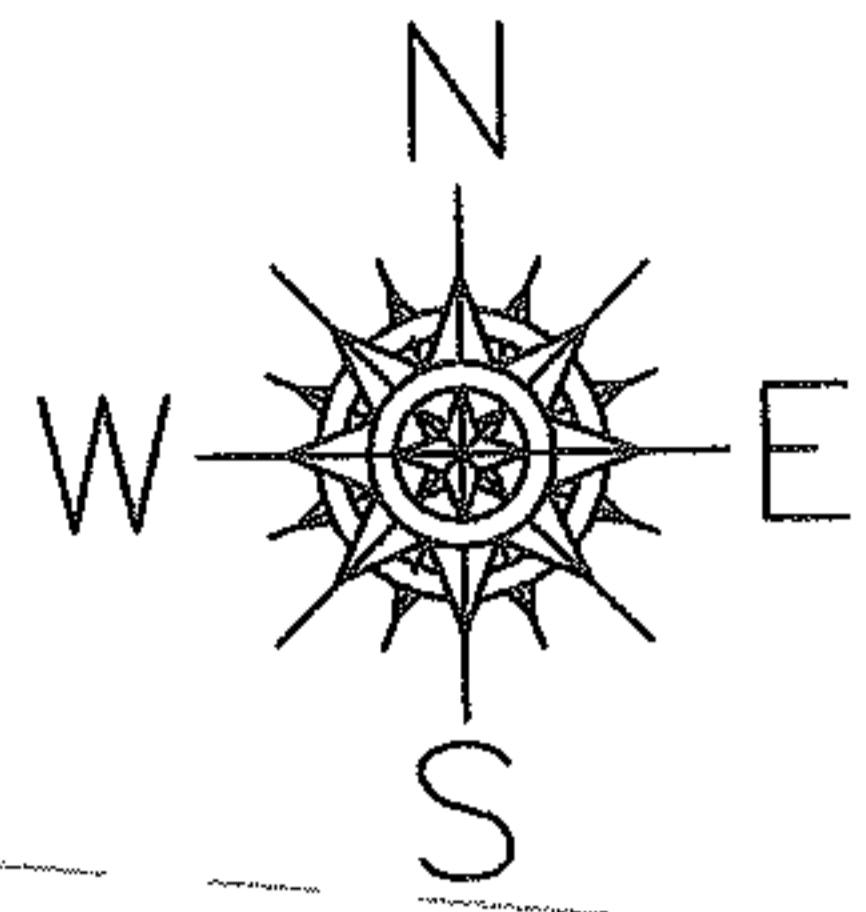

FRANKLIN AVE.

HAZEL ST.

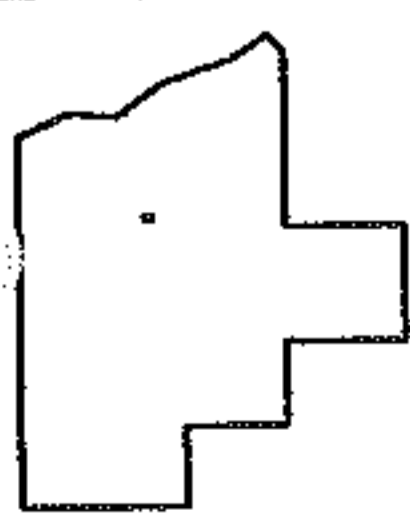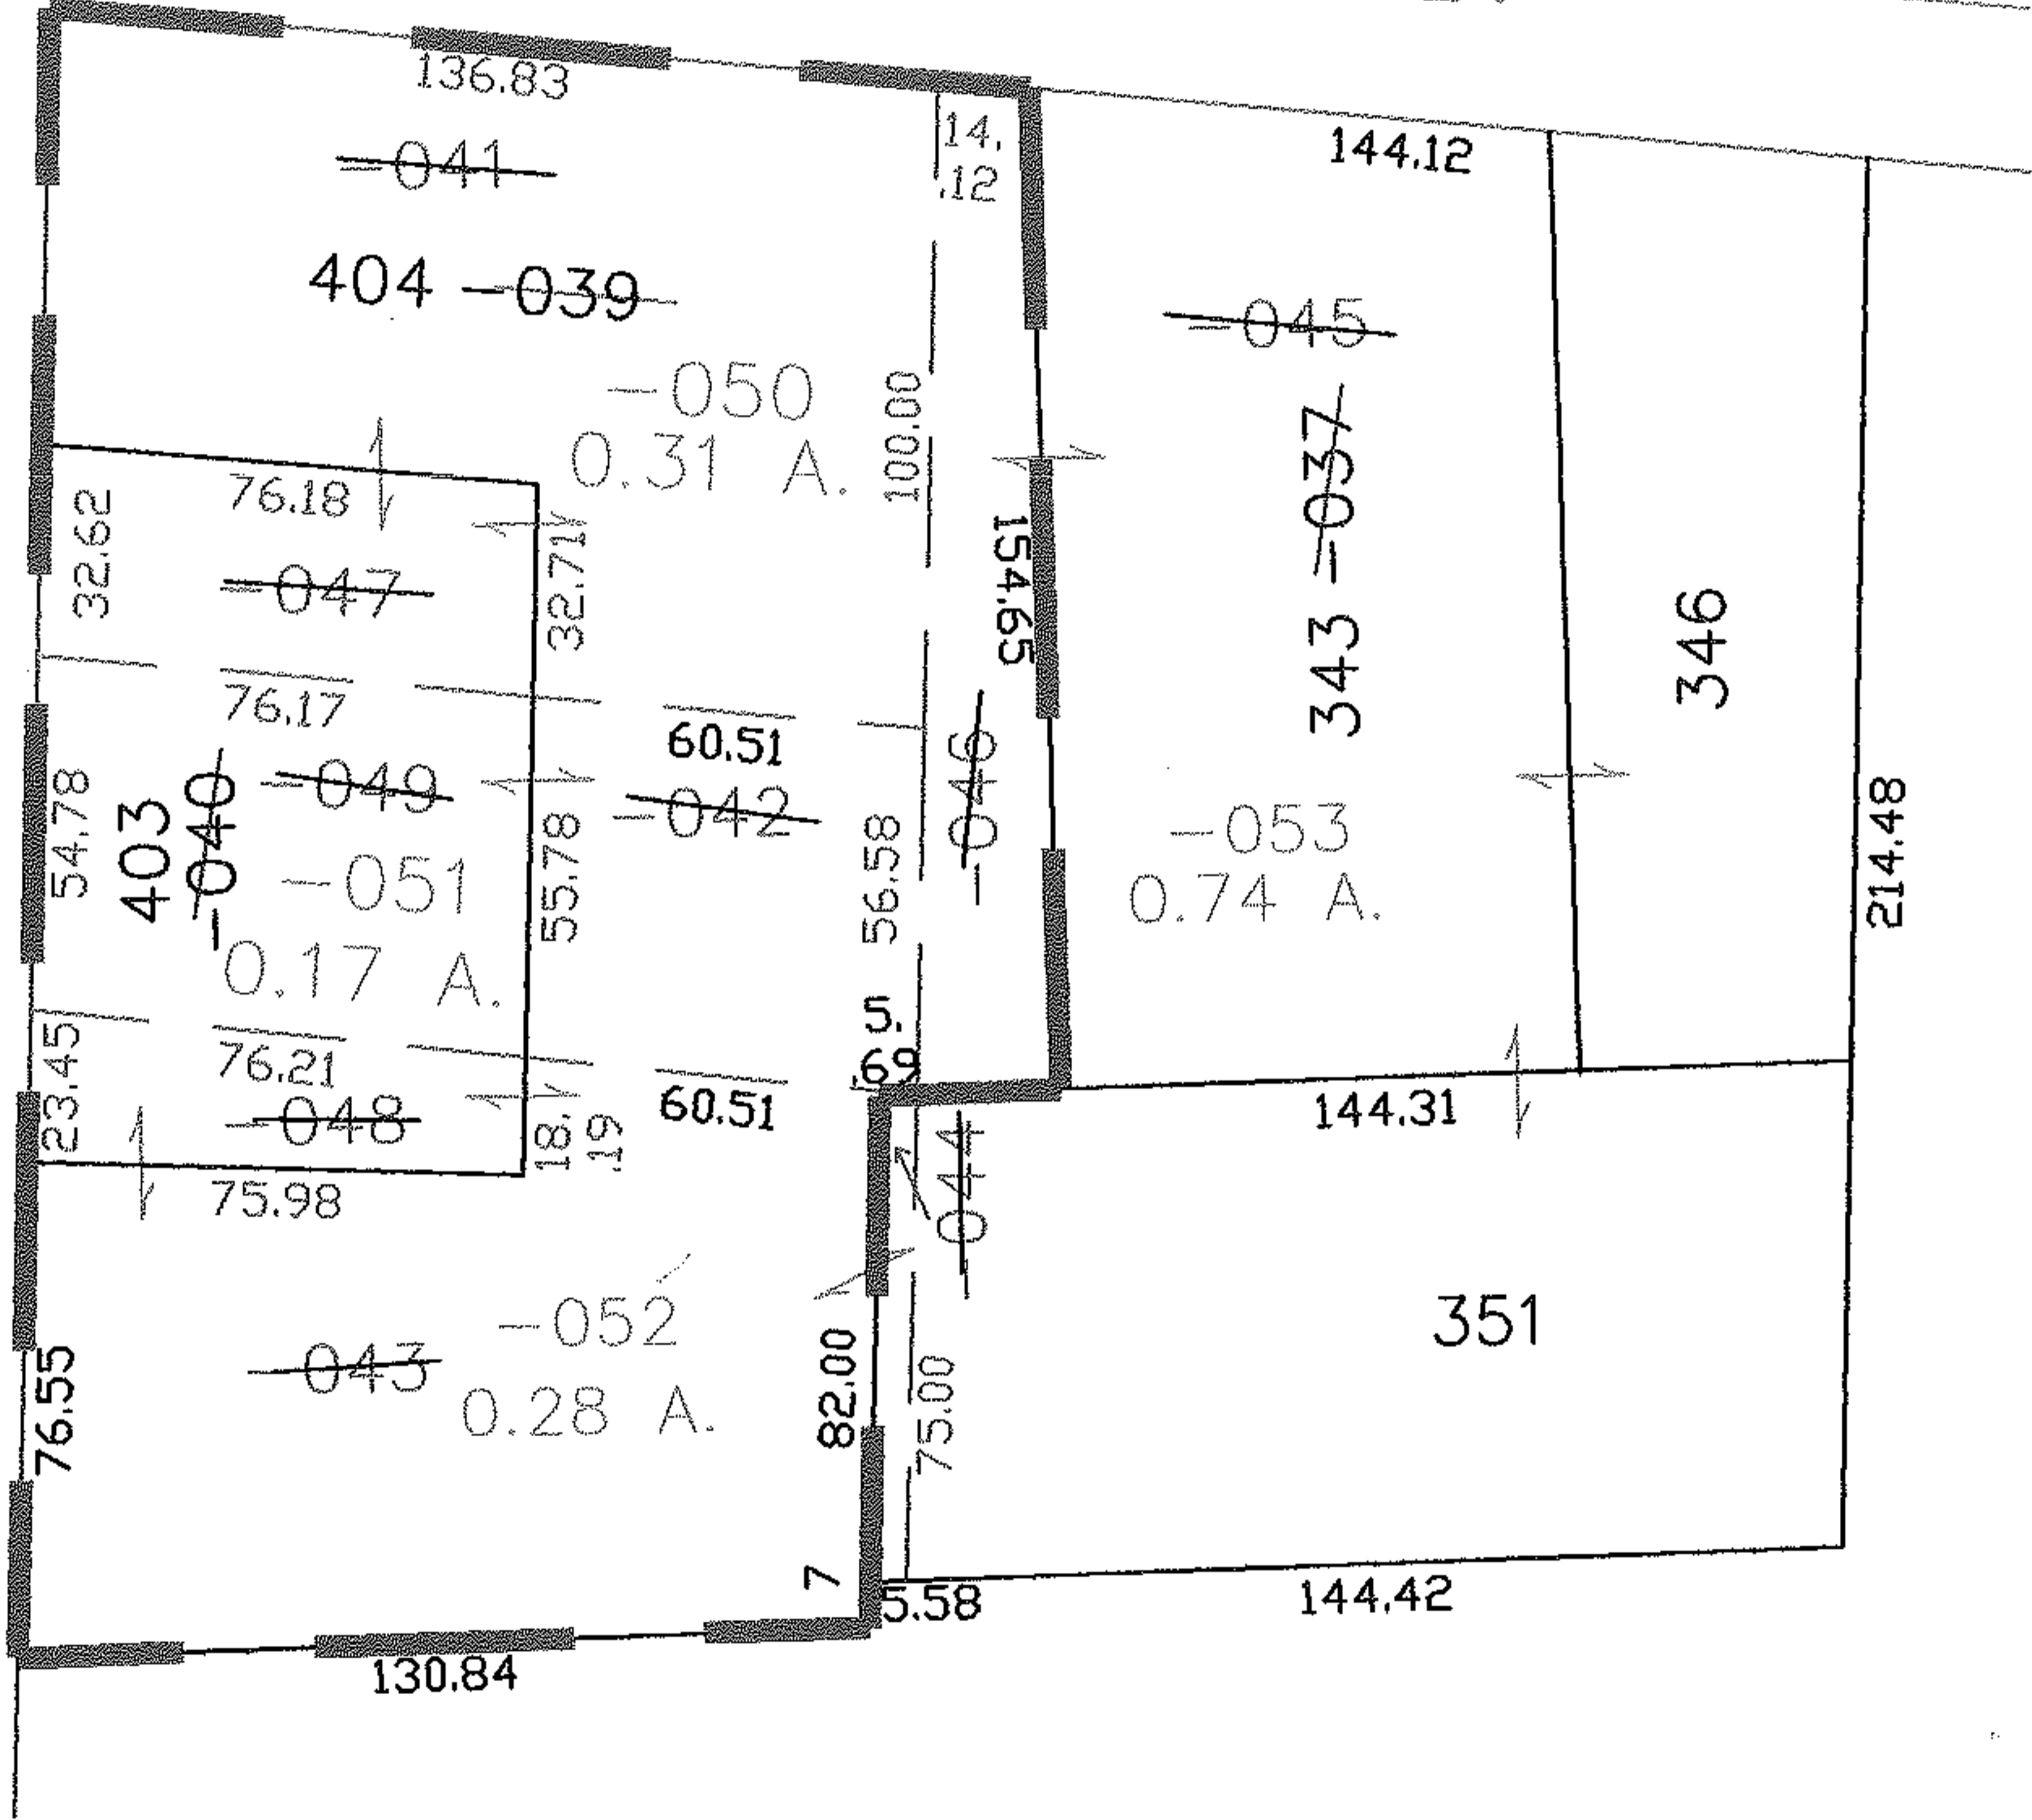

SPLITS/DEEDS PROCESSED

LORAIN COUNTY TAX MAP DEPARTMENT
226 MIDDLE AVE. ELYRIA, OHIO

SURVEYED BY: PHILIP A. ROSEBECK

CLOSURE: 0.00 : 10.000

MAP PAGE(S): 05-00-037-B

APPROVED BY: JAH DATE: 11-4-04

SCALE: 1" = 100 PRIOR INSTRUMENT: DV 971/227