
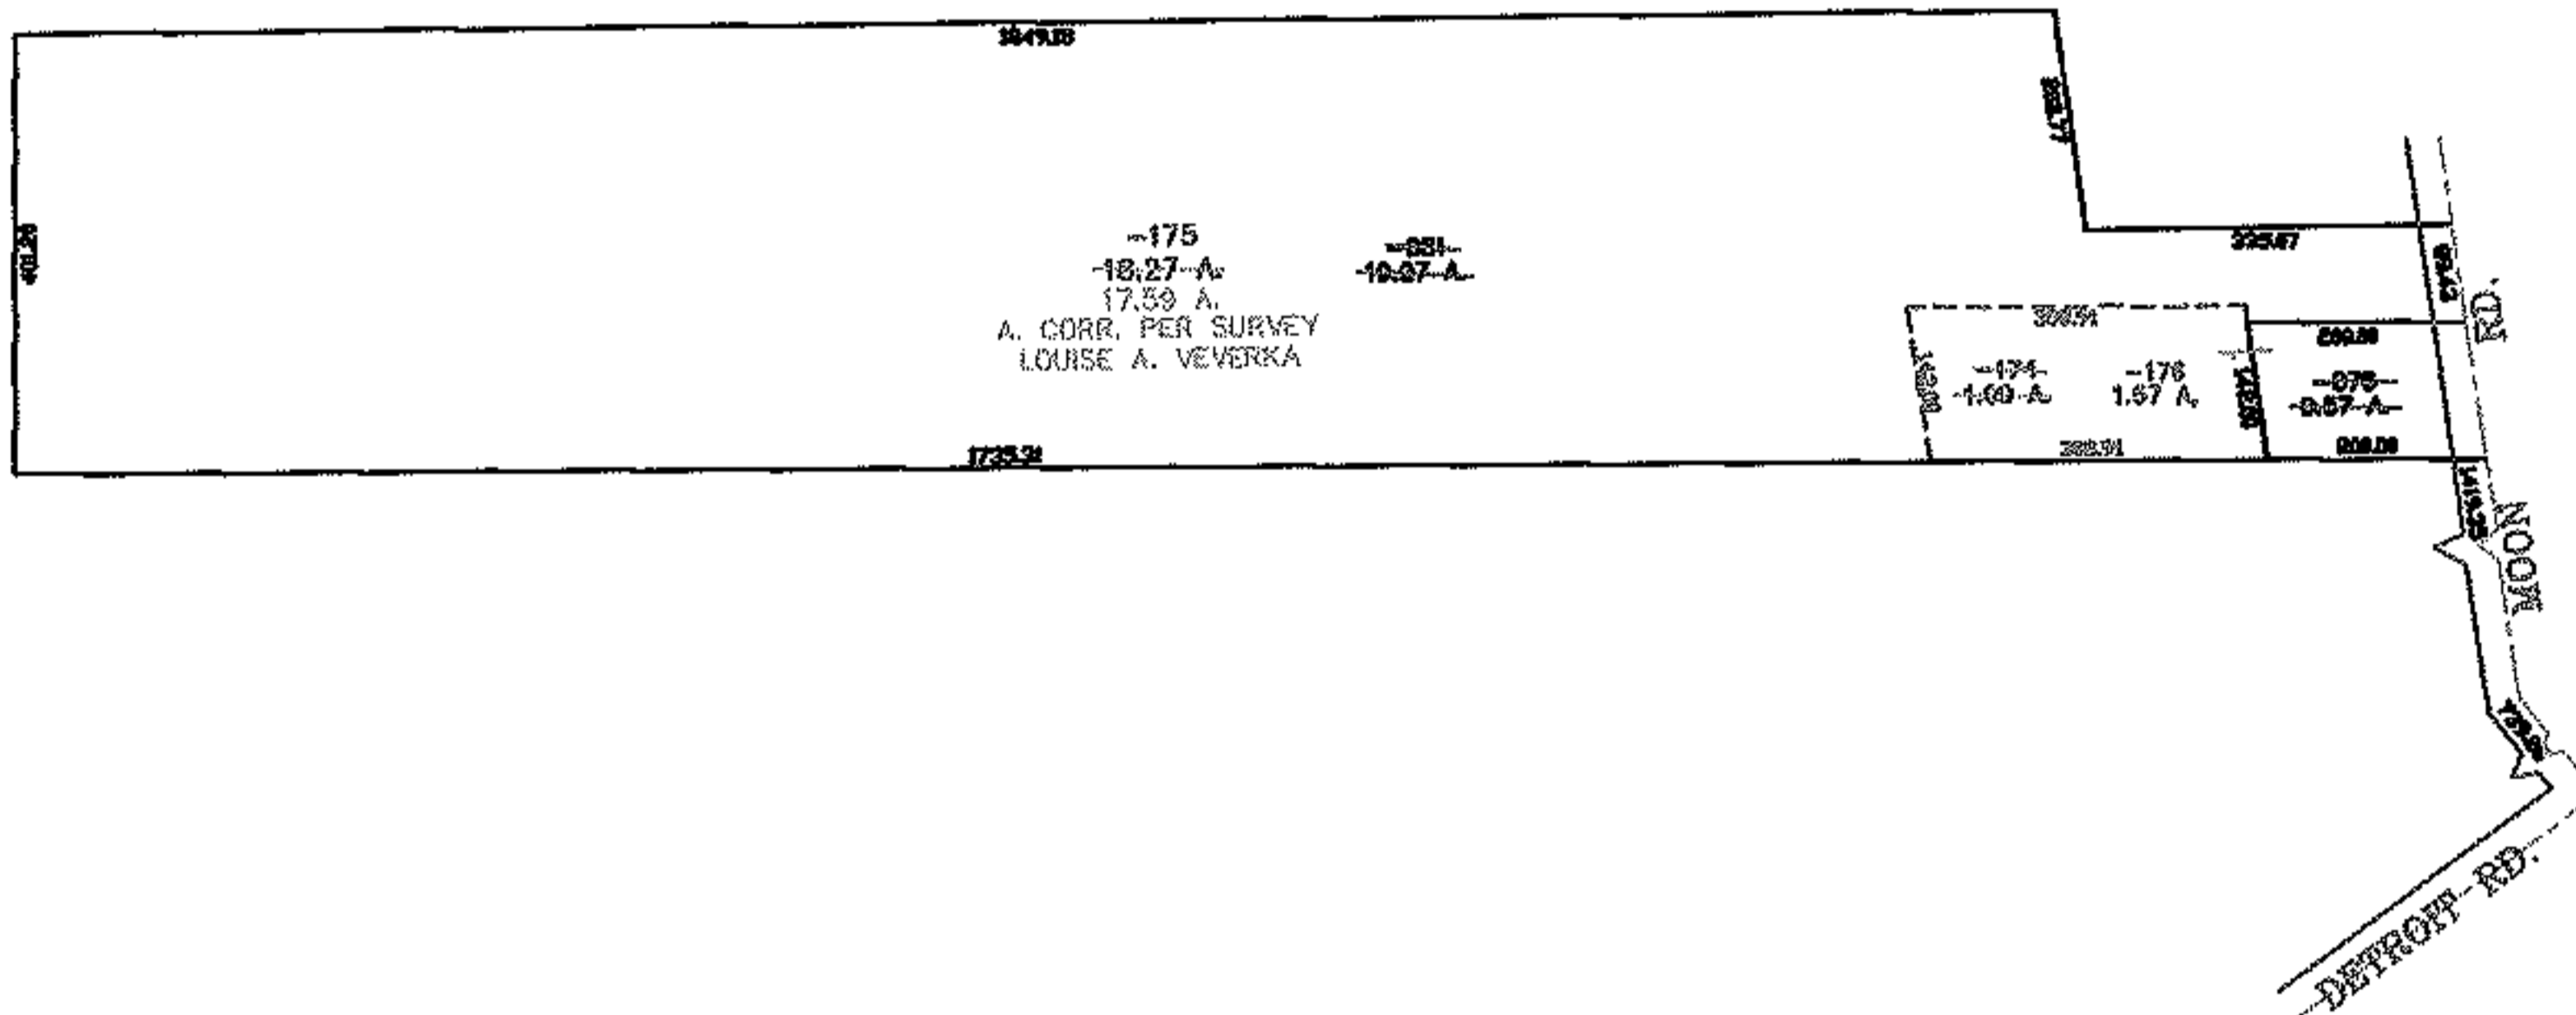


RASTER

PARENT PARCEL: 04-00-002-101-081, -076
CHILD PARCEL: 04-00-002-101-174 THRU -176
STARTING POINT: CENTERLINE OF MOON RD. & DETROIT RD.

NO. 01786

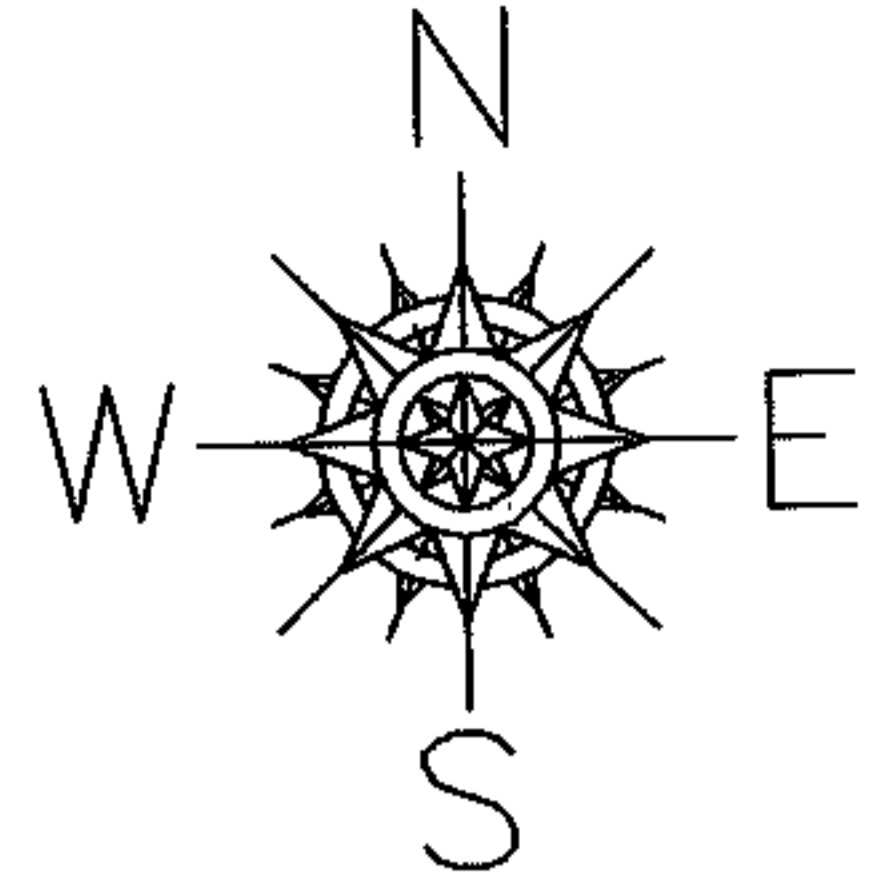

SPLITS/DEEDS PROCESSED
LORAIN COUNTY TAX MAP DEPARTMENT
226 MIDDLE AVE. ELYRIA, OHIO

SURVEYED BY: LOUISE A. VEVERKA
CLOSURE: 0.00 : 10.000
MAP PAGE(S): 04-00-002-E
APPROVED BY: JAH DATE: 3-10-05
SCALE: 1" = 400 PRIOR INSTRUMENT: 20010777978