
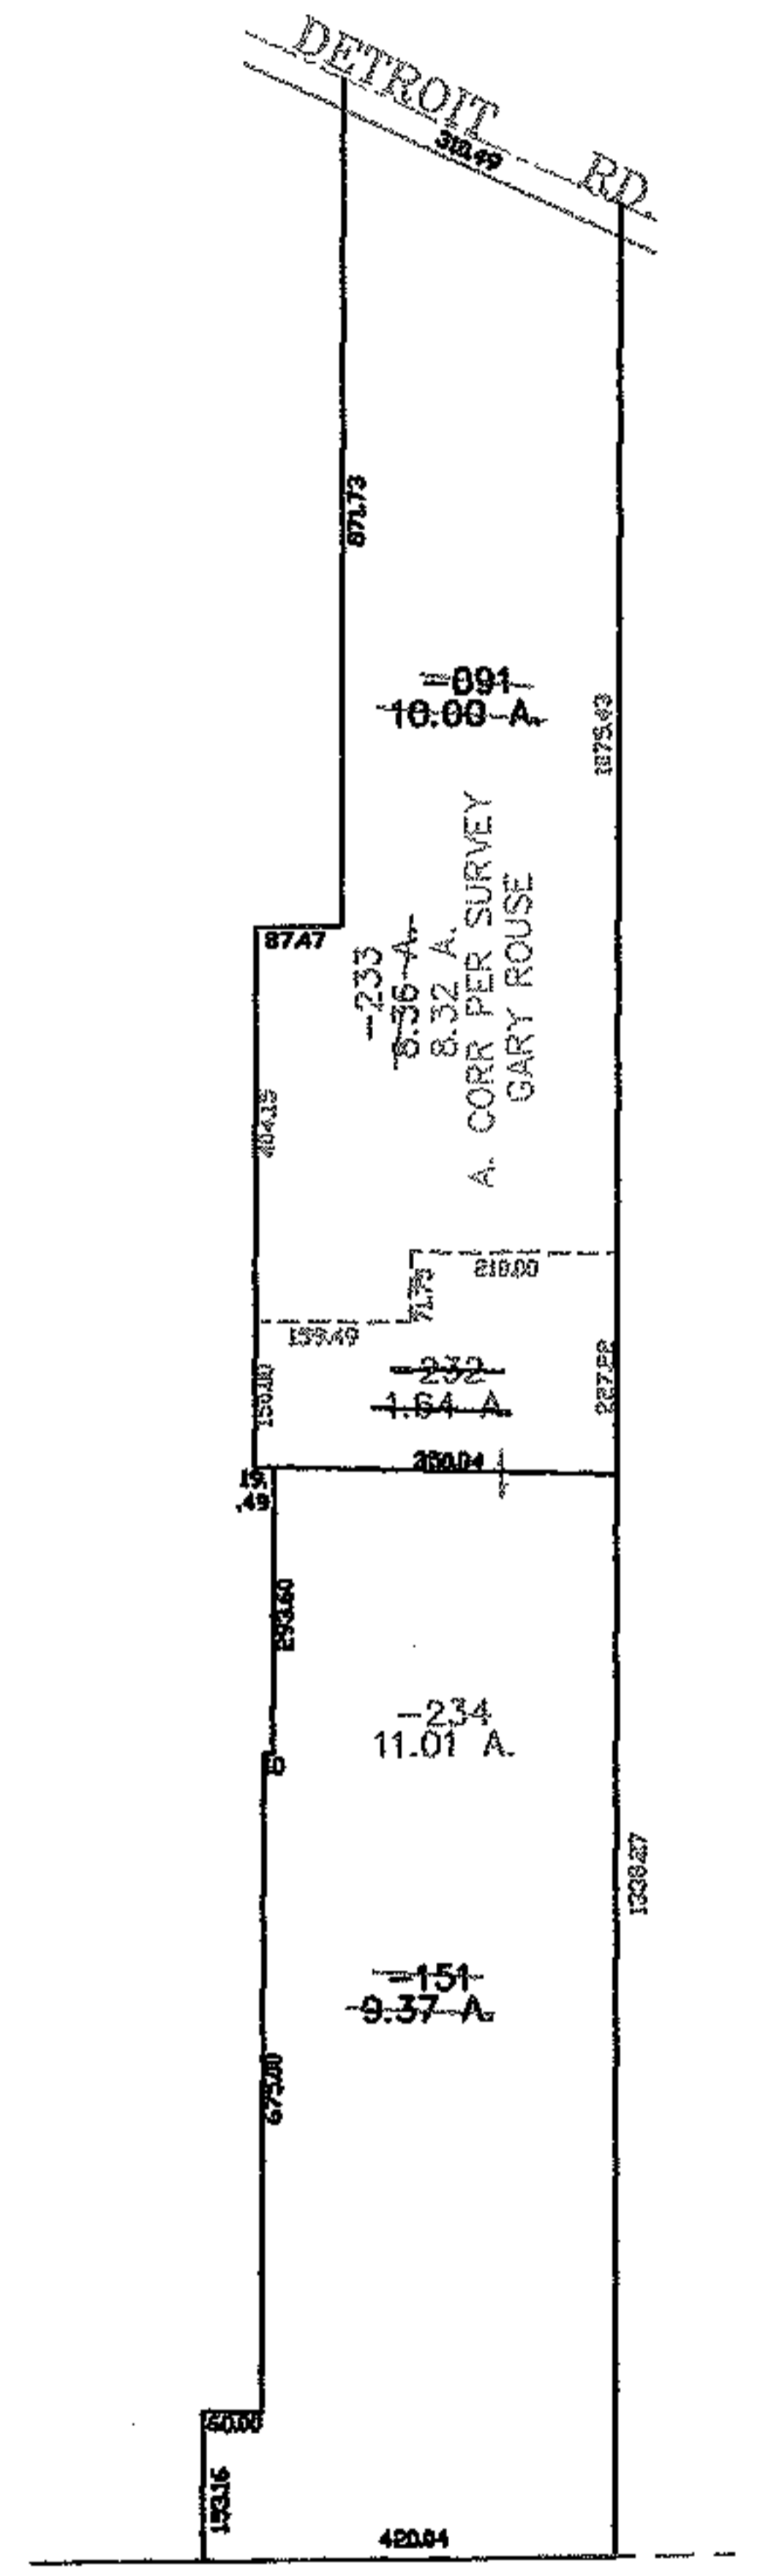



RASTER

PARENT PARCEL: 04-00-015-110-091, -151  
CHILD PARCEL: 04-00-015-110-232 THRU -234  
STARTING POINT: NORTHEAST CORNER OF BENTLEY PARK SUBD. NO. 4

NO. 01787

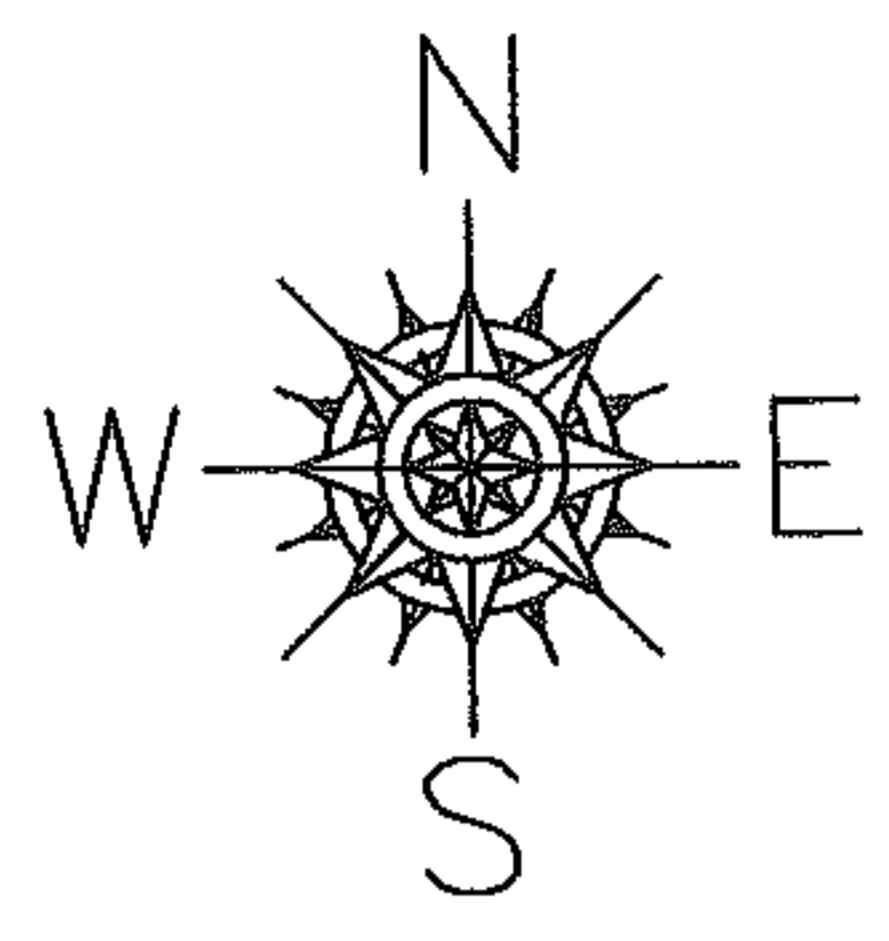

BENTLEY PARK SUBD. NO 4  
VOL 78 PGS. 53-55

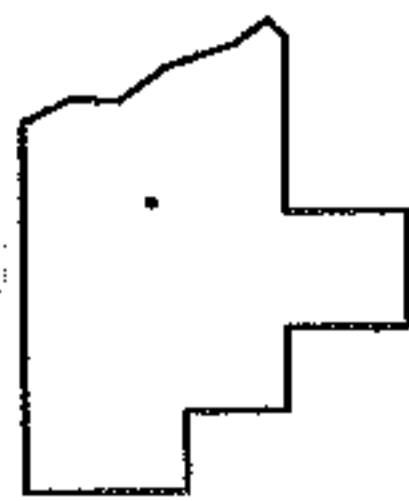

**SPLITS/DEEDS PROCESSED**  
LORAIN COUNTY TAX MAP DEPARTMENT  
226 MIDDLE AVE. ELYRIA, OHIO

SURVEYED BY: GARY ROUSE  
CLOSURE: 0.00 : 10.000  
MAP PAGE(S): 04-00-015-H  
APPROVED BY: JAH DATE: 2-1-05  
SCALE: 1" = 400 PRIOR INSTRUMENT: 990648788