




RASTER

PARENT PARCEL: 10-00-002-000-013

CHILD PARCEL: 10-00-002-000-057, -058

STARTING POINT: CENTERLINE OF MURRAY RIDGE RD. & RUSSIA RD.

NO. 01794

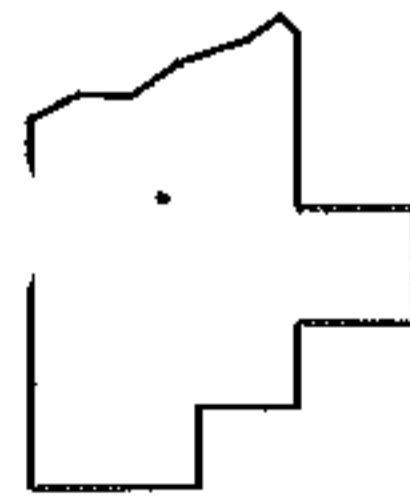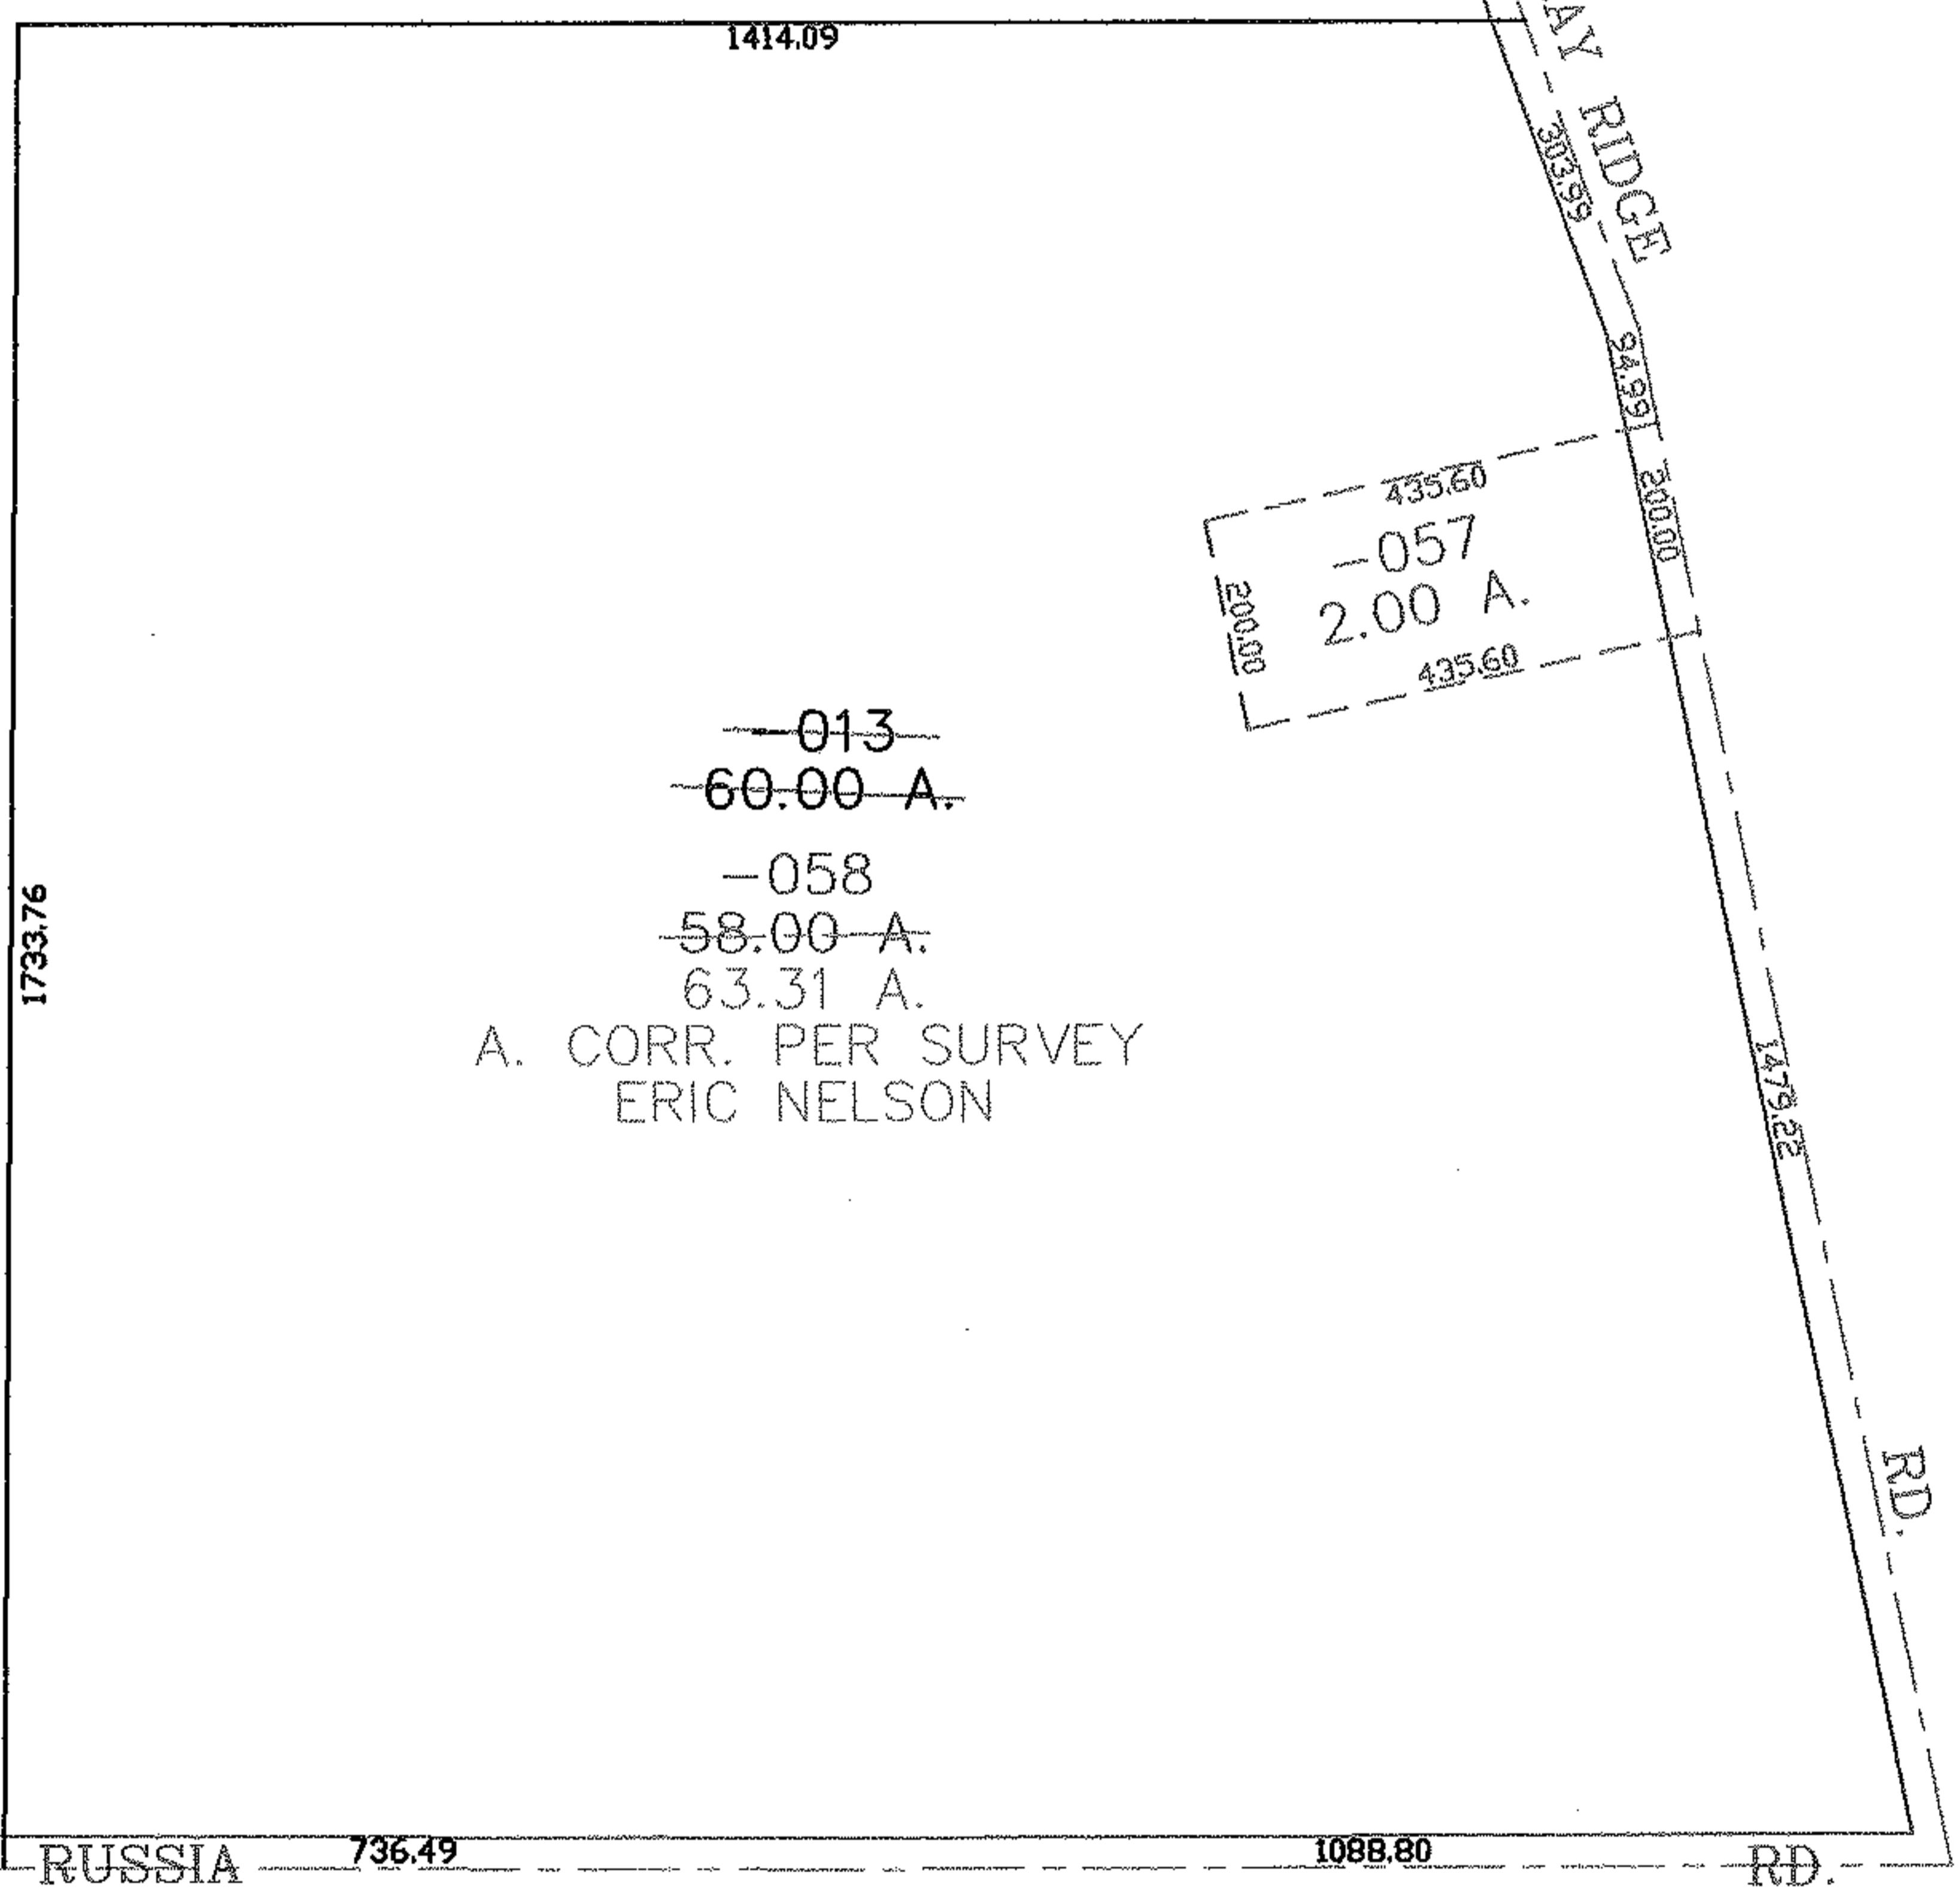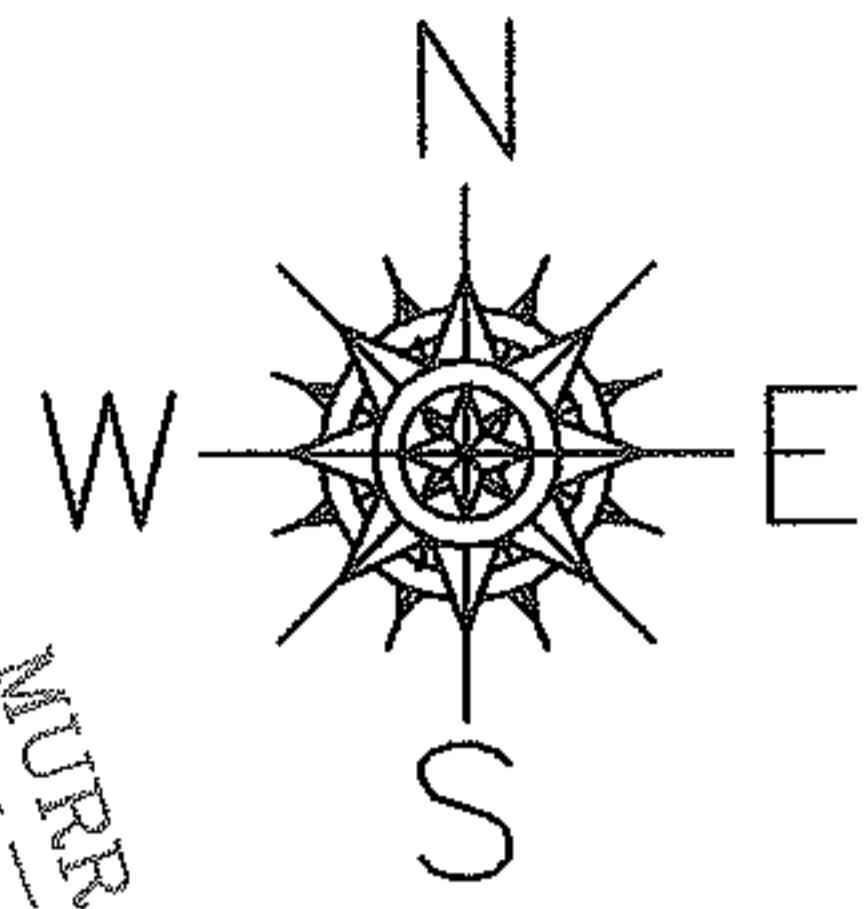

SPLITS/DEEDS PROCESSED

LORAIN COUNTY TAX MAP DEPARTMENT
226 MIDDLE AVE. ELYRIA, OHIO

SURVEYED BY: ERIC NELSON

CLOSURE: 0.00 : 10.000

MAP PAGE(S): 10-B

APPROVED BY: JAH DATE: 12-1-04

SCALE: 1" = 300 PRIOR INSTRUMENT: 19990592282