


RASTER

PARENT PARCEL: 07-00-002-102-040, -033, -058 07-00-011-106-002



CHILD PARCEL: 07-00-011-106-002, 07-00-002-102-218

STARTING POINT: CENTERLINE OF DEERSPRING CT. & GATE STONE DR.

NO. 01795

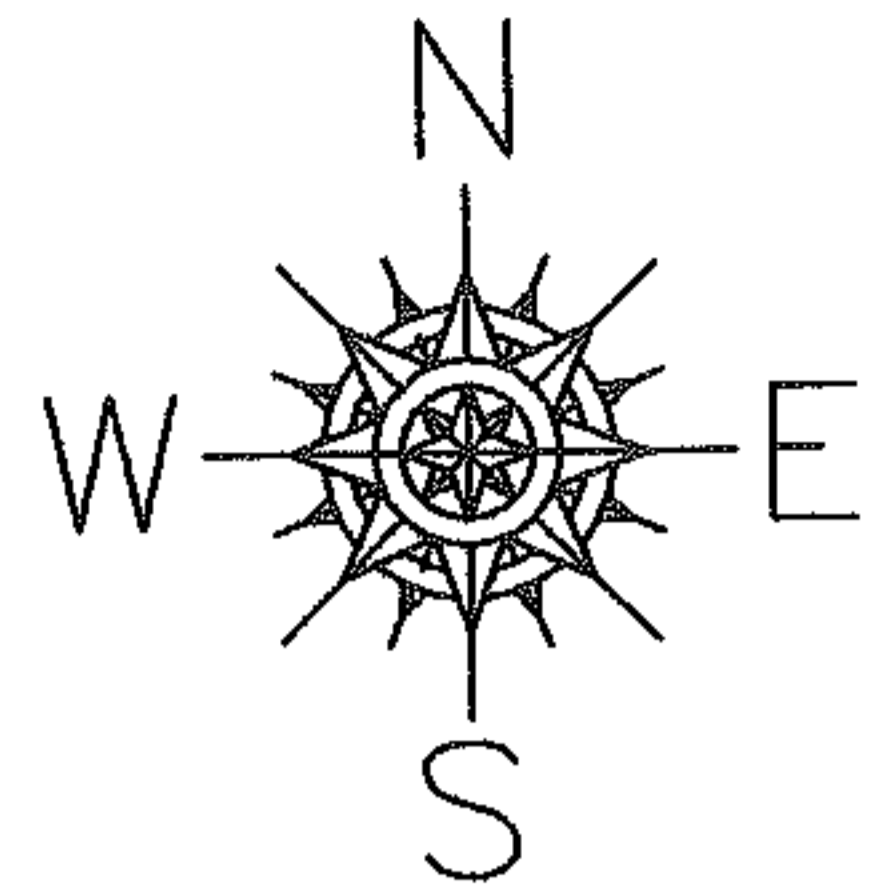

GATE STONE DR.

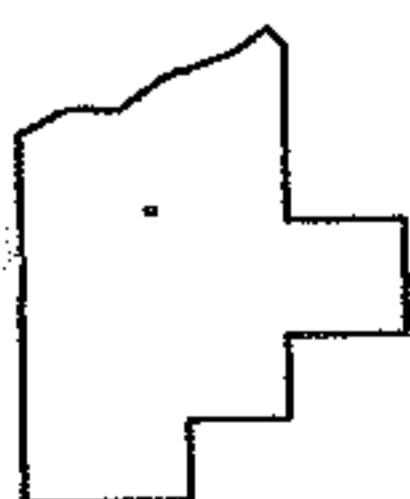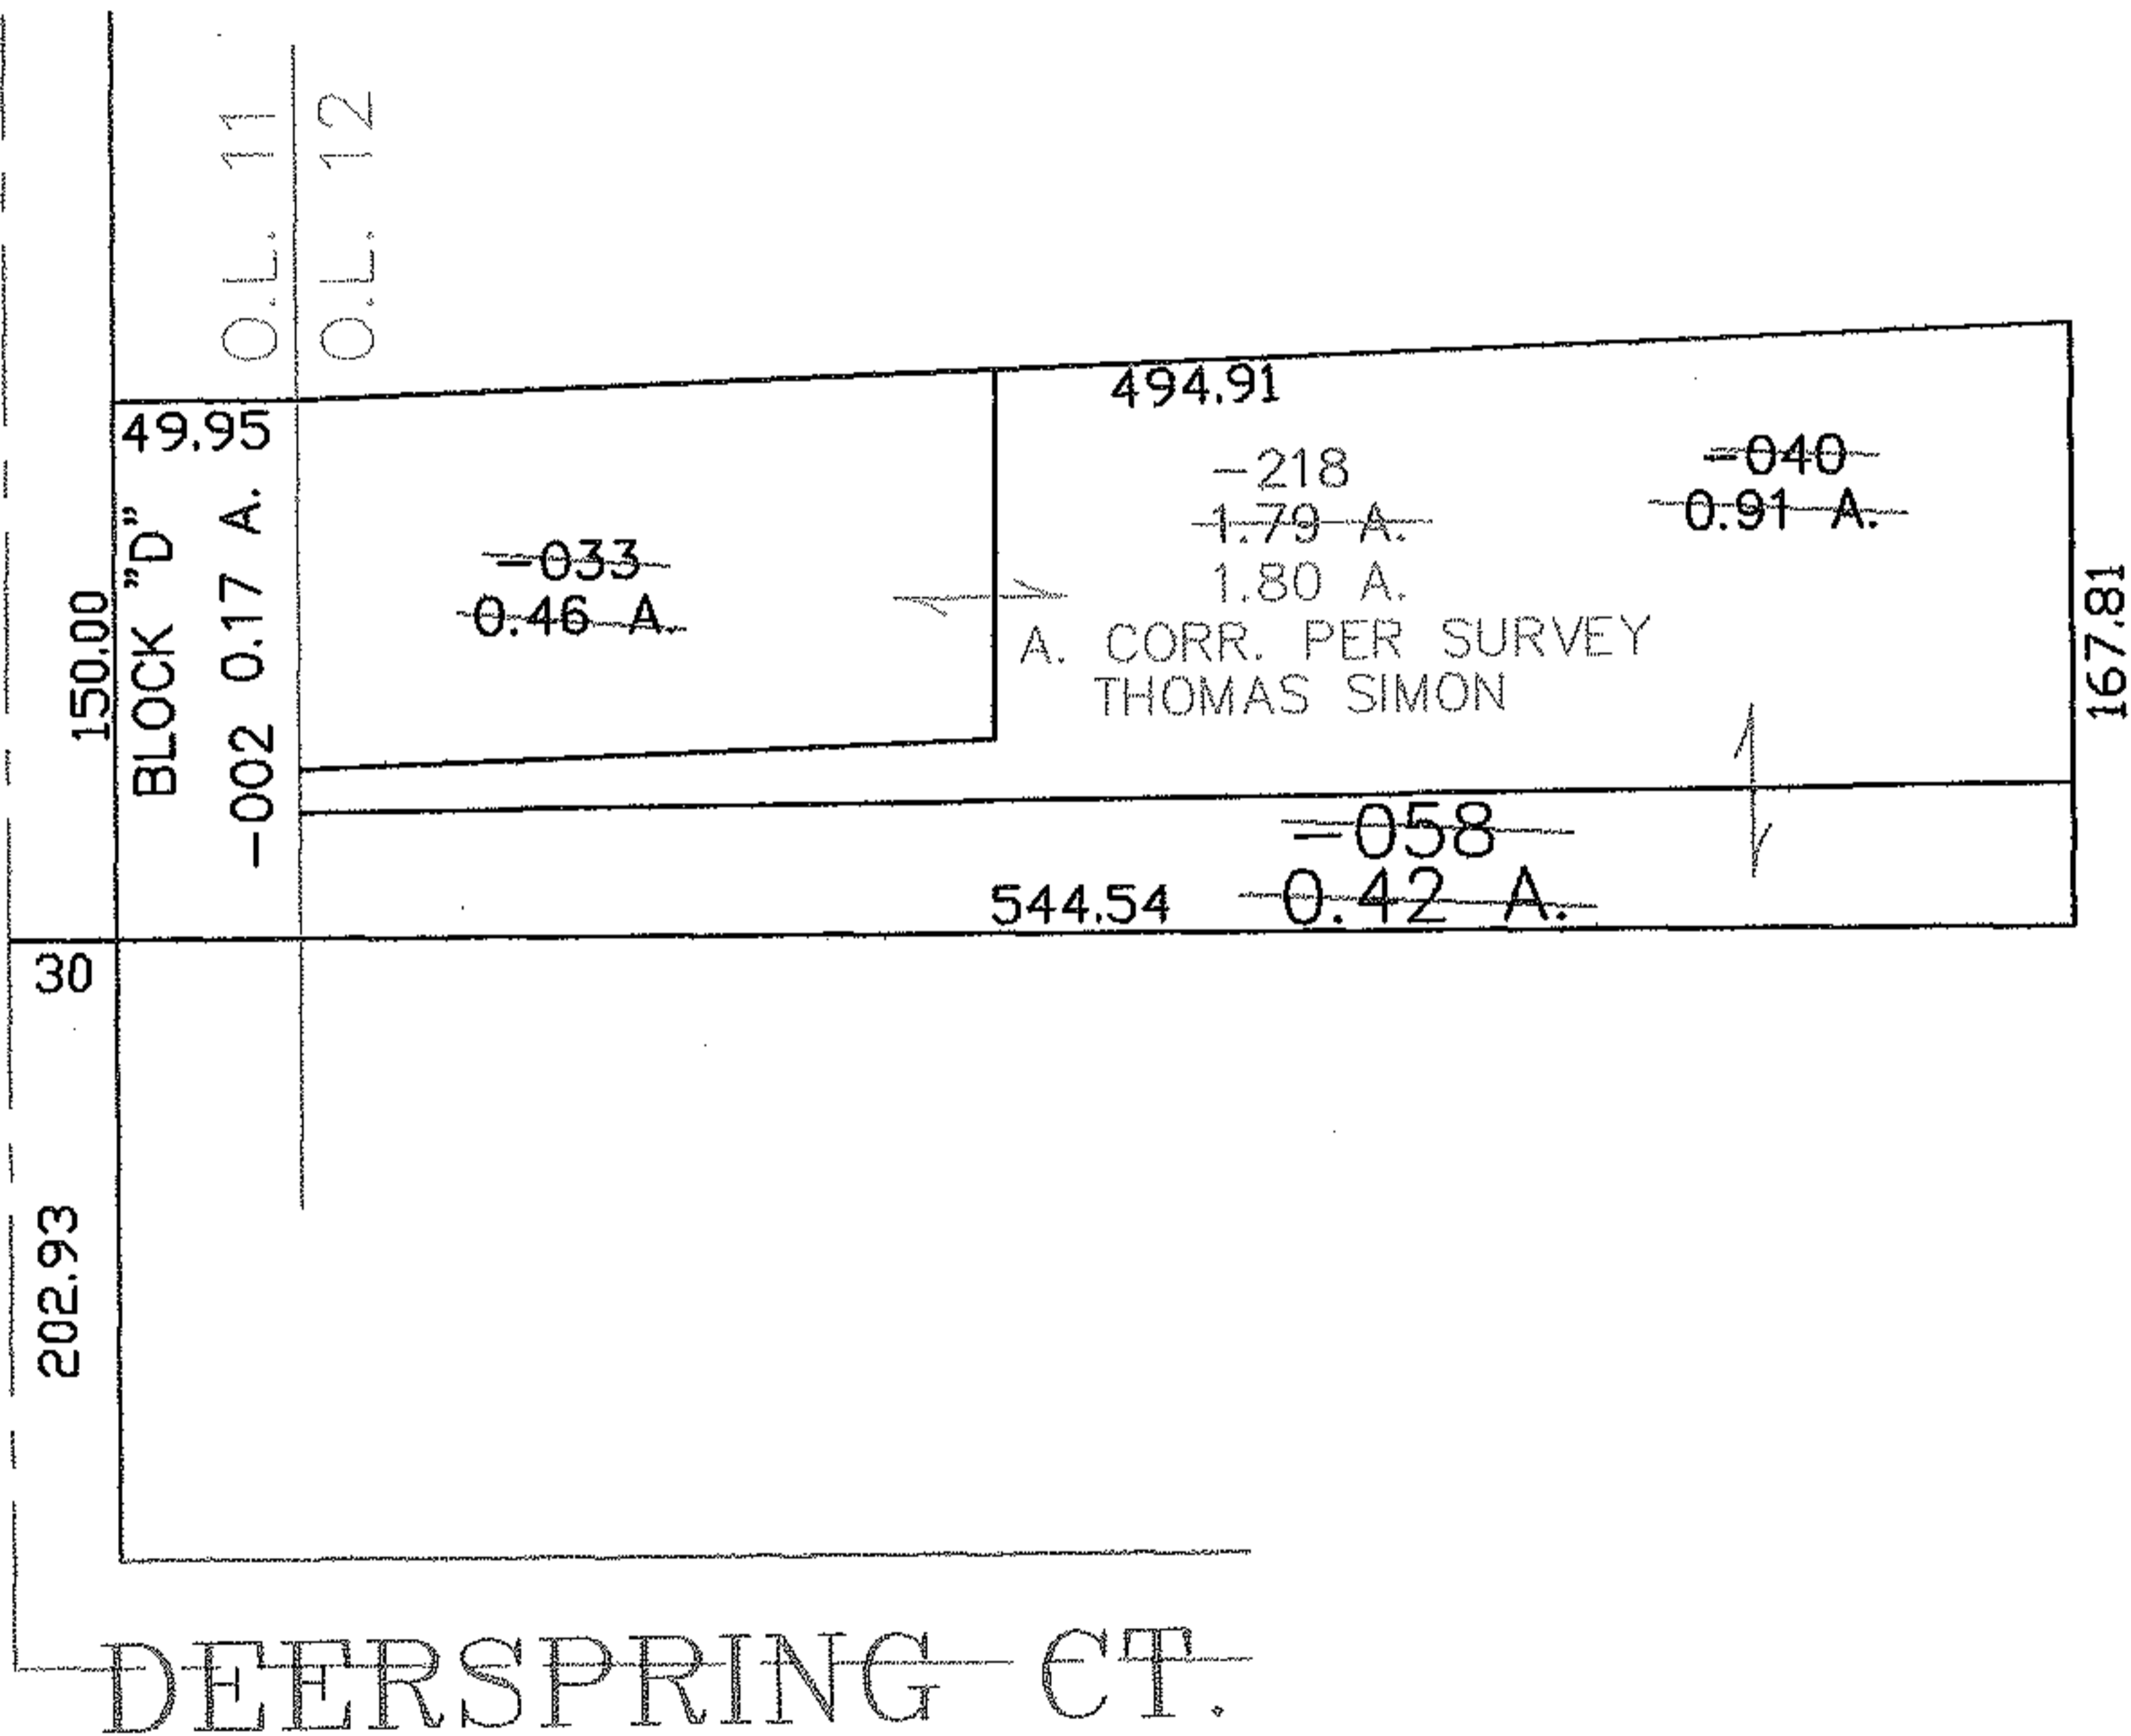

SPLITS/DEEDS PROCESSED

LORAIN COUNTY TAX MAP DEPARTMENT  
226 MIDDLE AVE. ELYRIA, OHIO

SURVEYED BY: THOMAS SIMON

CLOSURE: 0.00 : 10.000

MAP PAGE(S): 07-00-002-C

APPROVED BY: JAH DATE: 11-23-04

SCALE: 1" = 100 PRIOR INSTRUMENT: 20040027376