
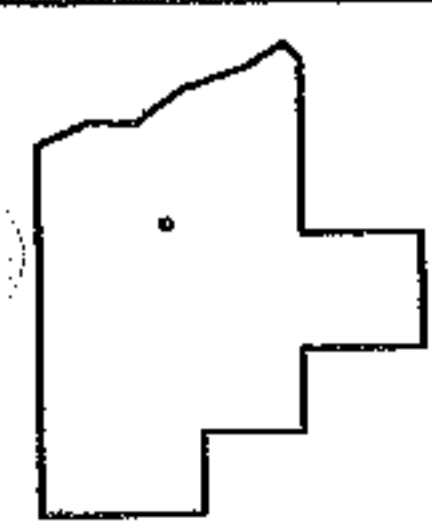
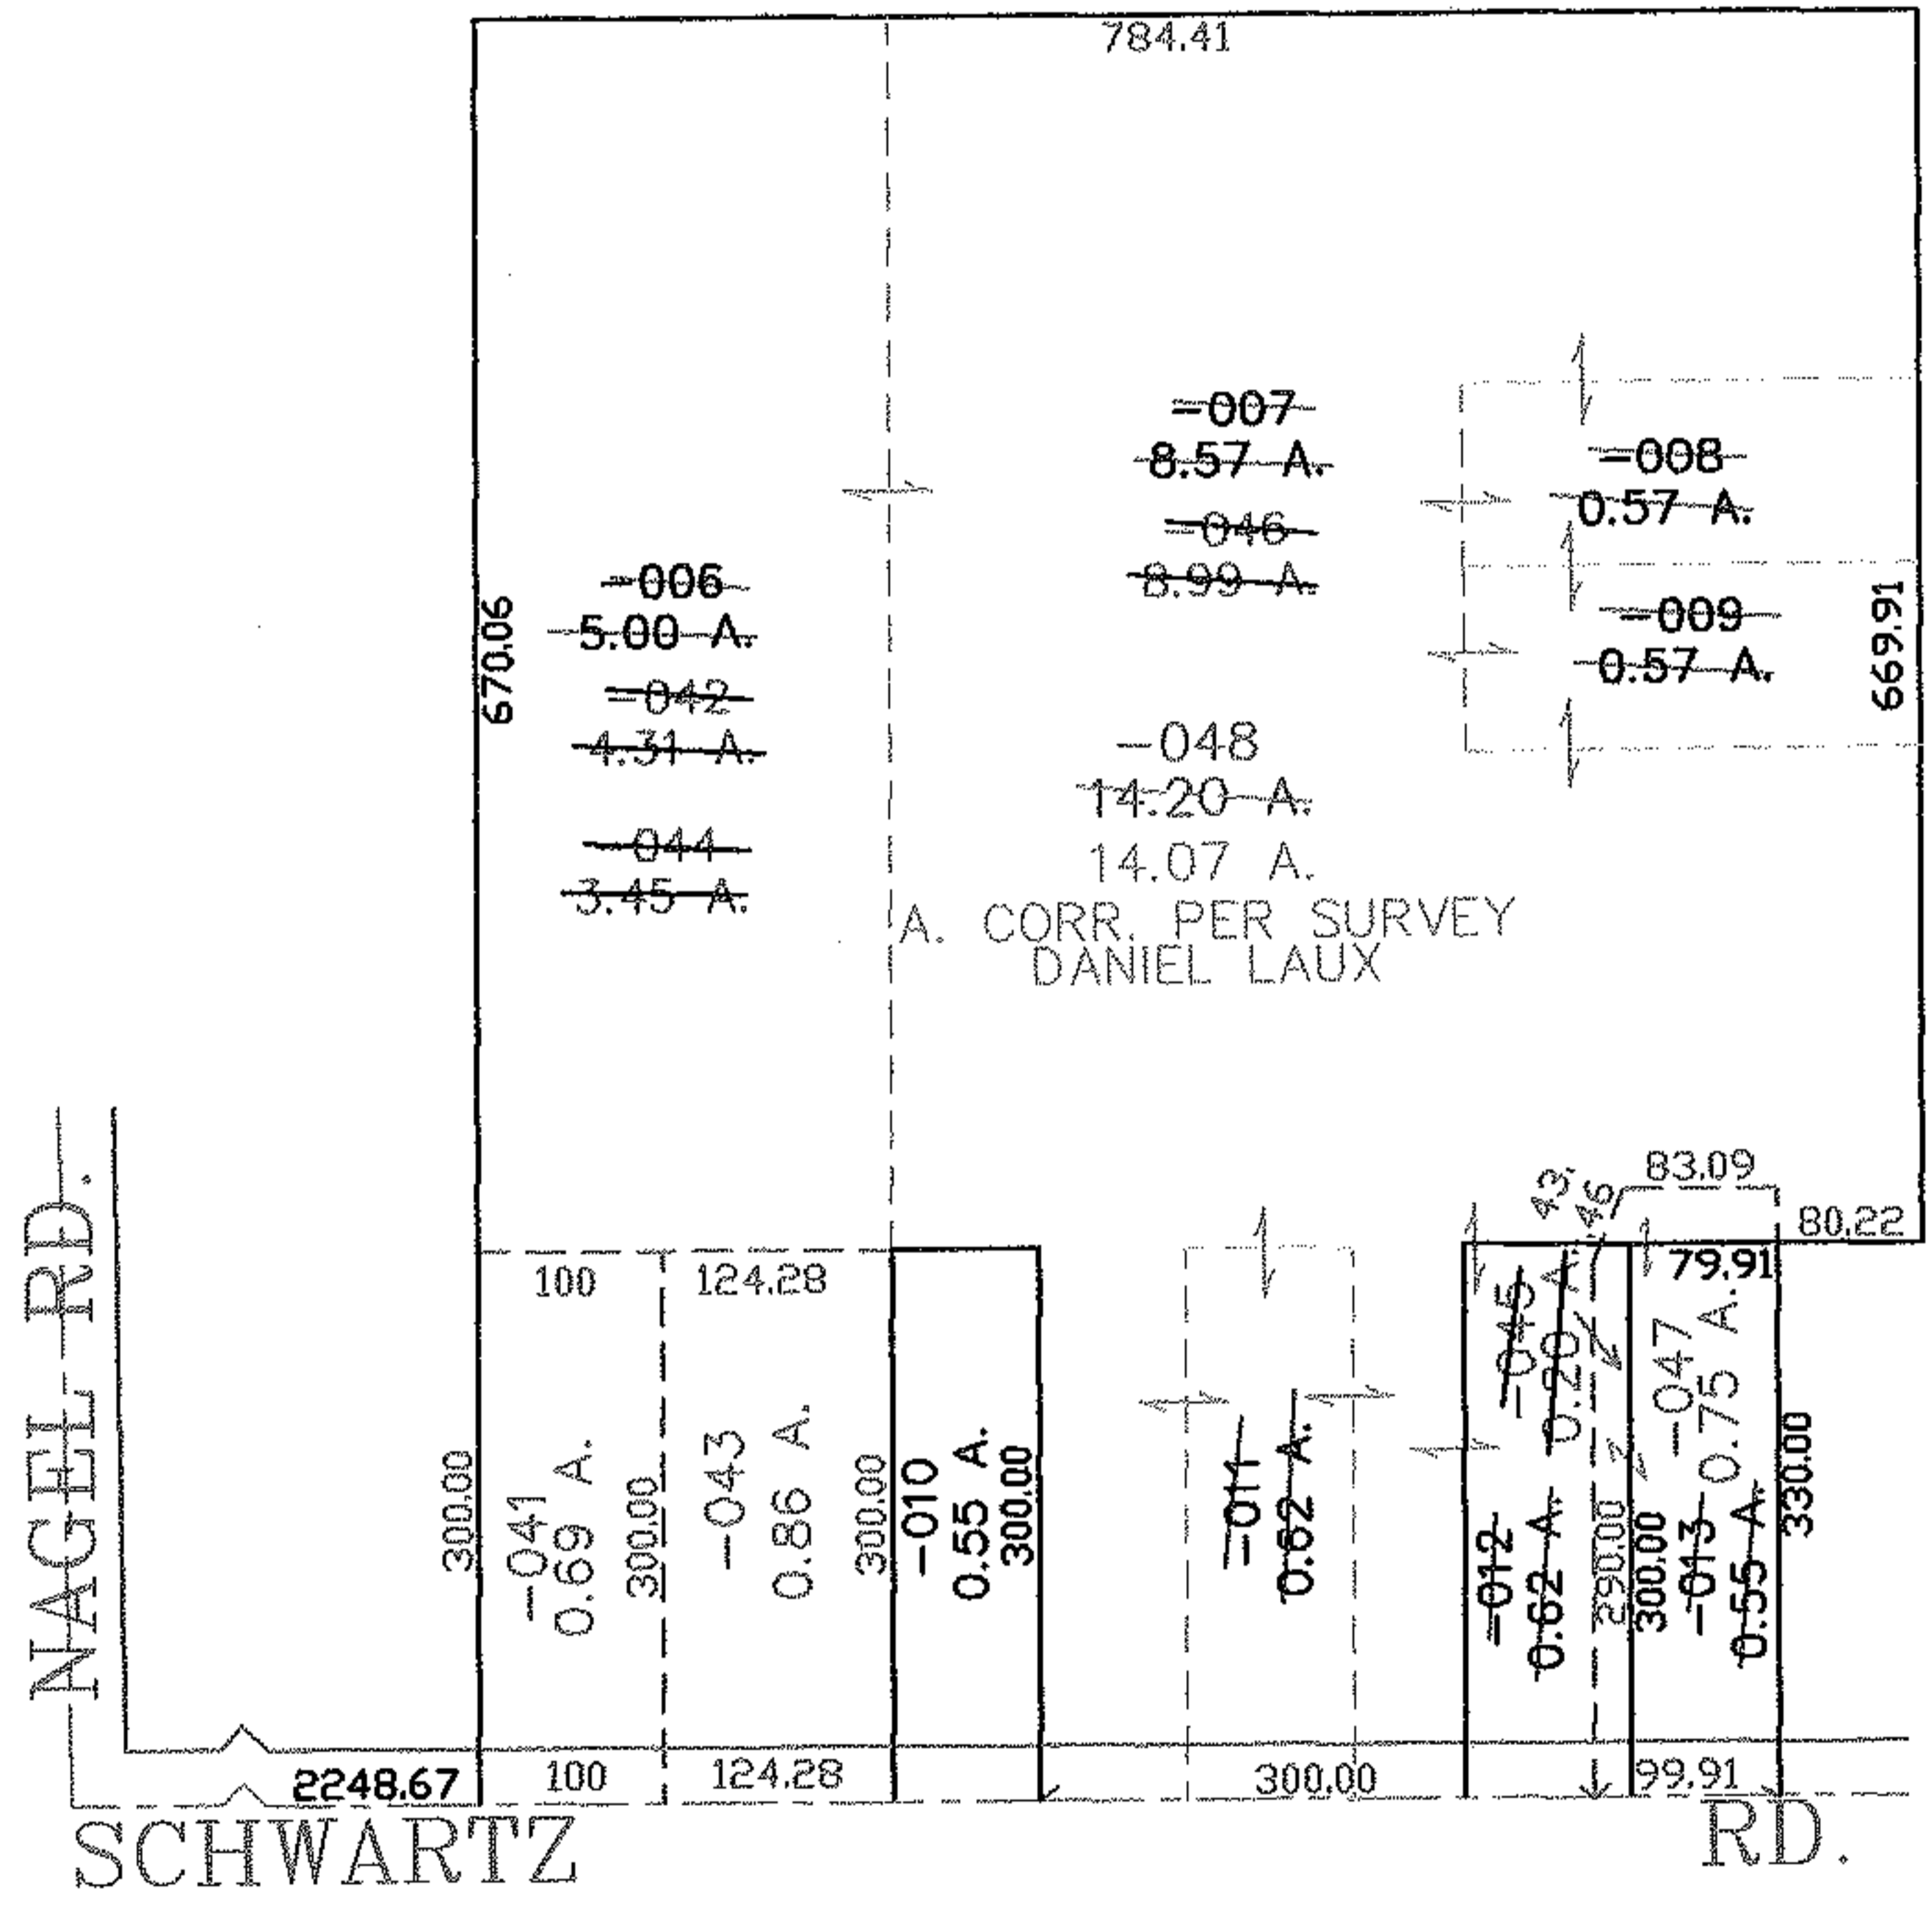


RASTER

PARENT PARCEL: 04-00-026-108-006, -007, -008, -009, -011, -012, -013
CHILD PARCEL: 04-00-026-108-041 THRU -048
STARTING POINT: CENTERLINE OF NAGEL RD. & SCHWARTZ RD.

NO. 01798

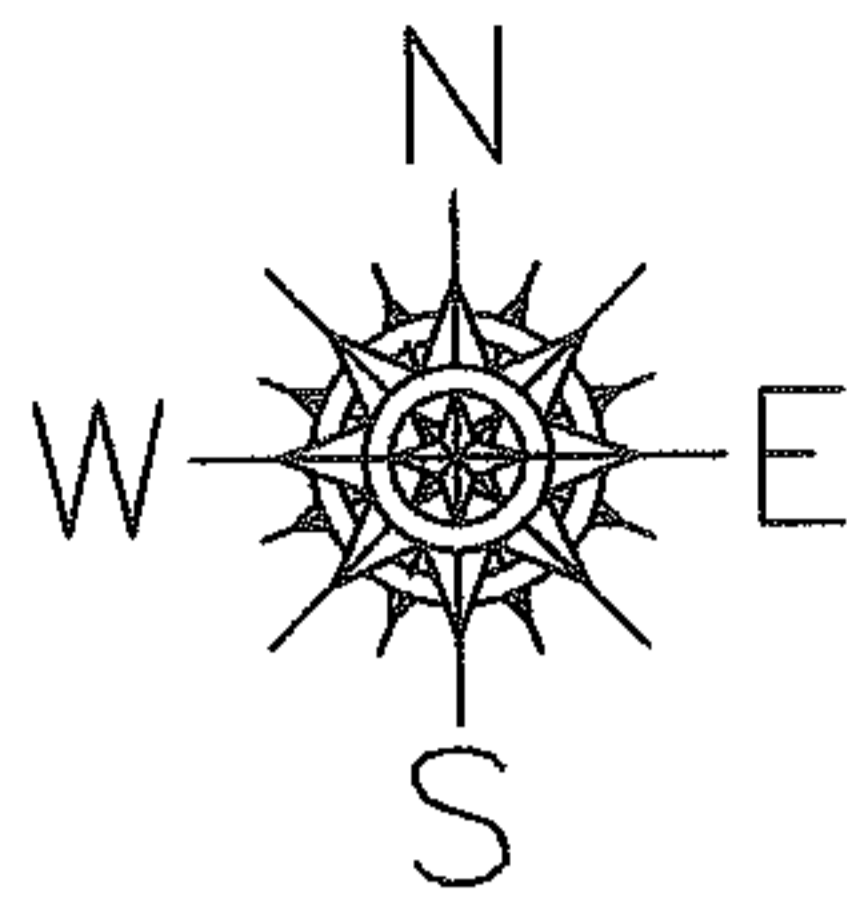

SPLITS/DEEDS PROCESSED
LORAIN COUNTY TAX MAP DEPARTMENT
226 MIDDLE AVE. ELYRIA, OHIO

SURVEYED BY: DANIEL LAUX
CLOSURE: 0.00 : 10.000
MAP PAGE(S): 04-00-026-B
APPROVED BY: JAH DATE: 11-30-04
SCALE: 1" = 200 PRIOR INSTRUMENT: 20040015807