
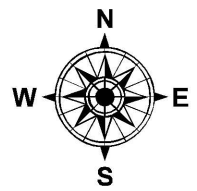


PARENT PARCEL: 03-00-043-109-036


CHILD PARCEL: 03-00-043-109-045, -046

STARTING POINT: S/L'S 229 & 230 IN LAKEWOOD BEACH SUB.

18-04000-U

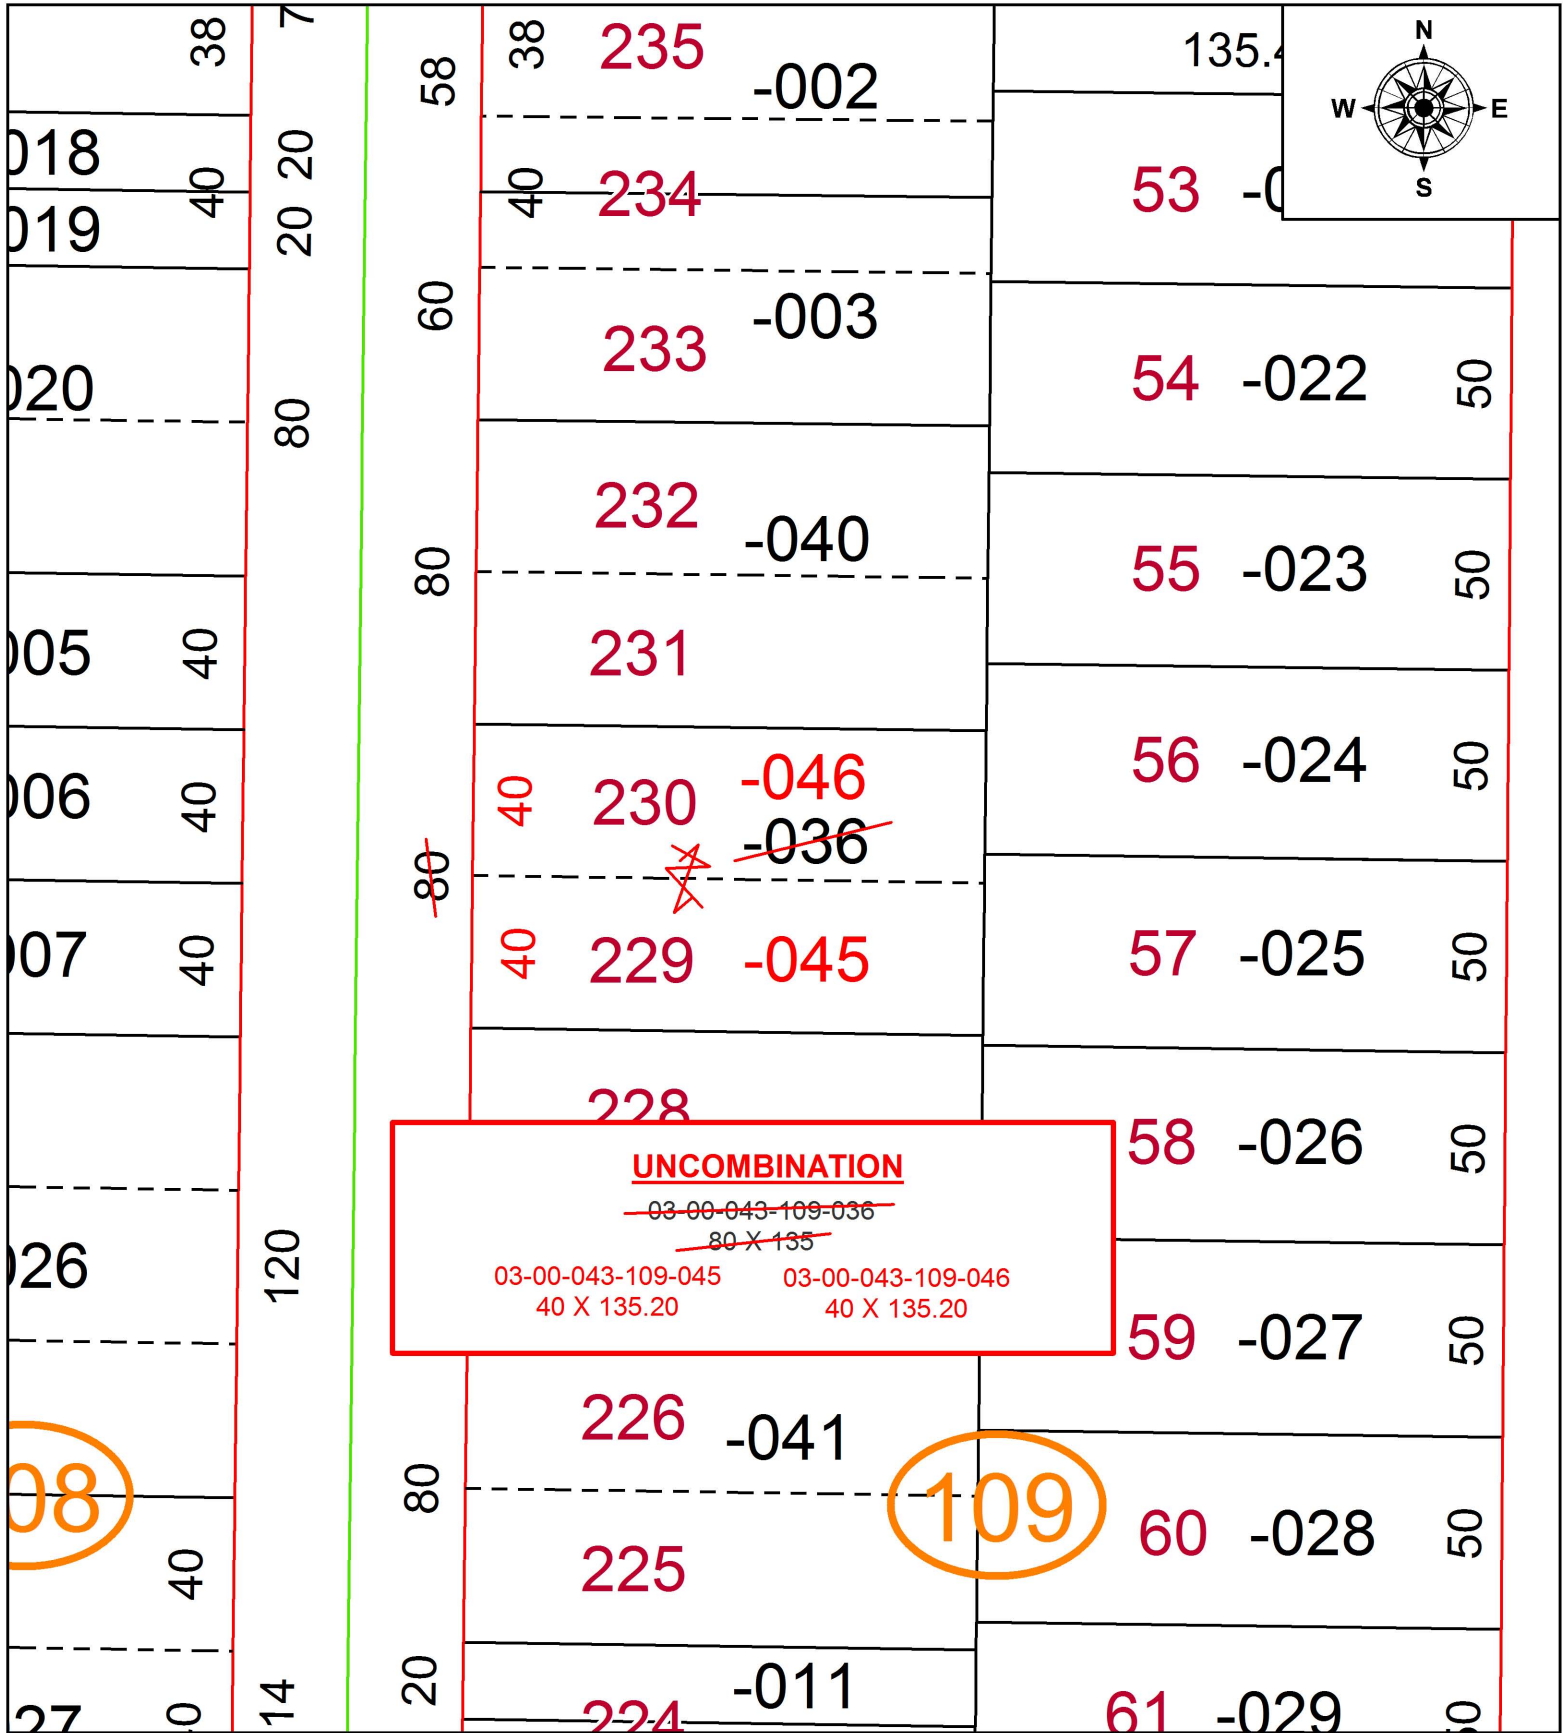

**UNCOMBINATION**  
~~03-00-043-109-036~~  
~~80 X 135~~  
 03-00-043-109-045      03-00-043-109-046  
 40 X 135.20              40 X 135.20

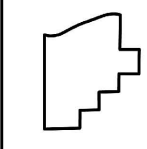

**SPLITS/DEEDS PROCESSED**  
 LORAIN COUNTY TAX MAP DEPARTMENT  
 226 MIDDLE AVE. ELYRIA, OH

SURVEYED BY: N/A  
 CLOSURE: N/A  
 MAP PAGE(S): 3-00-043  
 APPROVED BY: RRM      DATE: 12-13-18  
 SCALE: 1" = 50'      PRIOR INSTRUMENT: 20070223604