


PARENT PARCEL: 06-25-085-101-007, -021


CHILD PARCEL:

STARTING POINT: NORTHEAST CORNER OF S/L 6 IN PINEWOOD SUB.

18-04002-C

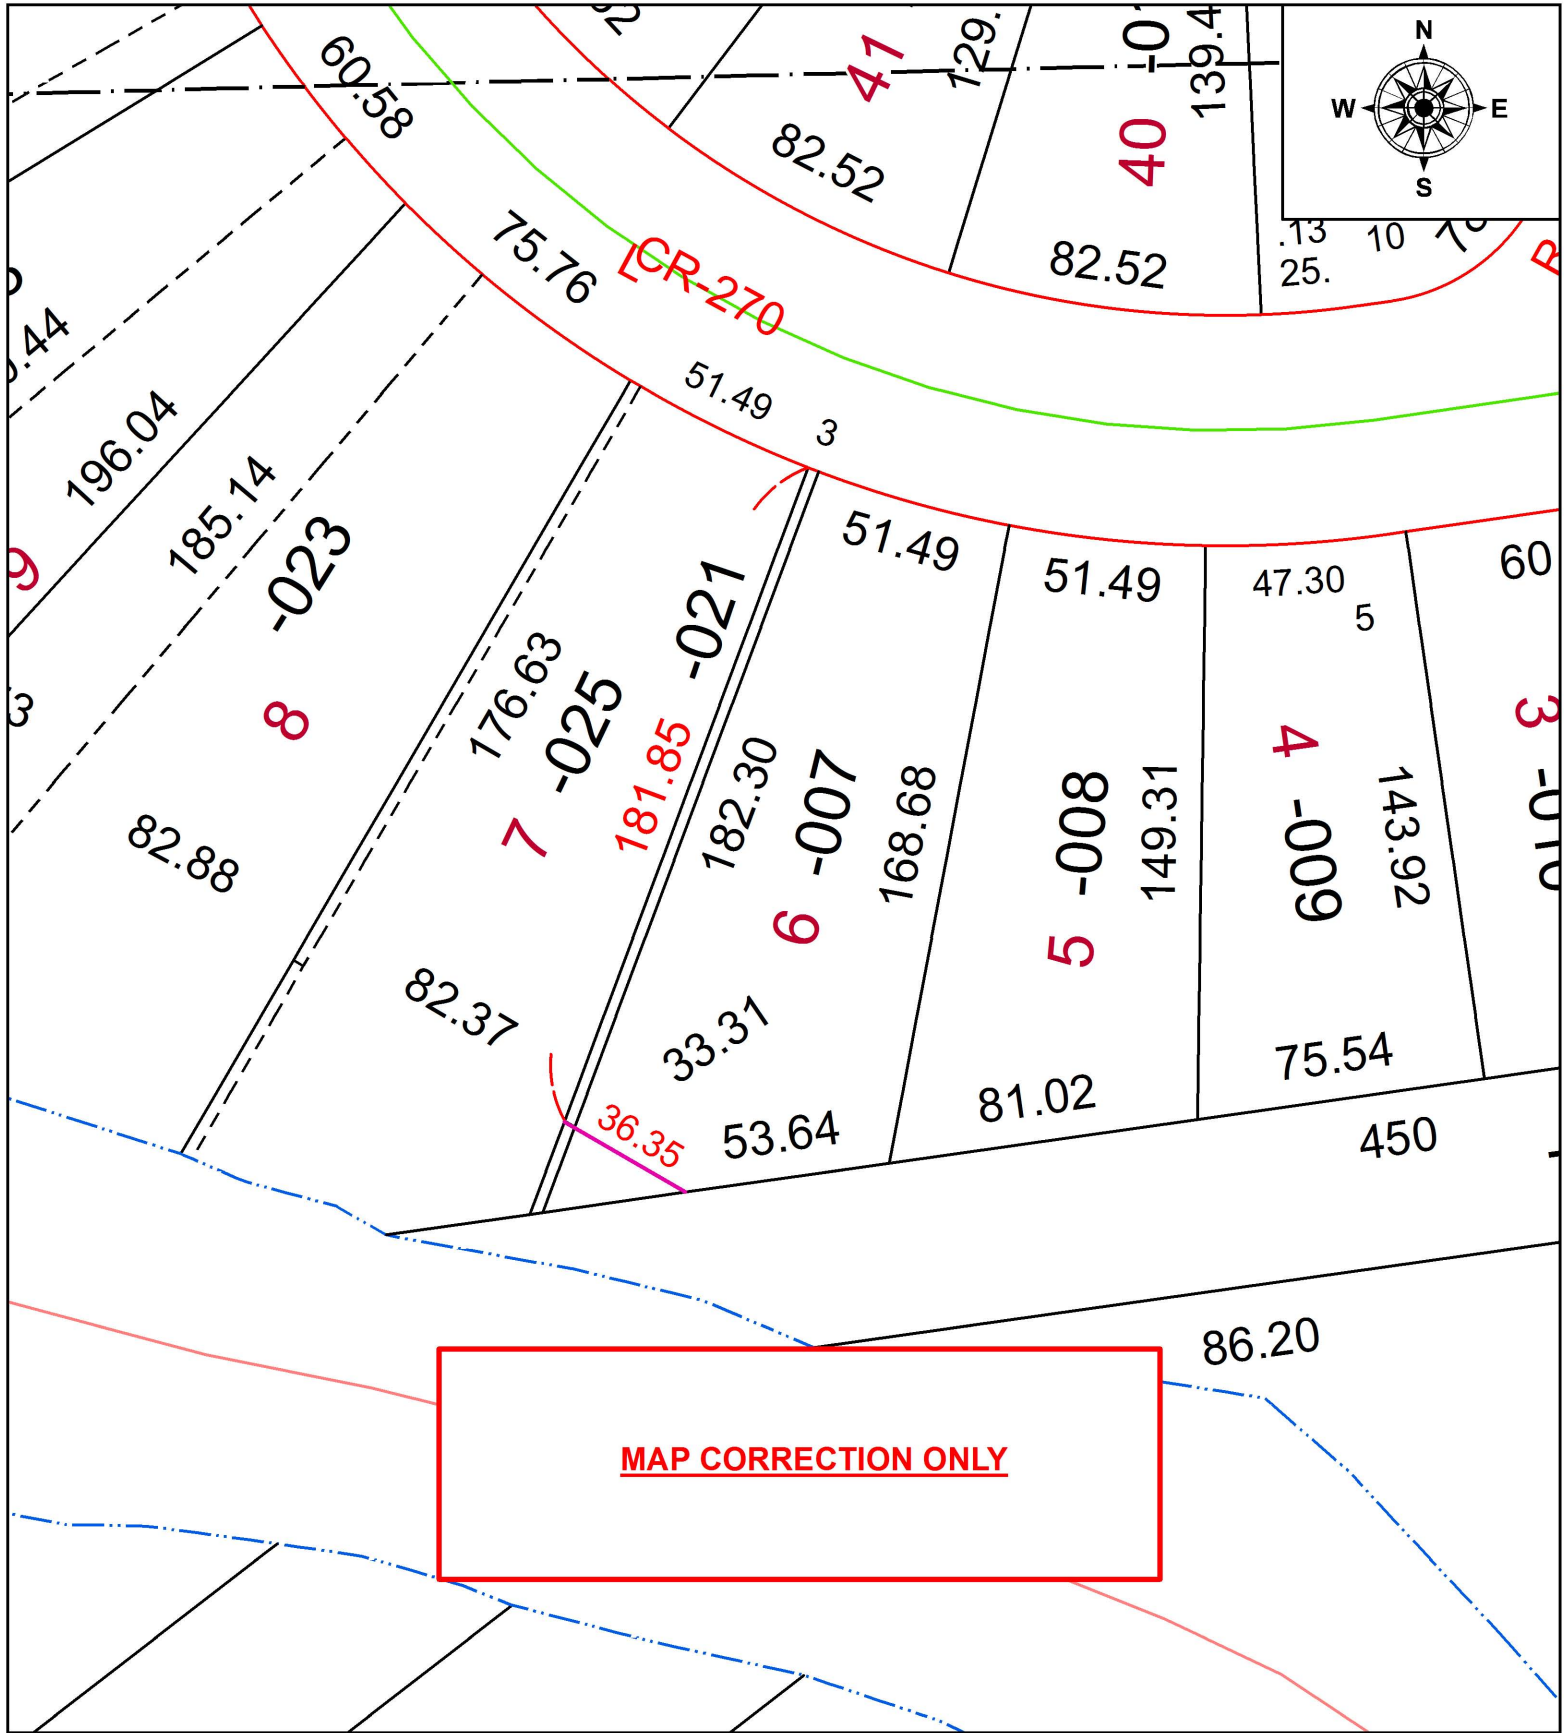

MAP CORRECTION ONLY

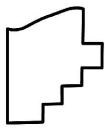

SPLITS/DEEDS PROCESSED
LORAIN COUNTY TAX MAP DEPARTMENT
226 MIDDLE AVE. ELYRIA, OH

SURVEYED BY:	JAMES RESAR		
CLOSURE:	1:39,789		
MAP PAGE(S):	6-138		
APPROVED BY:	RRM	DATE:	12-20-18
SCALE:	1" = 50'	PRIOR INSTRUMENT:	20160573797