


PARENT PARCEL: 16-00-080-000-024, -025

CHILD PARCEL: 16-00-080-000-028 THRU -030

STARTING POINT: INTERSECTION OF C/L OF CHAMBERLAIN RD. AND C/L OF LAW RD.

19-04005

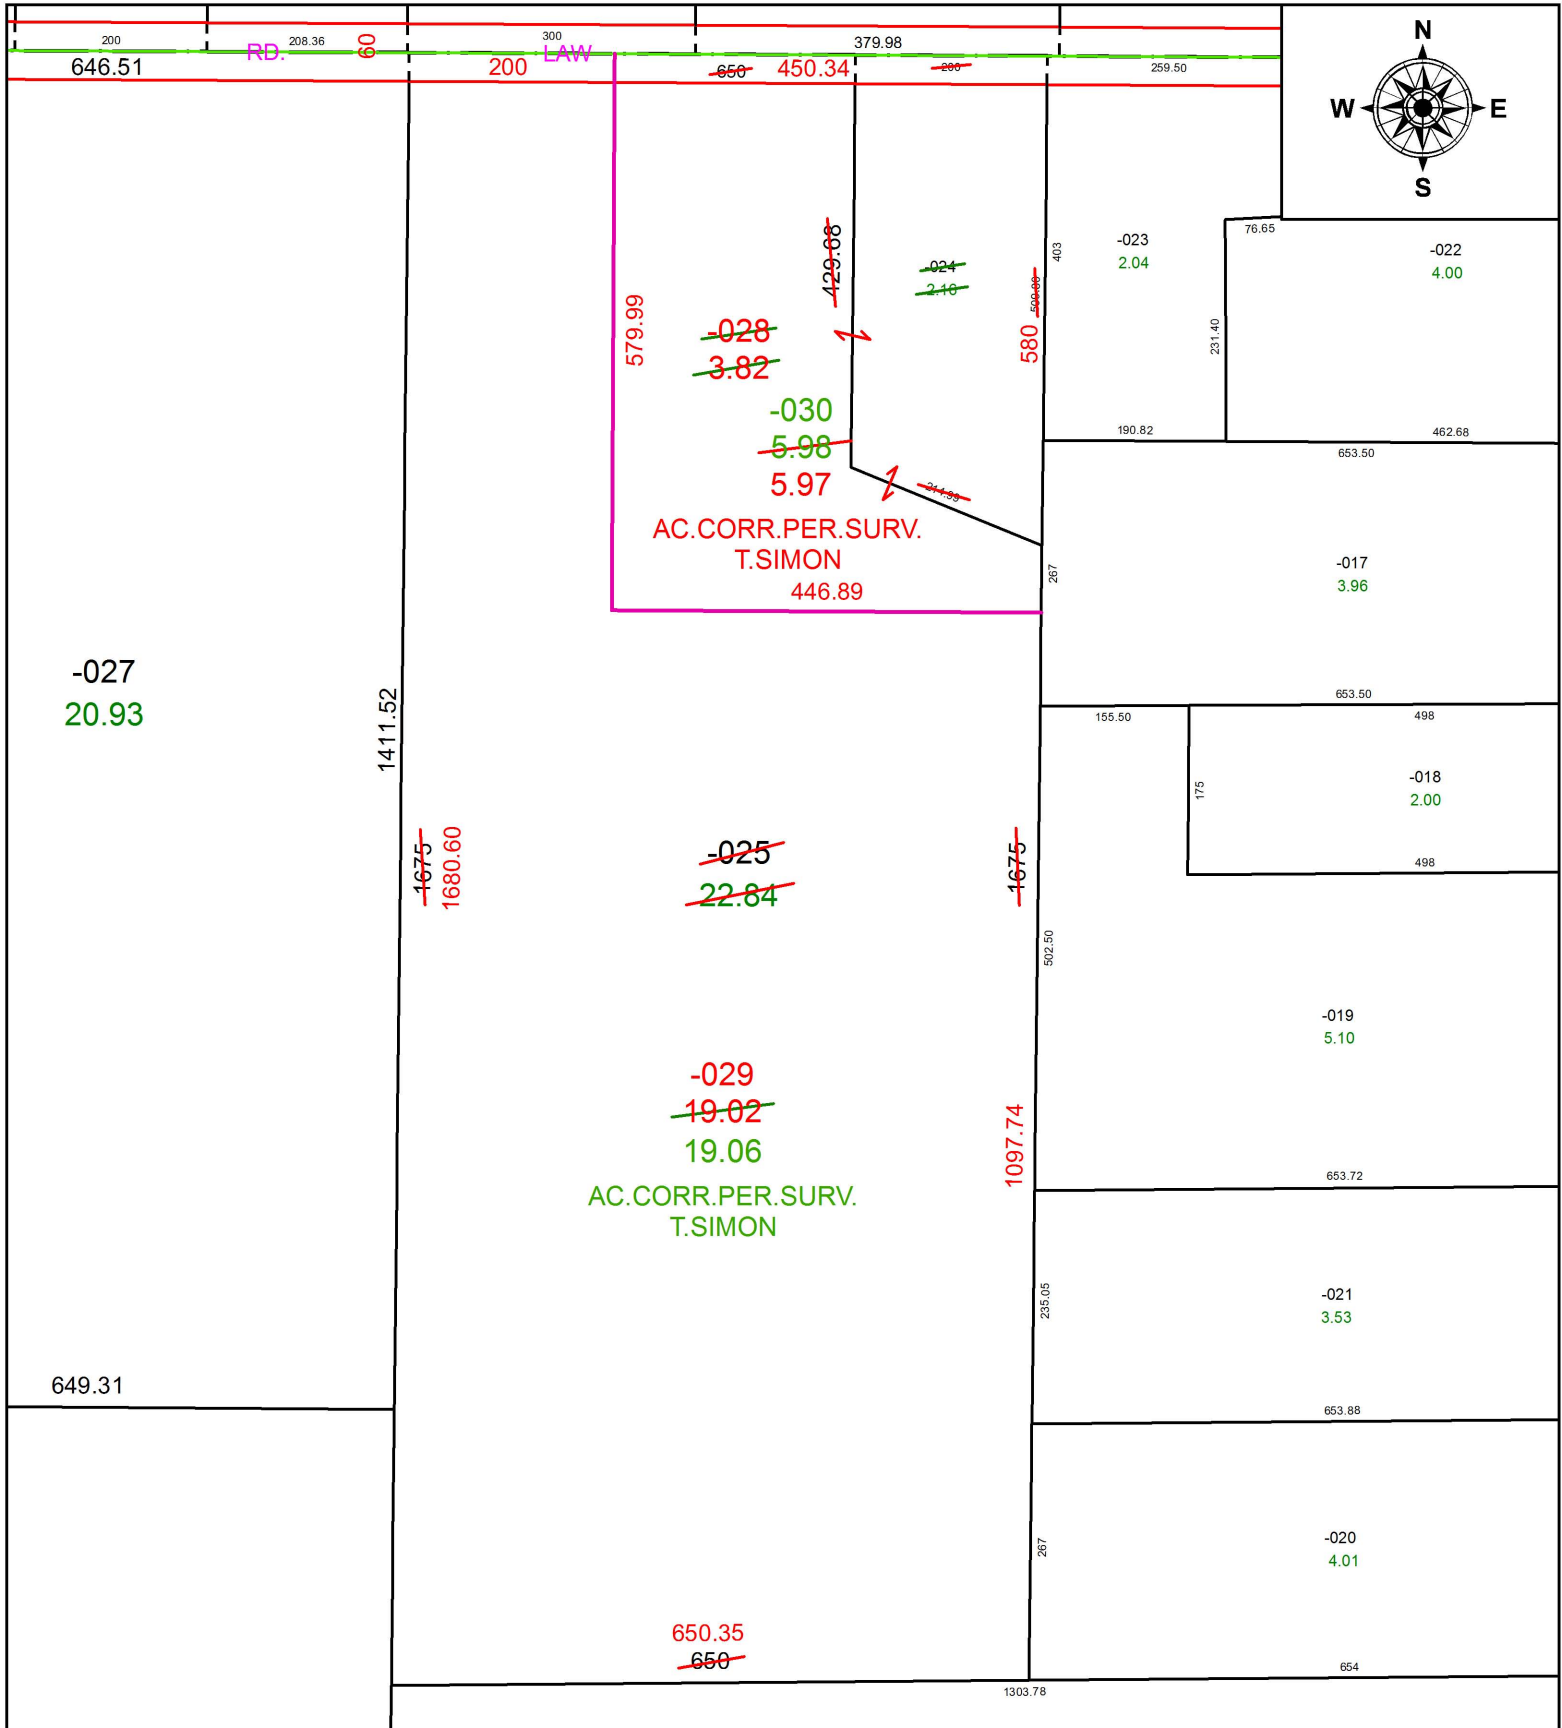

-027  
20.93

1411.52

~~1675~~  
1680.60

~~-025~~  
22.84

~~-029~~  
19.02  
19.06

AC. CORR. PER. SURV.  
T. SIMON

650.35  
~~650~~

1097.74

502.50

267

1303.78

403

580

267

267

267

155.50

1675

502.50

1097.74

235.05

267

267

403

580

267

267

267

155.50

1675

502.50

1097.74

235.05

267

267

403

580

267

267

267

155.50

1675

502.50

1097.74

235.05

267

267

403

580

267

267

267

155.50

1675

502.50

1097.74

235.05

267

267

403

580

267

267

267

155.50

1675

502.50

1097.74

235.05

267

267

403

580

267

267

267

155.50

1675

502.50

1097.74

235.05

267

267


267

267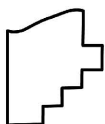

**SPLITS/DEEDS PROCESSED**  
LORAIN COUNTY TAX MAP DEPARTMENT  
226 MIDDLE AVE. ELYRIA, OH

SURVEYED BY: THOMAS A. SIMON

CLOSURE: 1:327,476

MAP PAGE(S): 16-00-080

APPROVED BY: RRM DATE: 8-8-19

SCALE: 1" = 200 PRIOR INSTRUMENT: 20150547820